


VICINITY MAP

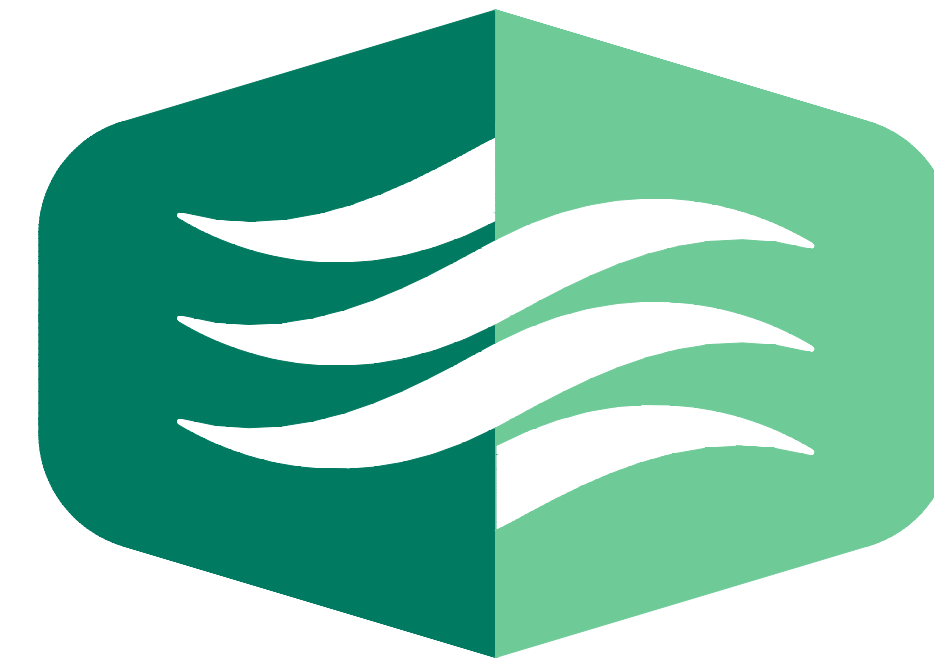


**THOMPSON  
& LITTON**

EST. 1956

103 East Main Street  
P.O. Box 1307  
Wise, Virginia 24293

P: (276) 328-2161  
F: (276) 328-1738

www.T-L.com

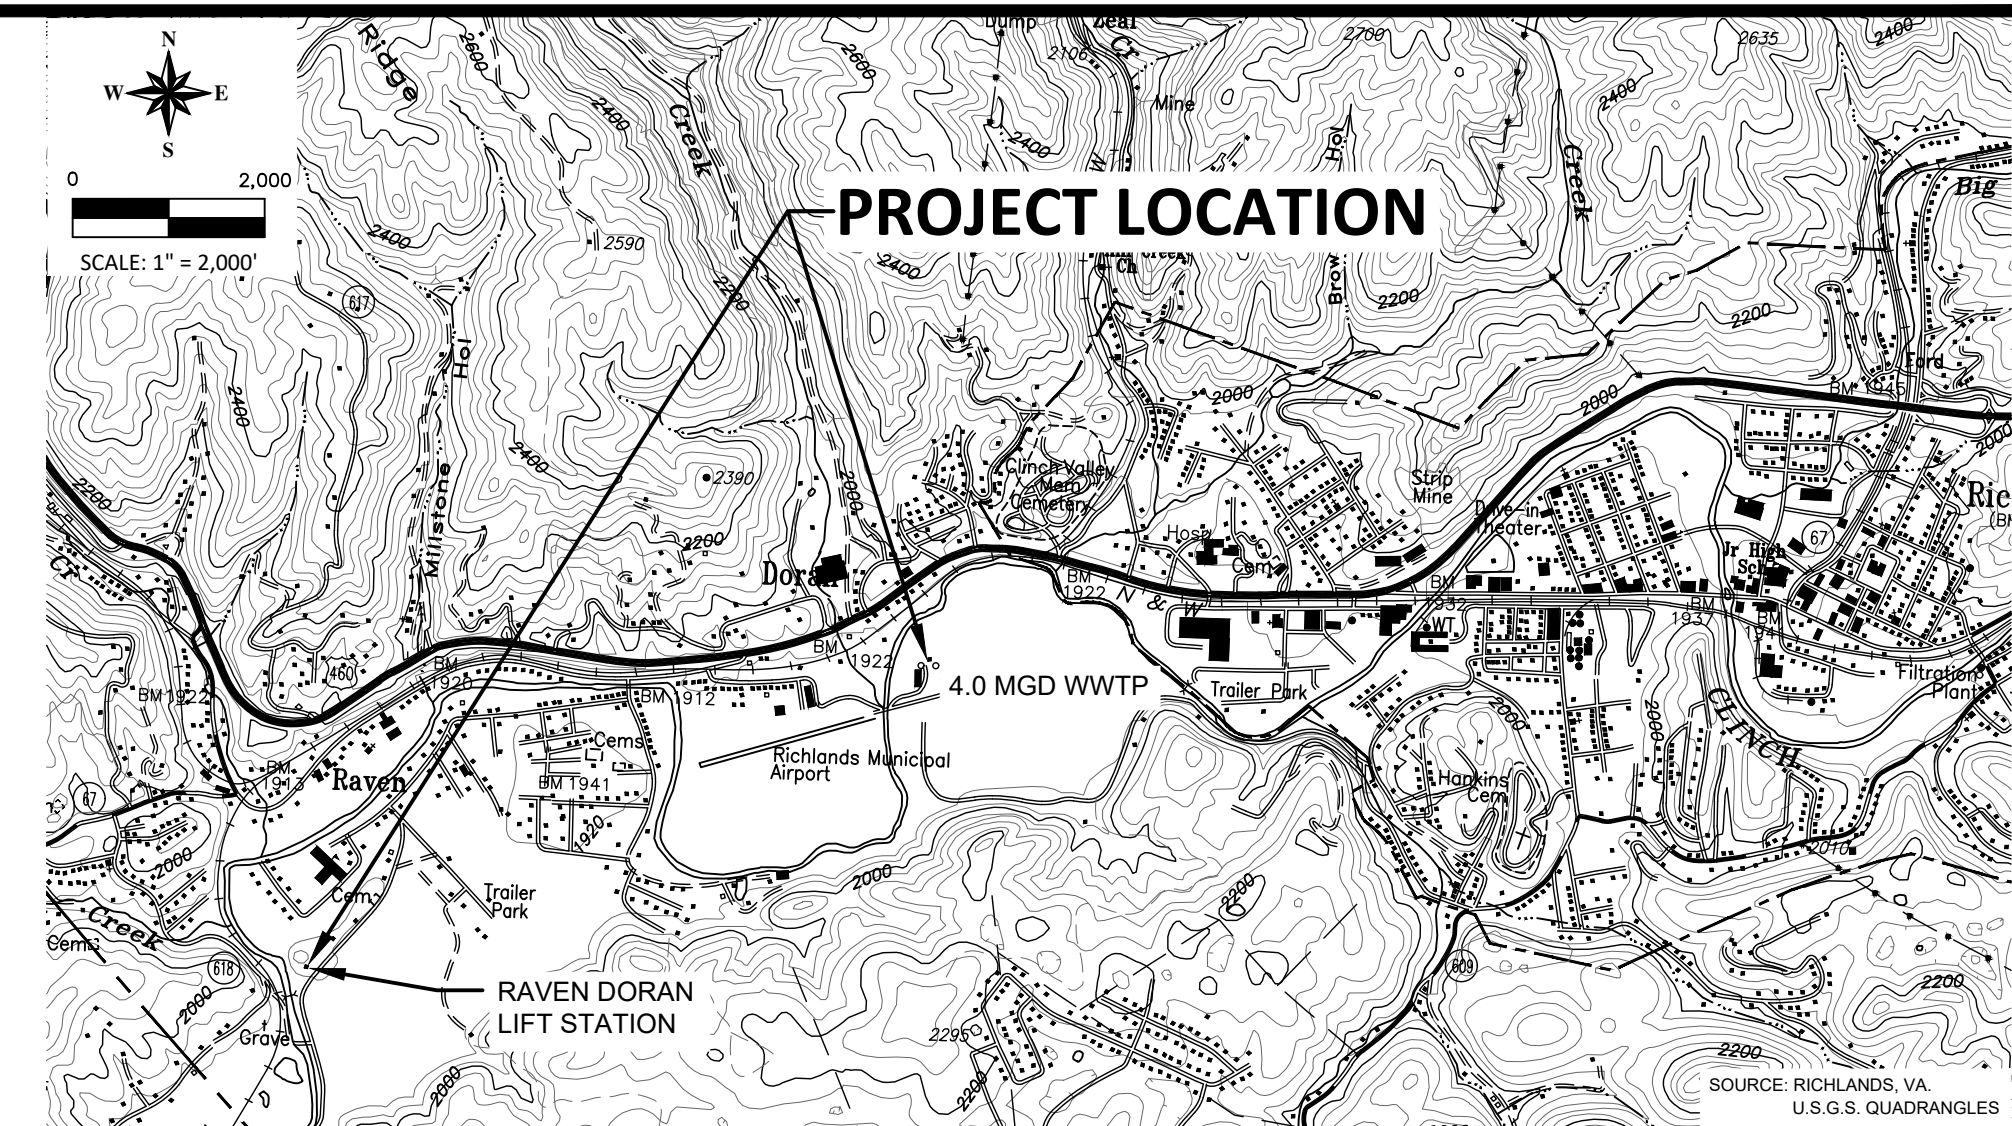

LOCATION MAP

# TOWN OF RICHLANDS - 4.0 MGD WWTP UPGRADES AND IMPROVEMENTS

WITH FINANCIAL ASSISTANCE FROM  
VIRGINIA CLEAN WATER REVOLVING LOAN FUND  
PROJECT NO. C-515667




TOWN OF RICHLANDS, VIRGINIA  
200 WASHINGTON SQUARE  
RICHLANDS, VIRGINIA 24641  
(276) 964-2566



ISSUED FOR BIDS

PROJECT NO. 14249  
January 7, 2022

**McGill Associates Note:**  
Project scope has been reduced from original design. Out-of-scope plan sheets and items have been removed or crossed out in red to reflect the current project scope.

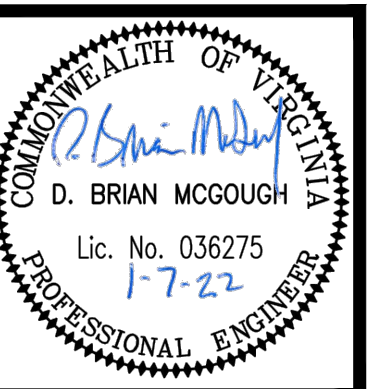

TOWN OF RICHLANDS - 4.0 MGD WWTP  
UPGRADES AND IMPROVEMENTS

TITLE SHEET

No.	Date	Purpose of Document Issue
	03-31-21	ISSUED FOR DEQ REVIEW
	04-15-21	ISSUED FOR TOWN REVIEW
	06-21-21	ISSUED FOR DEQ REVIEW
	01-07-22	ISSUED FOR BIDS

Designed	DBM
Drawn	ESB
Checked	
Date	JULY 2020

Project No.	14249
-------------	-------



Sheet No.	T001
-----------	------



SHEET INDEX


GENERAL DRAWINGS		
T001		COVER SHEET
G001		SHEET INDEX, GENERAL & CIVIL NOTES & ABBREVIATIONS
CIVIL DRAWINGS		
C001		EROSION & SEDIMENT CONTROL DETAILS
C002		EROSION & SEDIMENT CONTROL DETAILS
C003		MISCELLANEOUS DETAILS
C004		MISCELLANEOUS DETAILS
C005		MAJOR EQUIPMENT SCHEDULES
C006		VALVE SCHEDULES
C101		SITE SURVEY
C102		SITE DEMOLITION AND EROSION & SEDIMENT CONTROL PLAN PHASE 1
<del>C103</del>		<del>SITE PLAN</del>
<del>C104</del>		<del>EROSION &amp; SEDIMENT CONTROL PLAN PHASE 2</del>
<del>C201</del>		<del>MAIN PUMP STATION DEMOLITION PLAN</del>
C202		PRELIMINARY TREATMENT BUILDING DEMOLITION PLAN
<del>C203</del>		<del>AERATION BASIN DEMOLITION PLAN</del>
<del>C304</del>		<del>UV AND EFFLUENT SYSTEMS DEMOLITION PLAN</del>
<del>C305</del>		<del>ANAEROBIC DIGESTERS ROOF DEMOLITION PLAN</del>
<del>C306</del>		<del>ANAEROBIC DIGESTERS UPPER LEVEL DEMOLITION PLAN</del>
<del>C307</del>		<del>ANAEROBIC DIGESTERS LOWER LEVEL DEMOLITION PLAN</del>
<del>C308</del>		<del>ANAEROBIC DIGESTERS DEMOLITION SECTIONS</del>
C209		SHOP BUILDING EQUIPMENT DEMOLITION PLAN
<del>C310</del>		<del>RAVEN DORAN LIFT STATION DEMOLITION PLAN</del>
<del>C301</del>		<del>MAIN PUMP STATION RENOVATION PLAN</del>
<del>C303</del>		<del>MAIN PUMP STATION SECTIONS</del>
<del>C303</del>		<del>RAVEN DORAN LIFT STATION RENOVATION &amp; ADDITION PLAN</del>
<del>C304</del>		<del>RAVEN DORAN LIFT STATION SECTIONS</del>
C401		PRELIMINARY TREATMENT BUILDING RENOVATION PLAN
C402		PRELIMINARY TREATMENT BUILDING SECTIONS
<del>C403</del>		<del>SEPTAGE RECEIVING STATION PLAN AND SECTIONS</del>
C501		PRIMARY CLARIFIERS RENOVATION PLAN
C502		PRIMARY CLARIFIERS SECTIONS
C503		SECONDARY CLARIFIERS RENOVATION PLAN
C504		SECONDARY CLARIFIERS PLAN AT PUMP LEVEL & SECTIONS
<del>C505</del>		<del>GRAVITY THICKENER RENOVATION PLAN &amp; SECTION</del>
<del>C601</del>		<del>AERATION BASIN RENOVATION PLAN</del>
<del>C602</del>		<del>AERATION BASIN SECTIONS</del>
<del>C701</del>		<del>UV AND EFFLUENT SYSTEMS RENOVATION PLAN</del>
<del>C702</del>		<del>UV AND EFFLUENT SECTIONS</del>
C801		SHOP BUILDING RENOVATION PLAN
C802		SHOP BUILDING SECTIONS
<del>C803</del>		<del>ANAEROBIC DIGESTERS ROOF RENOVATION PLAN</del>
<del>C804</del>		<del>ANAEROBIC DIGESTERS UPPER LEVEL RENOVATION PLAN</del>
<del>C805</del>		<del>ANAEROBIC DIGESTERS LOWER LEVEL RENOVATION PLAN</del>
<del>C806</del>		<del>ANAEROBIC DIGESTER RENOVATION SECTIONS</del>
ARCHITECTURAL DRAWINGS		
A201		NEW PRELIMINARY TREATMENT BUILDING EXTERIOR ELEVATIONS
STRUCTURAL DRAWINGS		
S001		GENERAL NOTES AND DESIGN CRITERIA
<del>S101</del>		<del>MAIN PUMP STATION PLANS</del>
S102		EXISTING PRELIMINARY TREATMENT BUILDING PLAN
S300		SECTIONS AND DETAILS

MECHANICAL DRAWINGS		
M001		MECHANICAL LEGEND, ABBREVIATIONS, AND GENERAL NOTES
<del>M101</del>		<del>UPPER AND LOWER LEVEL HVAC PLAN - MAIN PUMP STATION</del>
<del>M102</del>		<del>ELEVATION HVAC PLAN - MAIN PUMP STATION</del>
M103		LOWER AND UPPER HVAC PLAN - PRETREATMENT BUILDING
ELECTRICAL DRAWINGS		
E001		ELECTRICAL LEGEND, ABBREVIATIONS, AND GENERAL NOTES
E51		ELECTRICAL SITE PLAN
<del>E101</del>		<del>UPPER AND LOWER LEVEL LIGHTING PLAN - MAIN PUMP STATION</del>
E102		LOWER AND UPPER LIGHTING PLAN - PRETREATMENT BUILDING
<del>E201</del>		<del>UPPER AND LOWER LEVEL POWER PLAN - MAIN PUMP STATION</del>
E202		LOWER AND UPPER POWER PLAN - PRETREATMENT BUILDING
E203		POWER PLAN - PRIMARY CLARIFIERS
E204		POWER PLAN - SECONDARY CLARIFIERS
<del>E205</del>		<del>POWER PLAN - AERATION BASIN</del>
<del>E206</del>		<del>POWER PLAN - UV AND EFFLUENT SYSTEMS BUILDING</del>
<del>E207</del>		<del>NOT USED</del>
<del>E300</del>		<del>POWER PLAN - ANAEROBIC DIGESTERS UPPER LEVEL</del>
<del>E300</del>		<del>POWER PLAN - ANAEROBIC DIGESTERS LOWER LEVEL</del>
E210		POWER PLAN - SHOP BUILDING
<del>E211</del>		<del>POWER PLAN - RAVEN DORAN PUMP STATION</del>
<del>E312</del>		<del>POWER PLAN - GRAVITY THICKENER</del>
E501		ELECTRICAL DETAILS
E601		EXISTING ELECTRICAL ONE-LINE DIAGRAM
E701		ELECTRICAL SCHEDULES
E702		ELECTRICAL SCHEDULES
E703		ELECTRICAL SCHEDULES
INSTRUMENTATION DRAWINGS		
I001		INSTRUMENTATION & CONTROLS SYMBOLS & ABBREVIATIONS
I101		CONTROL SYSTEM ARCHITECTURE DIAGRAM
<del>I201</del>		<del>AERATION BASIN INSTRUMENTATION DIAGRAM</del>

Sheet C-807 "Details Digesters" has been omitted.

GENERAL NOTES

1. OWNERSHIP OF DOCUMENTS -THIS DOCUMENT INCLUDING THE IDEAS AND DESIGNS INCORPORATED HEREIN AS AN INSTRUMENT OF THE PROFESSIONAL SERVICE IS THE PROPERTY OF THOMPSON & LITTON AND IS NOT TO BE USED IN WHOLE OR IN PART FOR ANY OTHER PROJECT WITHOUT THE WRITTEN AUTHORIZATION OF THOMPSON & LITTON.
2. MINIMUM PIPE COVER SHALL BE 3'-0" UNLESS NOTED OTHERWISE.
3. PIPE FITTINGS SHOWN ARE NOT INTENDED TO BE PRECISE, EITHER IN QUANTITY OR LOCATION. EXACT NUMBER WILL DEPEND ON PIPE MATERIAL SELECTED AND MUST BE DETERMINED BY THE CONTRACTOR.
4. ALL UNPAVED AREAS DISTURBED BY EXCAVATION SHALL BE SEEDED.
5. EXISTENCE AND LOCATION OF UNDERGROUND UTILITIES ARE NOT GUARANTEED AND SHALL BE INVESTIGATED AND VERIFIED IN THE FIELD BY THE CONTRACTOR BEFORE STARTING WORK. ANY DAMAGE DONE TO EXISTING UTILITIES AND FACILITIES SHALL BE REPAIRED AND RESTORED TO ORIGINAL CONDITION.
6. DO NOT SCALE CONCRETE WALL THICKNESS OR OTHER CONCRETE DIMENSIONS FROM PLAN DRAWINGS. REFER TO PLAN DIMENSIONS OR SECTION DRAWINGS.
7. SECTIONS ON DRAWINGS ARE IDENTIFIED AS FOLLOWS:

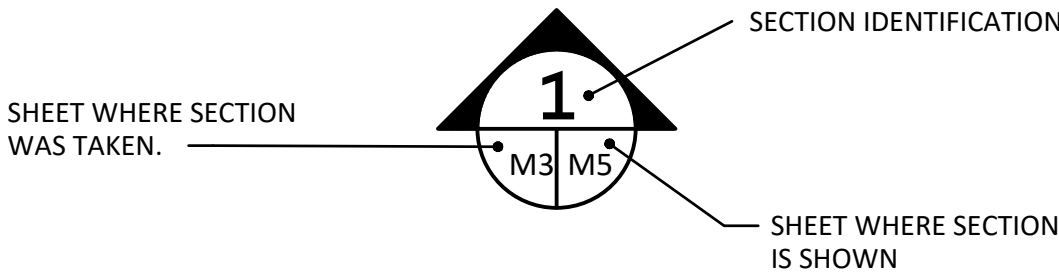

CIVIL ABBREVIATIONS


BOT	Bottom	FIN.	Finished	NPT	National Pipe Thread	SCH.	Schedule
C/C	Center to Center	FLG	Flange	OHE	Over Head Electric	Sec.	Secondary
CONC	Concrete	FRP	Fiber Reinforced Polymer	PD	Positive Displacement	T.O.S.	Top of Slab
CPVC	Chlorinated Polyvinyl Chloride	HLU	Hand Lay Up	PE	Polyethylene	T.O.W.	Top of Wall
DIP	Ductile Iron Pipe	INV	Invert	PMM	Packaged Metering Manhole	TEFC	Totally Enclosed, Fan Cooled
E/W	Each Way	MAX	Maximum	PRV	Pressure Reducing Valve	TYP.	Typical
EL	Elevation	Min	Minimum	PVC	Polyvinyl Chloride	VDOT	Virginia Department of Transportation
ELEV	Elevation	MJ	Mechanical Joint	RAS	Return Activated Sludge	W.L.	Water Level
EQ	Equalization	N/C	Normally Closed	RPZ	Reduced Pressure Zone	WAS	Waste Activated Sludge
FFE	Finished Floor Elevation	N/O	Normally Open	S.S.	Stainless Steel	WW	Wastewater

STRUCTURAL ABBREVIATIONS

BLDG.	Building
E.W. T&B	Each Way, Top and Bottom
FLR.	Floor
FTG.	Footing
INSUL	Insulation
LGTH.	Length
MTL.	Metal
REINF.	Reinforcement
S.O.G.	Slab On Grade
W.W.F.	Welded Wire Fabric

MECHANICAL ABBREVIATIONS

EF	Exhaust Fan
HVAC	Heating, Ventilation, and Air Conditioning
LV	Louver
UH	Unit Heater

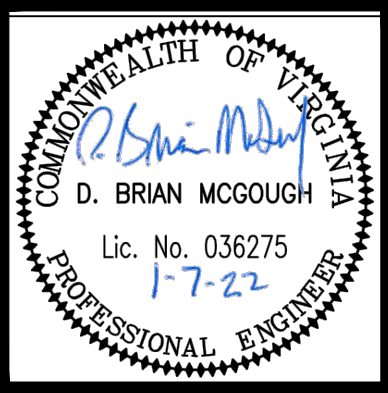

TOWN OF RICHLANDS - 4.0 MGD WWTP  
UPGRADES AND IMPROVEMENTS

SHEET INDEX, GENERAL & CIVIL NOTES &  
ABBREVIATIONS

No.	Date	Purpose of Document Issue
	03-31-21	ISSUED FOR DEQ REVIEW
	04-15-21	ISSUED FOR TOWN REVIEW
	06-21-21	ISSUED FOR DEQ REVIEW
	01-07-22	ISSUED FOR BIDS

Designed	DBM
Drawn	ESB
Checked	
Date	JULY 2020

Project No.	14249
-------------	-------




Sheet No.	G001
-----------	------




## CONSTRUCTION OF A SILT FENCE (WITHOUT WIRE SUPPORT)


1. SET THE STAKES.

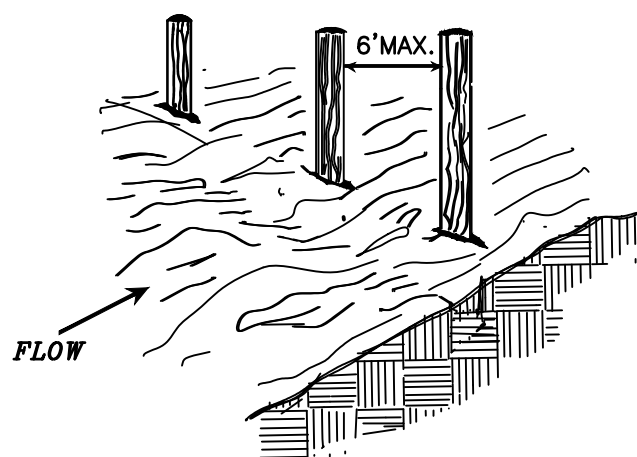


2. EXCAVATE A 4" X 4" TRENCH  
UPSLOPE ALONG THE LINE OF  
STAKES.

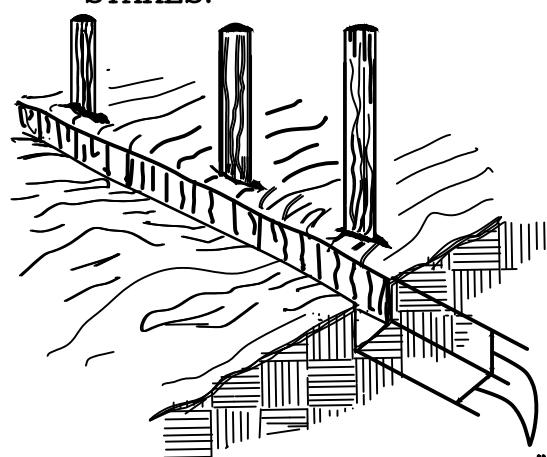


3. STAPLE FILTER MATERIAL  
TO STAKES AND EXTEND  
IT INTO THE TRENCH.

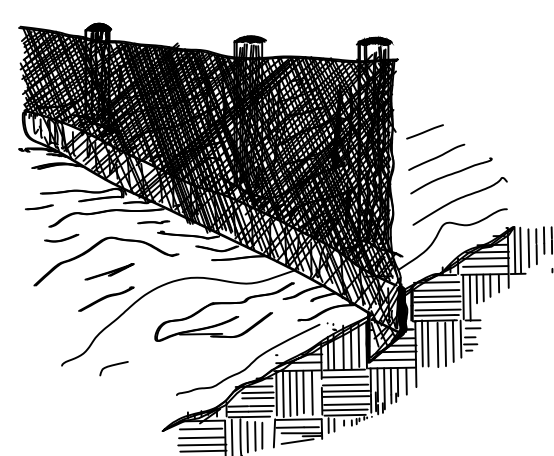

4. BACKFILL AND COMPACT  
THE EXCAVATED SOIL.

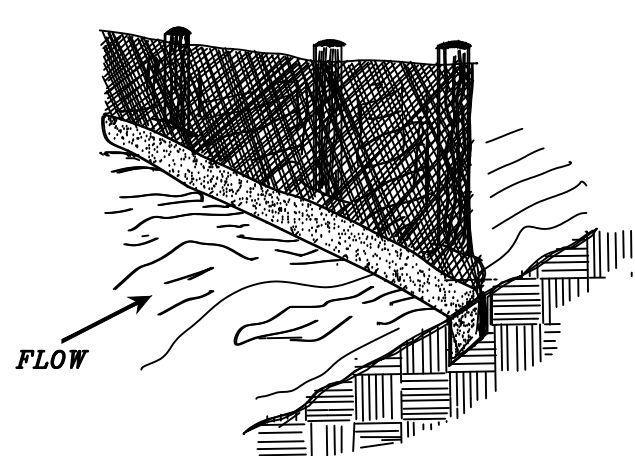

SHEET FLOW INSTALLATION  
(PERSPECTIVE VIEW)

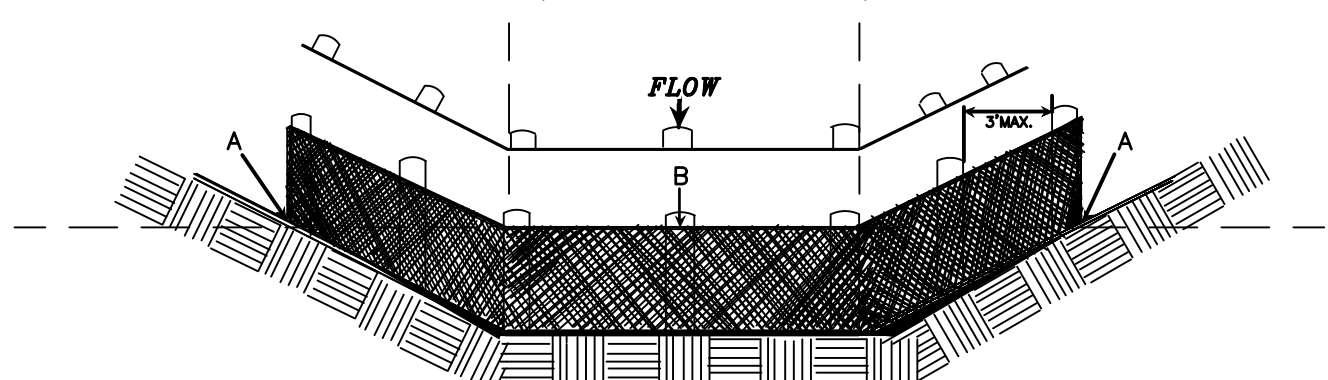


POINTS A SHOULD BE HIGHER THAN POINT B.  
DRAINAGEWAY INSTALLATION  
(FRONT ELEVATION)


SOURCE: Adapted from Installation of Straw and Fabric Filter Barriers for Sediment Control, VA. DSWC  
Sherwood and Wyant

PLATE 3.05-2

## SILT FENCE DROP INLET PROTECTION

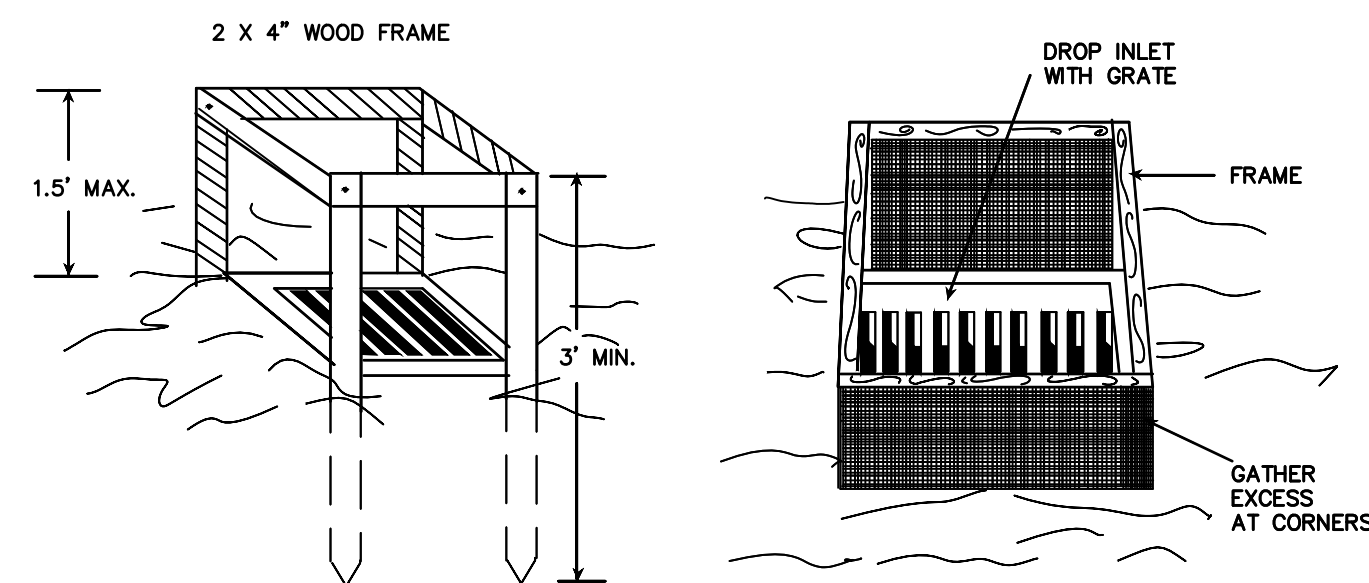

PERSPECTIVE VIEWS

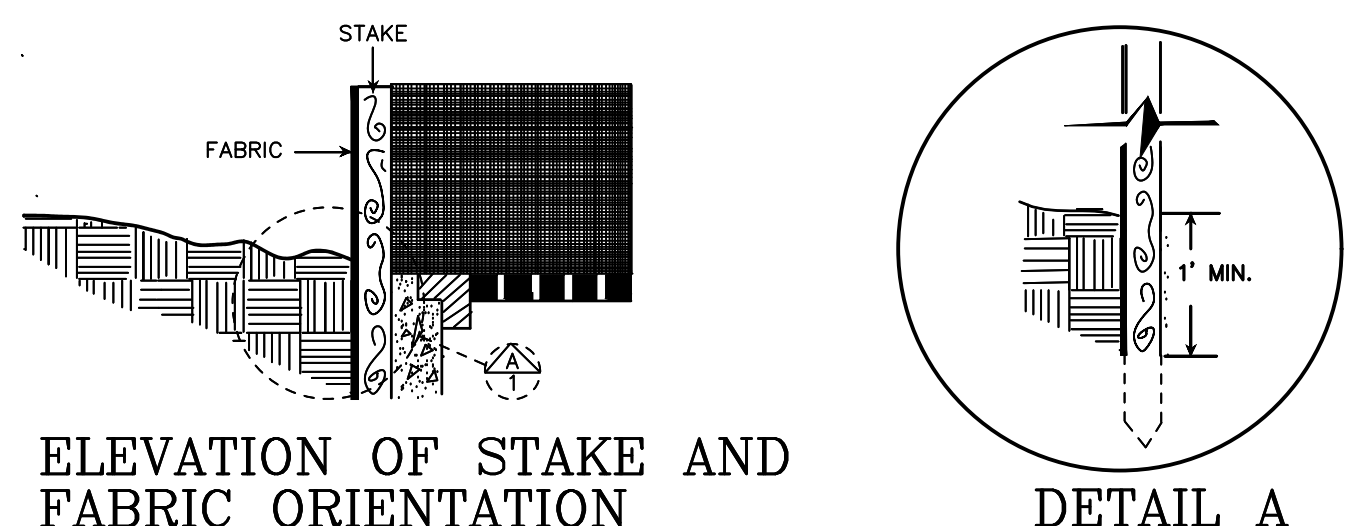

ELEVATION OF STAKE AND  
FABRIC ORIENTATION

### SPECIFIC APPLICATION

THIS METHOD OF INLET PROTECTION IS APPLICABLE WHERE THE INLET DRAINS A RELATIVELY FLAT AREA (SLOPE NO GREATER THAN 5%) WHERE THE INLET SHEET OR OVERLAND FLOWS (NOT EXCEEDING 1 C.F.S.) ARE TYPICAL. THE METHOD SHALL NOT APPLY TO INLETS RECEIVING CONCENTRATED FLOWS, SUCH AS IN STREET OR HIGHWAY MEDIANS.

SOURCE: N.C. Erosion and Sediment Control Planning and Design Manual, 1988

PLATE 3.07-1

1992

3.05

TABLE 3.05-B  
PHYSICAL PROPERTIES OF  
FILTER FABRIC IN SILT FENCE

Physical Property	Test	Requirements
Filtering Efficiency	ASTM 5141	75% (minimum)
Tensile Strength at 20% (max.) Elongation*	VTM-52	Extra Strength - 50 lbs./linear inch (minimum) Standard Strength - 30 lbs./linear inch (minimum)
Flow Rate	ASTM 5141	0.2 gal./sq.ft./minute (minimum)
Ultraviolet Radiation Stability %	ASTM-G-26	90% (minimum)

\* Requirements reduced by 50% after six months of installation.

SOURCE: VHTRC

SOURCE: VIRGINIA EROSION & SEDIMENT CONTROL HANDBOOK

III - 22

1992

3.30

TABLE 3.30-A  
CUBIC YARDS OF TOPSOIL REQUIRED  
FOR APPLICATION TO VARIOUS DEPTHS

Depth (inches)	Per 1,000 Square Feet	Per Acre
1	3.1	134
2	6.2	268
3	9.3	403
4	12.4	537
5	15.5	672
6	18.6	806

SOURCE: Va. DSWC

SOURCE: VIRGINIA EROSION & SEDIMENT CONTROL HANDBOOK

III - 283

1992

3.31

TABLE 3.31-B  
ACCEPTABLE TEMPORARY SEEDING PLANT MATERIALS  
'QUICK REFERENCE FOR ALL REGIONS'

Planting Dates	Species	Rate (lbs./acre)
Sept. 1 - Feb. 15	50/50 Mix of Annual Ryegrass ( <i>Lolium multi-florum</i> ) & Cereal (Winter) Rye ( <i>Secale cereale</i> )	50 - 100
Feb. 16 - Apr. 30	Annual Ryegrass ( <i>Lolium multi-florum</i> )	60 - 100
May 1 - Aug 31	German Millet ( <i>Setaria italica</i> )	50

SOURCE: Va. DSWC

SOURCE: VIRGINIA EROSION AND SEDIMENT CONTROL HANDBOOK

III - 287

TABLE 3.31-C

TEMPORARY SEEDING PLANT MATERIALS, SEEDING RATES, AND DATES

SPECIES	SEEDING RATE		NORTH <sup>a</sup>				SOUTH <sup>b</sup>				PLANT CHARACTERISTICS
	Acre	1000 ft <sup>2</sup>	3/1 to 4/30	5/1 to 8/15	8/15 to 11/1	2/15 to 4/30	5/1 to 9/1	9/1 to 11/15			
OATS ( <i>Avena sativa</i> )	3 bu. (up to 100 lbs., not less than 50 lbs.)	2 lbs.	X	-	-	X	-	-			Use spring varieties (e.g., Noble).
RYE <sup>d</sup> ( <i>Secale cereale</i> )	2 bu. (up to 110 lbs., not less than 50 lbs.)	2.5 lbs.	X	-	X	X	-	X			Use for late fall seedings, winter cover. Tolerates cold and low moisture.
GERMAN MILLET ( <i>Setaria italica</i> )	50 lbs.	approx. 1 lb.	-	X	-	-	X	-			Warm-season annual. Dies at first frost. May be added to summer mixes.
ANNUAL RYEGRASS <sup>c</sup> ( <i>Lolium multi-florum</i> )	60 lbs.	1 1/4 lbs.	X	-	X	X	-	X			May be added in mixes. Will mow out of most stands.
WEEDING LOVEGRASS ( <i>Eragrostis curvula</i> )	15 lbs.	5 1/2 ozs.	-	X	-	-	X	-			Warm-season perennial. May bunch. Tolerates hot, dry slopes and acid, infertile soils. May be added to mixes.
KOREAN LESPEDEZA <sup>a</sup> ( <i>Lespedeza stipulacea</i> )	25 lbs.	approx. 1 1/4 lbs.	X	X	-	X	X	-			Warm season annual legume. Tolerates acid soils. May be added to mixes.

<sup>a</sup> Northern Piedmont and Mountain region. See Plates 3.22-1 and 3.22-2.

<sup>b</sup> Southern Piedmont and Coastal Plain.

<sup>c</sup> May be used as a cover crop with spring seeding.

<sup>d</sup> May be used as a cover crop with fall seeding.

X May be planted between these dates.

- May not be planted between these dates.

SOURCE: VIRGINIA EROSION AND SEDIMENT CONTROL HANDBOOK

1992

3.32

APPENDIX 3.32-a

SEED QUALITY CRITERIA

Where certified seed is not available, the minimum requirements for grass and legume seed used in vegetative establishment are as follows:

- All tags on containers of seed shall be labeled to meet the requirements of the State Seed Law.
- All seed shall be subject to re-testing by a recognized seed laboratory that employs a registered seed technologist or by a state seed lab.
- All seed used shall have been tested within twelve (12) months.
- Inoculant - the inoculant added to legume seed in the seed mixtures shall be a pure culture of nitrogen-fixing bacteria prepared for the species. Inoculants shall not be used later than the date indicated on the container. Twice the supplier's recommended rate of inoculant will be used on dry seedlings; five times the recommended rate if hydroseeded.
- The quality of the seed used shall be shown on the bag tags to conform to the guidelines in Table 3.32-E.

SOURCE: VIRGINIA EROSION AND SEDIMENT CONTROL HANDBOOK

III - 310

TABLE 3.32-A (Continued)  
CHARACTERISTICS OF COMMONLY SELECTED GRASSES

COMMON NAME (Botanical Name)		Life Cycle	Season	pH Range	Germination Time, In Days	Optimum Germination Temperature (°F)	Winter Hardiness	Drought Tolerance	Fertility	Soil Drainage Tolerance	Seeds Per Pound	MAINTENANCE REQUIREMENTS	REMARKS	Suggested Varieties for Virginia
FINE FESCUES	HARD FESCUE ( <i>Festuca Longifolia</i> )	P	C	5.0-6.2	10-14	60-80	VG	G	L	MWD	400K	Grows well in sun or shade and will tolerate infertile soils; improved disease resistance.	Exceeds all fine fescues in most tests. Excellent for low-maintenance situations.	Reliant, Spartan, Aurora
	CHEWINGS FESCUE	P	C	5.0-6.2	10-14	60-80	VG	G	L	MWD	400K	Tolerates shade, dry infertile soils.	Poor traffic tolerance, less thick than other fine fescues.	Flyer
	RED FESCUE ( <i>Festuca Rubra</i> )	P	C	5.0-6.2	10-14	60-80	VG	G	L	MWD	400K	Low to medium fertility requirements. Requires well-drained soil.	Spreads by rhizomes, tillers and stolons. Will not take traffic - very shade tolerant.	Long-fellow, Victory
REED CANARYGRASS ( <i>Phalaris arundinacea</i> )		P	C	5.8-6.2	21	70-85	G	G	M-H	VPD	530K	Do not mow closely or often.	Conservation cover in wet areas.	No named varieties

KEY

A = Annual P = Perennial C = Cool Season Plant W = Warm Season Plant G = Good F = Fair P = Poor VP = Very Poor H = High M = Medium L = Low SPD = Somewhat Poorly Drained MPD = Moderately Poorly Drained PD = Poorly Drained VPD = Very Poorly Drained

SOURCE: VIRGINIA EROSION AND SEDIMENT CONTROL HANDBOOK

TABLE 3.32-A  
CHARACTERISTICS OF COMMONLY SELECTED GRASSES

COMMON NAME (Botanical Name)	Life Cycle	Season	pH Range	Germination Time, In Days	Optimum Germination Temperature (°F)	Winter Hardiness	Drought Tolerance	Fertility	Soil Drainage Tolerance	Seeds Per Pound	MAINTENANCE REQUIREMENTS	REMARKS	Suggested Varieties for Virginia
TALL FESCUE ( <i>Festuca arundinacea</i> )	P	C	5.5-6.2	10-14	60-85	F	F	M	SPD	225K	Low when used for erosion control; high when used in lawn.	Better suited for erosion control and rough turf application.	Ky 31
TALL FESCUES (Improved)	P	C	5.5-6.2	10-14	60-85	F	G	M	SPD	220K	Responds well to high maintenance.	Excellent for lawn and fine turf.	See current VCIA list.
KENTUCKY BLUEGRASS ( <i>Poa pratensis</i> )	P	C	6.0-6.5	14	60-75	G	P	M	SPD	2.2m	Needs fertile soil, favorable moisture. Requires several years to become well established.	Excellent for fine turf-takes traffic, mowing. Poor drought/frost tolerance.	See current VCIA list.
PERENNIAL RYEGRASS ( <i>Lolium perenne</i> )	P	C	5.8-6.2	7-10	60-75	F	F	M-H	SPD	227K	Will tolerate traffic.	May be added to mixes. * Improved varieties will perform well all year.	See current VCIA list.

KEY

A = Annual P = Perennial C = Cool Season Plant W = Warm Season Plant G = Good F = Fair P = Poor VP = Very Poor H = High M = Medium L = Low SPD = Somewhat Poorly Drained MPD = Moderately Poorly Drained PD = Poorly Drained VPD = Very Poorly Drained

SOURCE: VIRGINIA EROSION AND SEDIMENT CONTROL HANDBOOK

TABLE 3.32-A (Continued)  
CHARACTERISTICS OF COMMONLY SELECTED GRASSES

COMMON NAME (Botanical Name)	Life Cycle	Season	pH Range	Germination Time, In Days	Optimum Germination Temperature (°F)	Winter Hardiness	Drought Tolerance	Fertility	Soil Drainage Tolerance	Seeds Per Pound	MAINTENANCE REQUIREMENTS	REMARKS	Suggested Varieties for Virginia
REDTOP ( <i>Agrostis alba</i> )	P	C	5.8-6.2	10	65-85	G	F	L	PD	5m	Will tolerate poor, infertile soils; deep rooted.	Does well in erosion control mixes - not for lawns.	No named varieties.
WEEDING LOVEGRASS ( <i>Eragrostis curvula</i> )	P	W	4.5-6.2	14	65-85	F-P	G	L-M	SPD	1.5m	Low-fertility requirements; excellent drought tolerance.	Fast-growing, warm-season bunch grass. Excellent cover for erosion control.	No named varieties.
BERMUDAGRASS ( <i>Cynodon dactylon</i> )	P	W	5.8-6.2	21	70-95	P	G	M-H	SPD	1.8m hulled	High nitrogen utilization, excellent drought tolerance. Some varieties adapted to western VA.	Common varieties used for erosion control. Hybrids used for fine turf.	See current VCIA list.
ORCHARDGRASS ( <i>Dactylis glomerata</i> )	P	C	5.8-6.2	18	60-75	F	F	M	SPD	625K	Does best on well-drained, loamy soil.	Good pasture selection - may be grazed.	Virginia origin or Potomac

KEY

A = Annual P = Perennial C = Cool Season Plant W = Warm Season Plant G = Good F = Fair P = Poor VP = Very Poor H = High M = Medium L = Low SPD = Somewhat Poorly Drained MPD = Moderately Poorly Drained PD = Poorly Drained VPD = Very Poorly Drained

SOURCE: VIRGINIA EROSION AND SEDIMENT CONTROL HANDBOOK

1992

3.32

TABLE 3.32-C  
SITE SPECIFIC SEEDING MIXTURES  
FOR APPALACHIAN/MOUNTAIN AREA

Minimum Care Lawn	Total Lbs. Per Acre
- Commercial or Residential	200-250 lbs.
- Kentucky 31 or Turf-Type Tall Fescue	90-100%
- Improved Perennial Ryegrass *	0-10%
- Kentucky Bluegrass	0-10%
High-Maintenance Lawn	
Minimum of three (3) up to five (5) varieties of bluegrass from approved list for use in Virginia.	125 lbs.
General Slope (3:1 or less)	
- Kentucky 31 Fescue	128 lbs.
- Red Top Grass	2 lbs.
- Seasonal Nurse Crop **	20 lbs.
Low-Maintenance Slope (Steeper than 3:1)	150 lbs.
- Kentucky 31 Fescue	108 lbs.
- Red Top Grass	2 lbs.
- Seasonal Nurse Crop **	20 lbs.
- Crownvetch ***	150 lbs.


\* Perennial Ryegrass will germinate faster and at lower soil temperatures than fescue, thereby providing cover and erosion resistance for seedbed.

\*\* Use seasonal nurse crop in accordance with seeding dates as stated below:  
March, April through May 15th ..... Annual Rye  
May 16th through August 15th ..... Foxtail Millet  
August 16th through September, October ..... Annual Rye  
November through February ..... Winter Rye

\*\*\* If Flatpea is used, increase to 30 lbs./acre. All legume seed must be properly inoculated. Weeping Lovegrass may also be included in any slope or low-maintenance mixture during warmer seeding periods; add 10-20 lbs./acre in mixes.

SOURCE: VIRGINIA EROSION AND SEDIMENT CONTROL HANDBOOK

III - 302

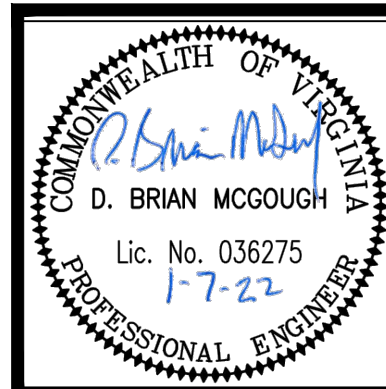


TOWN OF RICHLANDS - 4.0 MGD WWTP  
UPGRADES AND IMPROVEMENTS

EROSION & SEDIMENT CONTROL DETAILS

No.	Date	Purpose of Document Issue
	03-31-21	ISSUED FOR DEC REVIEW
	04-15-21	ISSUED FOR TOWN REVIEW
	06-21-21	ISSUED FOR DEC REVIEW
	01-07-22	ISSUED FOR BIDS

Designed	DBM
Drawn	ESB
Checked	
Date	JULY 2020

Project No.  
14249

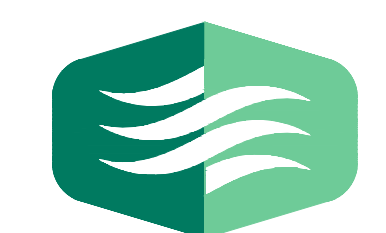

THOMPSON  
& LITTON

Sheet No.

C001



APPENDIX 3.32-d

TABLE 3.32-F				
LBS. OF GROUND AGRICULTURAL LIMESTONE* PER THOUSAND SQUARE FEET NEEDED TO CORRECT pH LEVEL OF ACID SOILS TO 6.5				
Existing pH	Soil Texture			
	Sandy Loam	Loam	Clay Loam	
6.2	20	35	40	
6.0	40	55	70	
5.8	55	65	85	
5.6	70	80	105	
5.4	90	100	125	
5.2	105	120	140	
5.0	120	140	160	
4.8	125	180	205	
4.6	155	210	230	
4.0	200	250	300	

\* Lime should always be applied in accordance with the results of a soil test, such as may be obtained through the soil testing laboratory at VPI&SU or through a reputable commercial laboratory.

Source: DSWC's Basic Urban E&amp;S in Virginia

SOURCE: VIRGINIA EROSION AND SEDIMENT CONTROL HANDBOOK

III - 331(A)

TABLE 3.32-A (Continued) CHARACTERISTICS OF COMMONLY SELECTED GRASSES													
COMMON NAME (Botanical Name)	Life Cycle	Season	pH Range	Germination Time in Days	Optimum Germination Temperature (°F)	Winter Hardiness	Drought Tolerance	Fertility	Soil Drainage Tolerance	Seeds Per Pound	MAINTENANCE REQUIREMENTS	REMARKS	Suggested Varieties for Virginia
ANNUAL RYEGRASS ( <i>Lolium multiflorum</i> )	A	C	5.8-6.2	7	60-70	G	P	M-H	SPD	227K	Will grow on most Virginia soils. Do not use in fine-turf areas.	May be added into mixes or established alone as temporary cover in spring and fall.	No named varieties.
RYE ( <i>Secale cereale</i> )	A	C	5.8-6.2	7	55-70	VG	G	L-M	SPD	18K	Will establish in most all Virginia soils. Do not use in fine-turf areas.	May be added into mixes or established alone for late fall/winter cover.	Abruzzi, Balboa
FOXTAIL MILLET ( <i>Setaria italica</i> )	A	W	5.8-6.2	10	65-85	VP	G	M	MWD	220K	Establishes well during summer. Very low moisture requirements.	May be added to erosion-control mixes or established alone.	Common, German

KEY

A = Annual P = Perennial C = Cool Season Plant W = Warm Season Plant G = Good F = Fair P = Poor VP = Very Poor H = High  
M = Medium L = Low SPD = Somewhat Poorly Drained MPD = Moderately Poorly Drained PD = Poorly Drained VPD = Very Poorly Drained

SOURCE: VIRGINIA EROSION AND SEDIMENT CONTROL HANDBOOK

TABLE 3.32-B (Continued) CHARACTERISTICS OF LEGUMES APPROPRIATE FOR EROSION CONTROL													
COMMON NAME (Botanical Name)	Life Cycle	Season	pH Range	Germination Time in Days	Optimum Germination Temperature (°F)	Winter Hardiness	Drought Tolerance	Fertility	Soil Drainage Tolerance	Seeds Per Pound	MAINTENANCE REQUIREMENTS	REMARKS	Suggested Varieties for Virginia
ANNUAL LESPEDEZAS ( <i>Lespedeza striata</i> , <i>L. stipulacea</i> )	A	W	5.8-6.2	14	70-85	F	VG	L	MWD	200K	Will grow on almost any well-drained soil.	Choose Kobe for southeastern Va.; needs almost no nitrogen to survive.	Kobe, Korean
RED CLOVER ( <i>Trifolium pratense</i> )	P	C	6.0-6.5	7-14	70	G	F	M	SPD	275K	Needs high levels of phosphorus and potassium.	Acts as a biennial. Can be added to low-maintenance mixes.	Kenstar, Kenland
WHITE CLOVER ( <i>Trifolium repens</i> )	P	C	6.0-6.5	10	70	G	P	M	PD	700K	Requires favorable moisture, fertile soils, high pH.	Spreads by soil surface stolons, white flowers.	Common, White Dutch

KEY

A = Annual P = Perennial C = Cool Season Plant W = Warm Season Plant G = Good F = Fair P = Poor VP = Very Poor H = High  
M = Medium L = Low SPD = Somewhat Poorly Drained MPD = Moderately Poorly Drained PD = Poorly Drained VPD = Very Poorly Drained

SOURCE: VIRGINIA EROSION AND SEDIMENT CONTROL HANDBOOK



TABLE 3.32-B  
CHARACTERISTICS OF LEGUMES APPROPRIATE FOR EROSION CONTROL

COMMON NAME (Botanical Name)	Life Cycle	Season	pH Range	Germination Time in Days	Optimum Germination Temperature (°F)	Winter Hardiness	Drought Tolerance	Fertility	Soil Drainage Tolerance	Seeds Per Pound	MAINTENANCE REQUIREMENTS	REMARKS	Suggested Varieties for Virginia
CROWN VETCH ( <i>Coronilla varia</i> )	P	C	6.0-6.5	14-21	70	G	VG	M	MWD	110K	Does best on well-drained soils. Minimum maintenance when established. May need phosphorus. Inoculation is essential.	Excellent for steep, rocky slopes. Produces colorful blooms in May/June. Slow to establish. Does best when seeded in spring.	Penngift, Chemung, Emerald
SERICEA LESPEDEZA ( <i>Lespedeza cuneata</i> )	P	W	5.8-6.2	21-28	70-85	F	VG	L	MWD	335K	Grows in most well-drained soils. Low fertility requirements. Inoculation is essential.	Use hulled seed in spring; unhusked in fall. Very deep-rooted legume. Excellent choice for eastern Va.	Sericea, Interstate
FLATPEA ( <i>Lathyrus silvestris</i> )	P	C	5.0-7.0	14-28	65-75	G	G	L	PD	15K	Needs lime and high phosphorus. Good shade tolerance.	Tolerates acidic and wetter soils better than other legumes.	Lathco
BIRDSFOOT TREFOIL ( <i>Lotus corniculatus</i> )	P	C	6.0-6.5	7	65-70	G	F	M	SPD	375K	Inoculation is essential. Grows in medium-fertile, slightly acid soils.	Grows better on poorly drained soils than most legumes. Poor drought/hat tolerance.	No named varieties.

KEY

A = Annual P = Perennial C = Cool Season Plant W = Warm Season Plant G = Good F = Fair P = Poor VP = Very Poor H = High  
M = Medium L = Low SPD = Somewhat Poorly Drained MPD = Moderately Poorly Drained PD = Poorly Drained VPD = Very Poorly Drained

SOURCE: VIRGINIA EROSION AND SEDIMENT CONTROL HANDBOOK

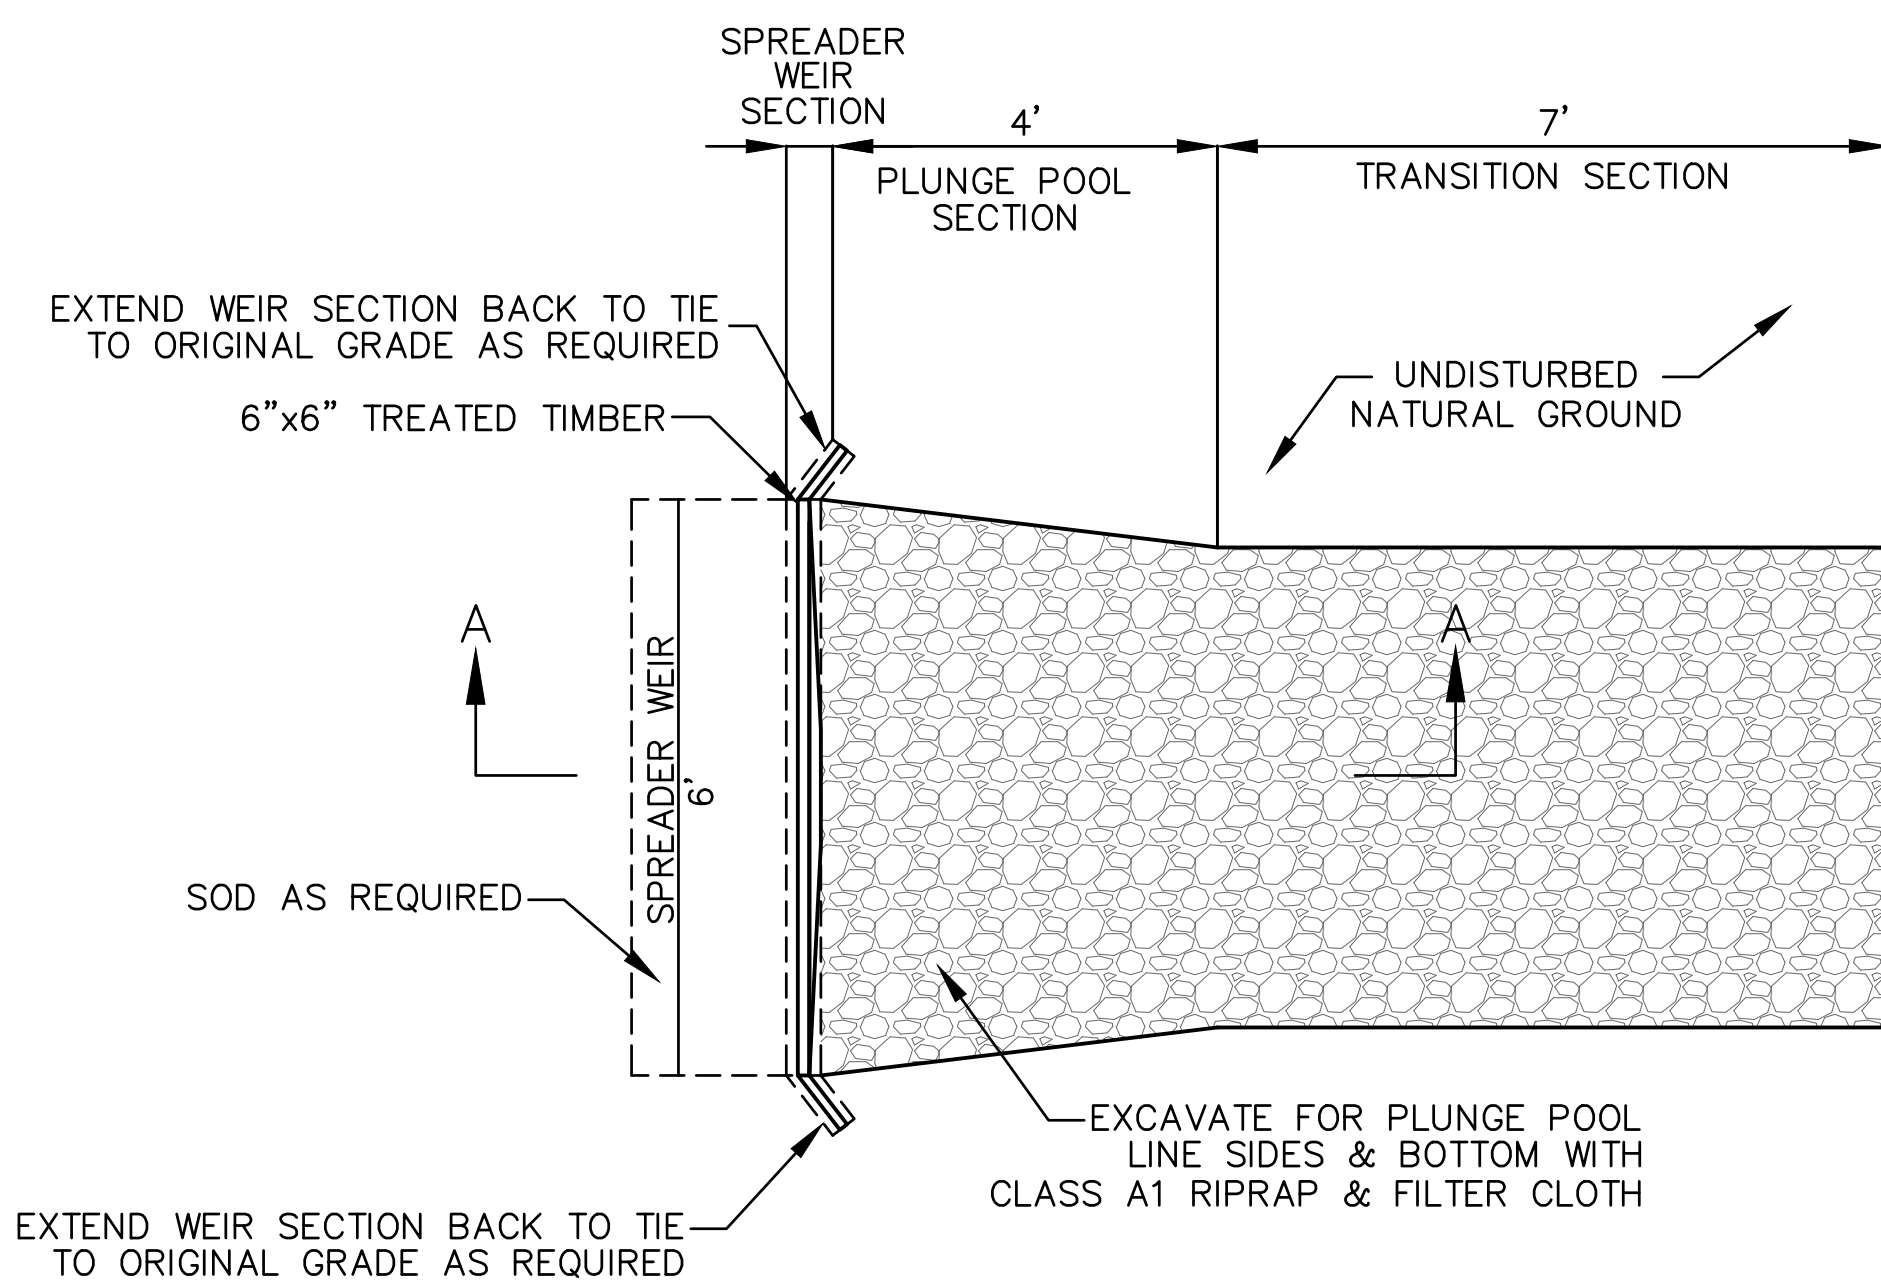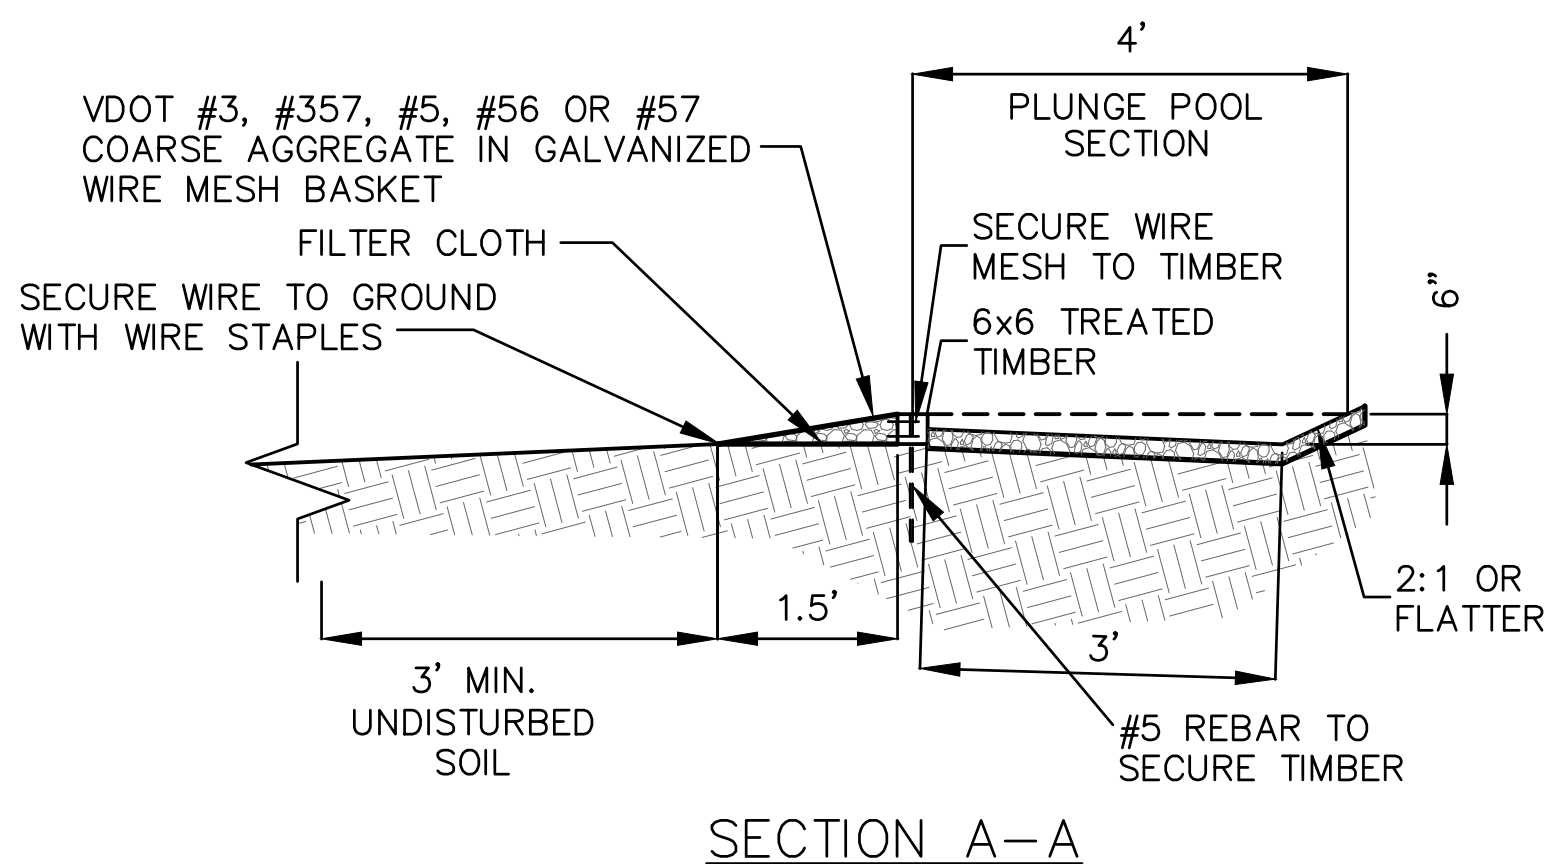

## TYPICAL DETAIL - LEVEL SPREADER

N.T.S.

TABLE 3.32-E QUALITY OF SEED*		
Legumes	Minimum Seed Purity (%)	Minimum Germination (%)
Crownvetch	98	65**
Lespedeza, Korean	97	85**
Lespedeza, Sericea	98	85**
Grasses		
Bluegrass, Kentucky	97	85
Fescue, Tall (Improved, Turf-Type Cultivars)	98	85
Fescue, Tall (Ky-31)	97	85
Fescue, Red	98	85
Redtop	94	80
Reed Canarygrass	98	80
Perennial Ryegrass	98	90
Weeping Lovegrass	98	87
Annuals		
Annual Ryegrass	97	90
German Millet	98	85
Oats	98	80
Cereal Rye	98	85

\* Seed containing prohibited or restricted noxious weeds should not be accepted. Seed should not contain in excess of 0.5% weed seed. To calculate percent pure, live seed, multiply germination times purity and divide by 100.

Example: Ky-31 Tall Fescue with a germination of 85 percent and a purity of 97 percent.  
 $97 \times 85 = 8245$   
 $8245 \div 100 = 82.45$  percent pure live seed.

\*\* Includes "hard seed"

SOURCE: VIRGINIA EROSION AND SEDIMENT CONTROL HANDBOOK  
III - 311

TABLE 3.35-A ORGANIC MULCH MATERIALS AND APPLICATION RATES			
MULCHES:	RATES:		NOTES:
	Per Acre	Per 1000 sq. ft.	
Straw or Hay	1½ - 2 tons (Minimum 2 tons for winter cover)	70 - 90 lbs.	Free from weeds and coarse matter. Must be anchored. Spread with mulch blower or by hand.
Fiber Mulch	Minimum 1500 lbs.	35 lbs.	Do not use as mulch for winter cover or during hot, dry periods.* Apply as slurry.
Corn Stalks	4 - 6 tons	185 - 275 lbs.	Cut or shredded in 4-6" lengths. Air-dried. Do not use in fine turf areas. Apply with mulch blower or by hand.
Wood Chips	4 - 6 tons	185 - 275 lbs.	Free of coarse matter. Air-dried. Treat with 12 lbs nitrogen per ton. Do not use in fine turf areas. Apply with mulch blower, chip handler, or by hand.
Bark Chips or Shredded Bark	50 - 70 cu. yds.	1-2 cu. yds.	Free of coarse matter. Air-dried. Do not use in fine turf areas. Apply with mulch blower, chip handler, or by hand.

\* When fiber mulch is the only available mulch during periods when straw should be used, apply at a minimum rate of 2000 lbs./ac. or 45 lbs./1000 sq. ft.

Source: Va. DSWC

SOURCE: VIRGINIA EROSION AND SEDIMENT CONTROL HANDBOOK


III - 353

TOWN OF RICHLANDS - 4.0 MGD WWTP  
UPGRADES AND IMPROVEMENTS

EROSION &amp; SEDIMENT CONTROL DETAILS

Purpose of Document Issue		Date		No.	
ISSUED FOR DEC REVIEW		03-31-21			
ISSUED FOR TOWN REVIEW		04-15-21			
ISSUED FOR DEC REVIEW		06-21-21			
ISSUED FOR BIDS		01-07-22			


Designed	DBM
Drawn	ESB
Checked	
Date	JULY 2020

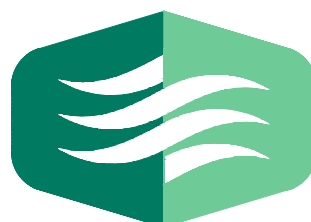Project No.  
14249THOMPSON  
& LITTON


Sheet No.

C002




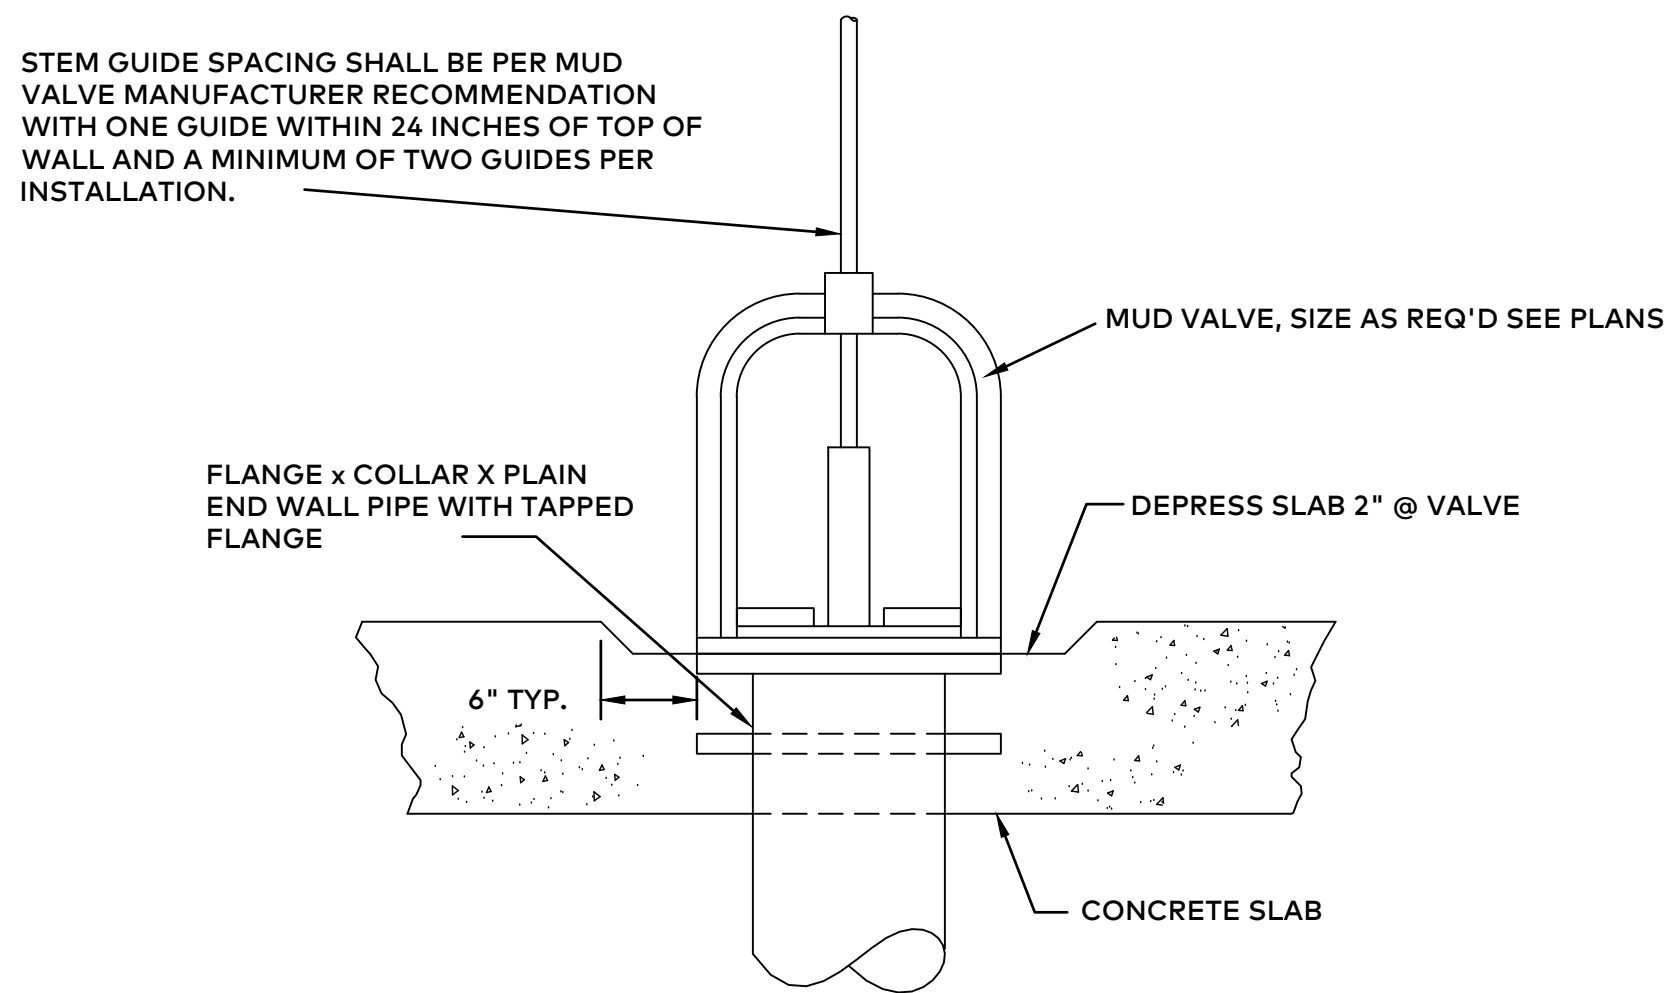


**TYPICAL DETAIL - MUD VALVE INSTALLATION**  
NOT TO SCALE

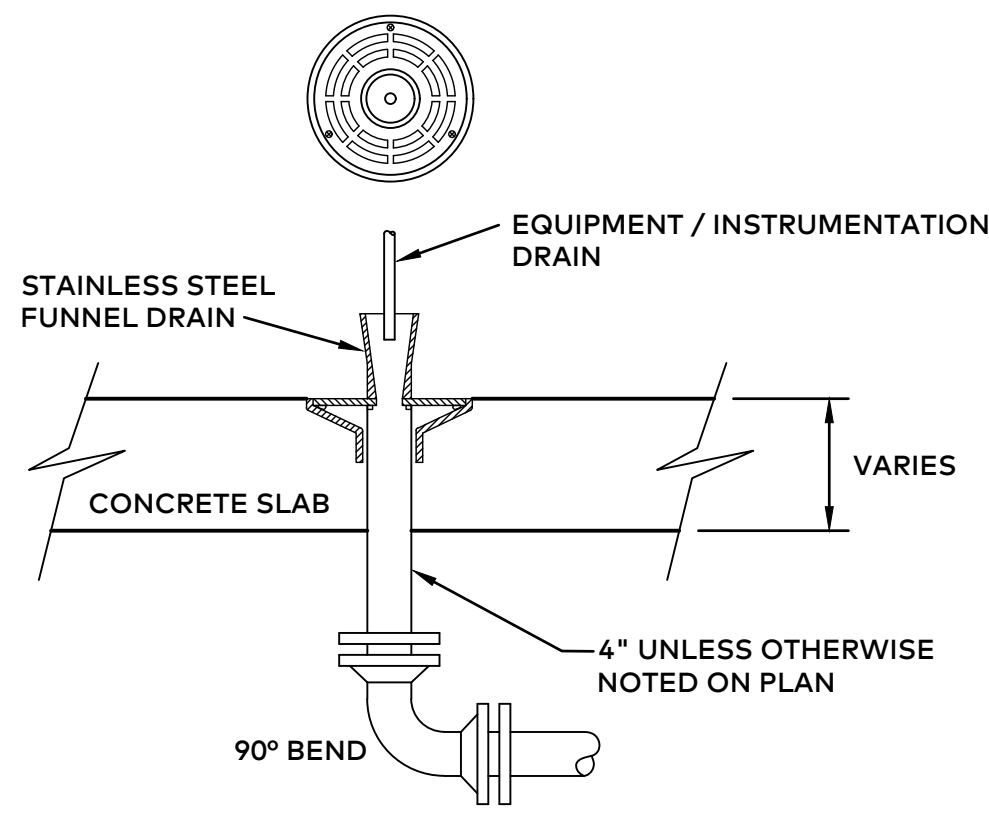


**TYPICAL DETAIL - EQUIPMENT / INSTRUMENT DRAIN DETAIL**  
NOT TO SCALE

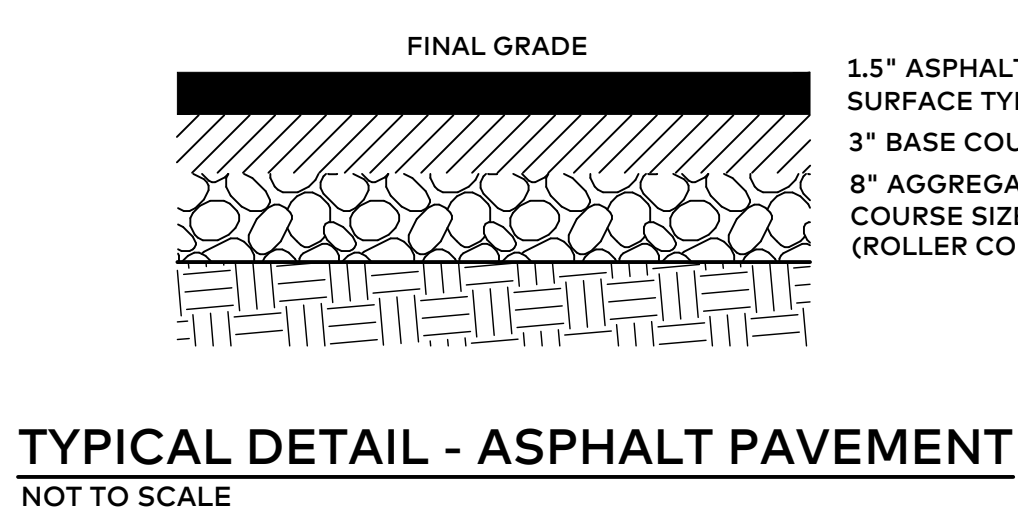


**TYPICAL DETAIL - ASPHALT PAVEMENT**  
NOT TO SCALE

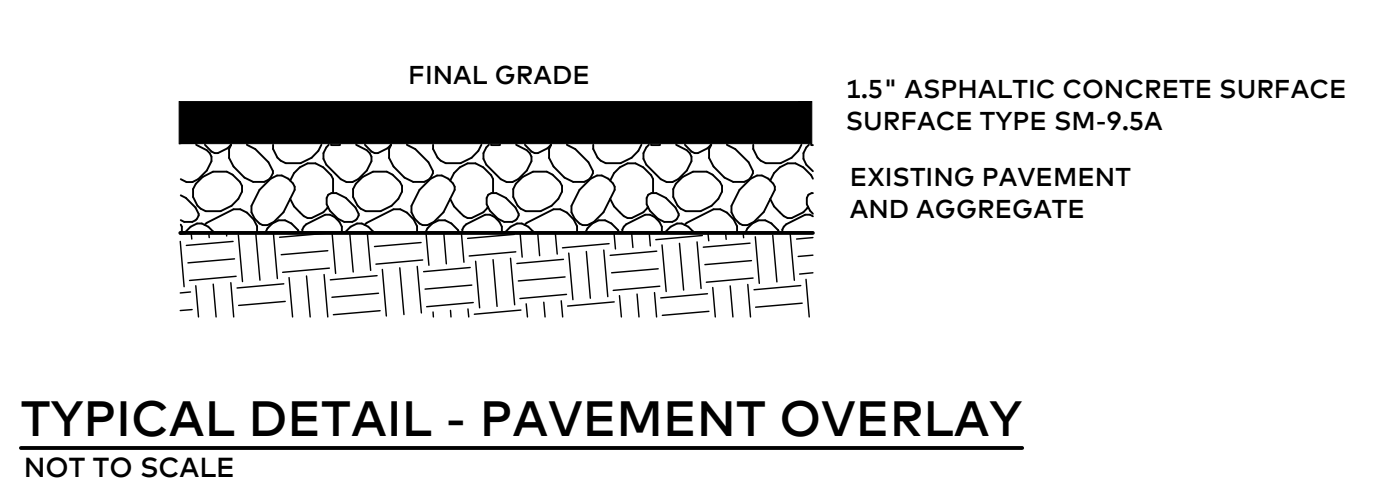


**TYPICAL DETAIL - PAVEMENT OVERLAY**  
NOT TO SCALE

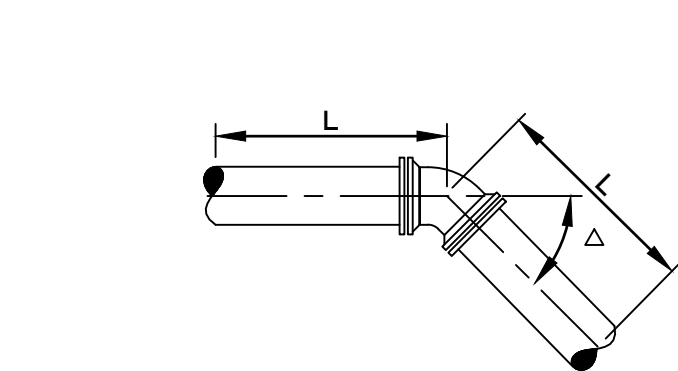

VERTICAL OR HORIZONTAL BENDS

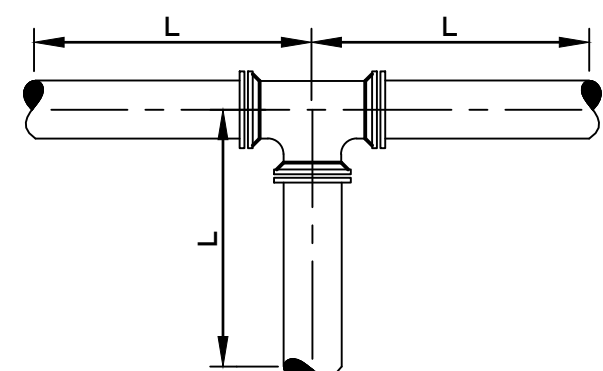


VERTICAL OR HORIZONTAL TEES

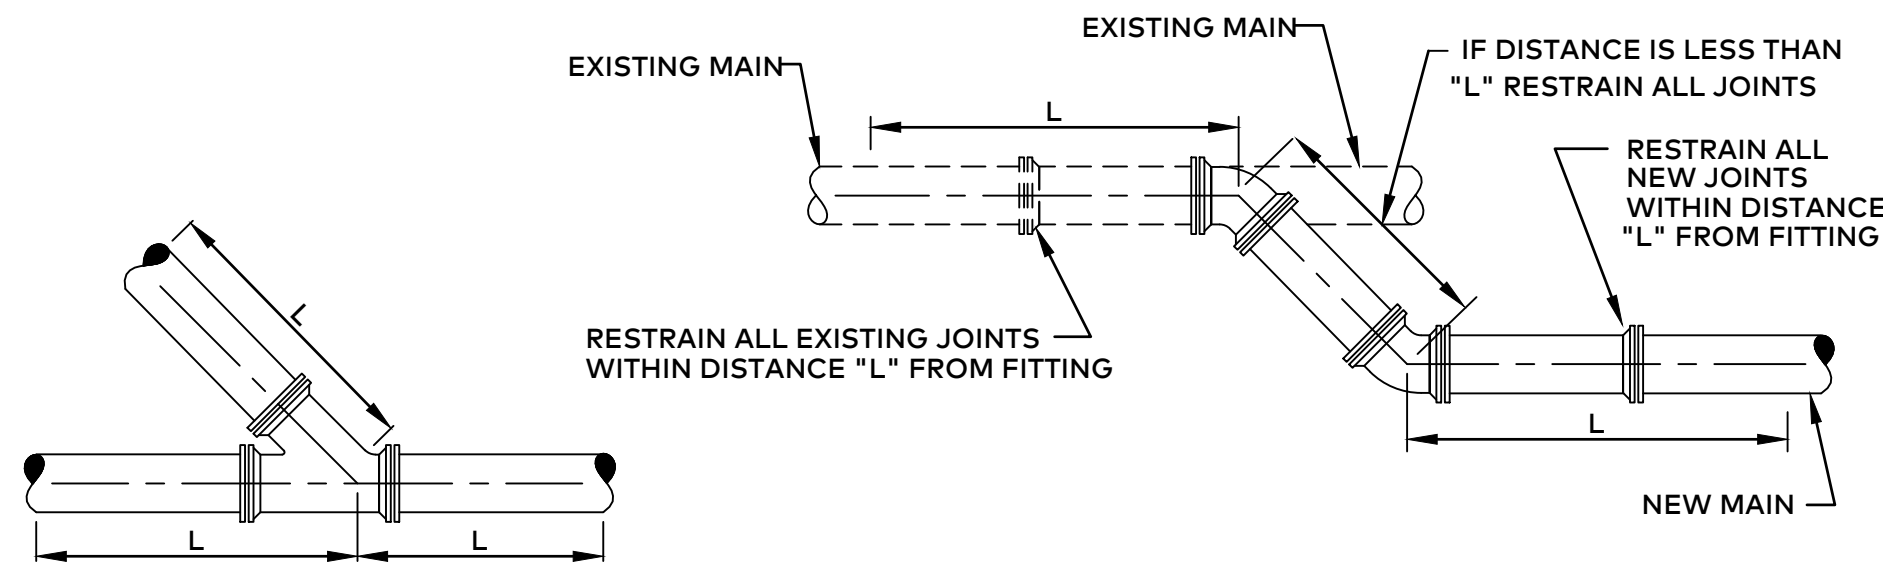


VERTICAL OR HORIZONTAL WYES

CONNECTION TO EXISTING MAIN


**TYPICAL DETAILS-MECHANICAL JOINT RESTRAINING DEVICES**  
NOT TO SCALE

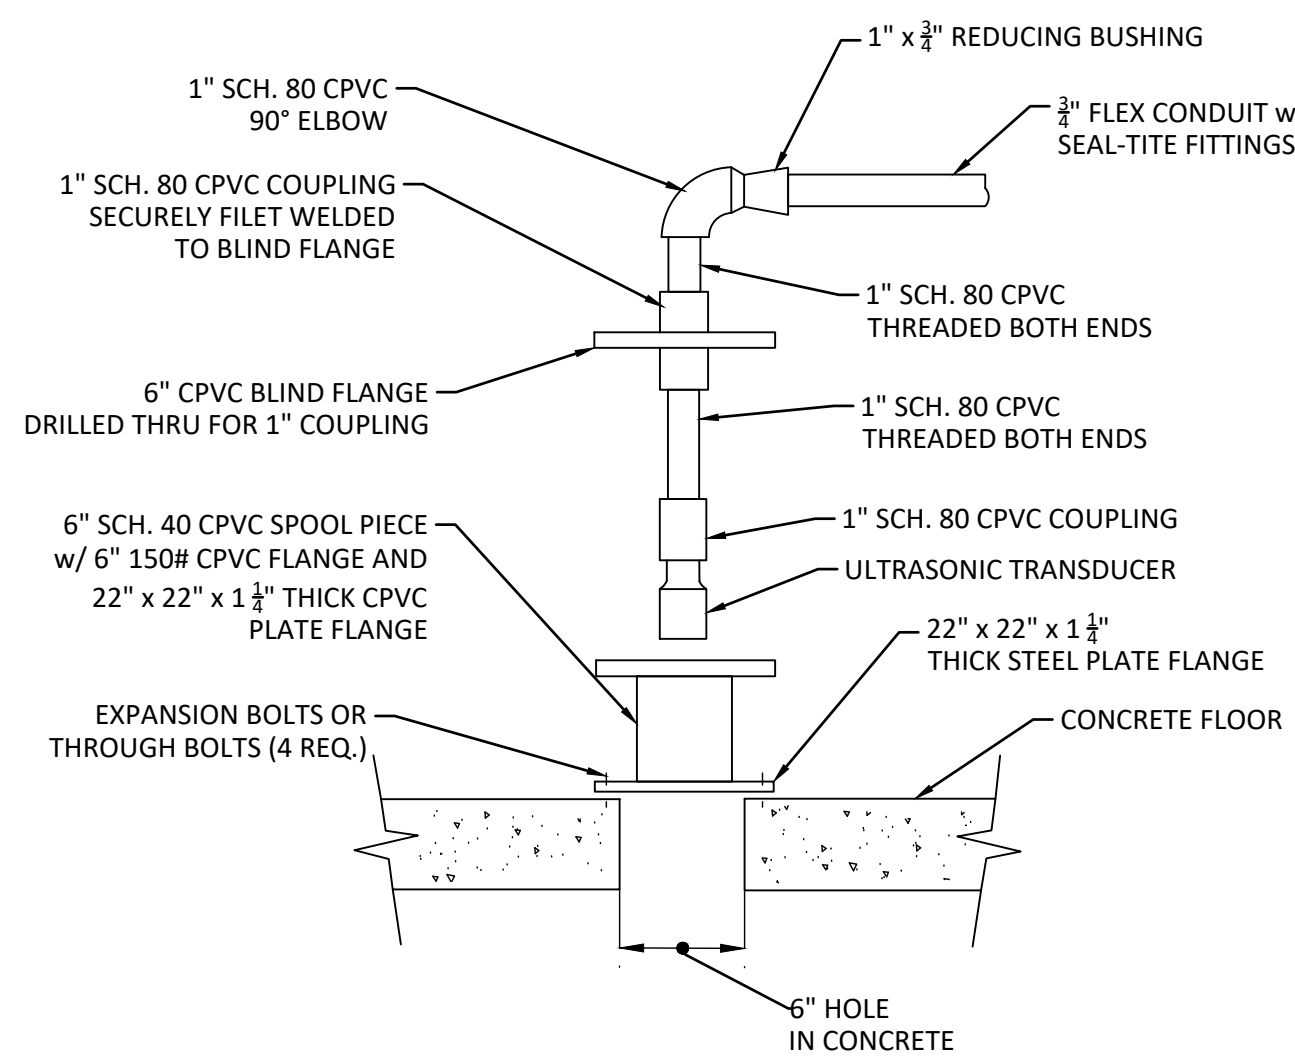


**TYPICAL DETAIL - ULTRASONIC LEVEL CONTROL DETAIL**  
NOT TO SCALE

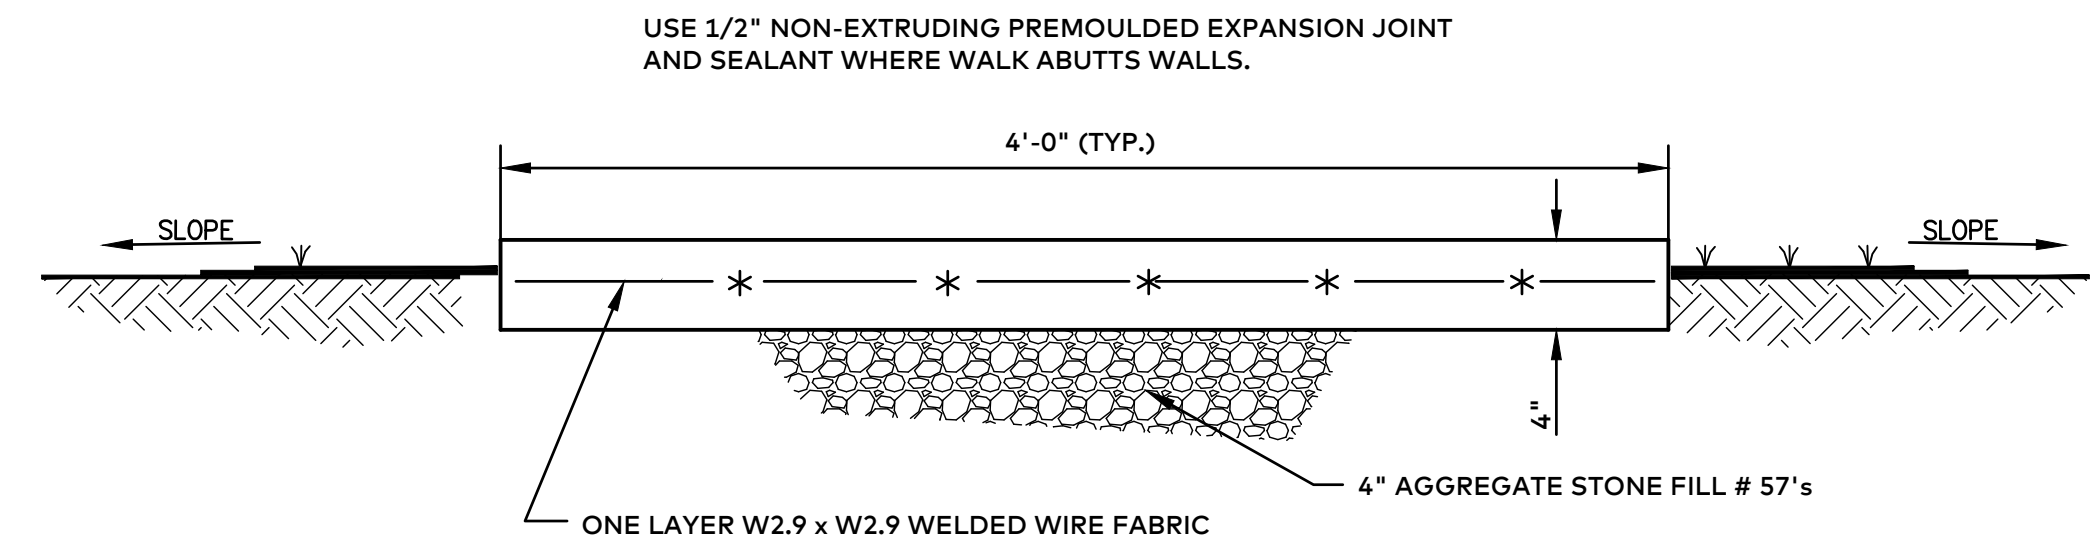

**TYPICAL SECTION**

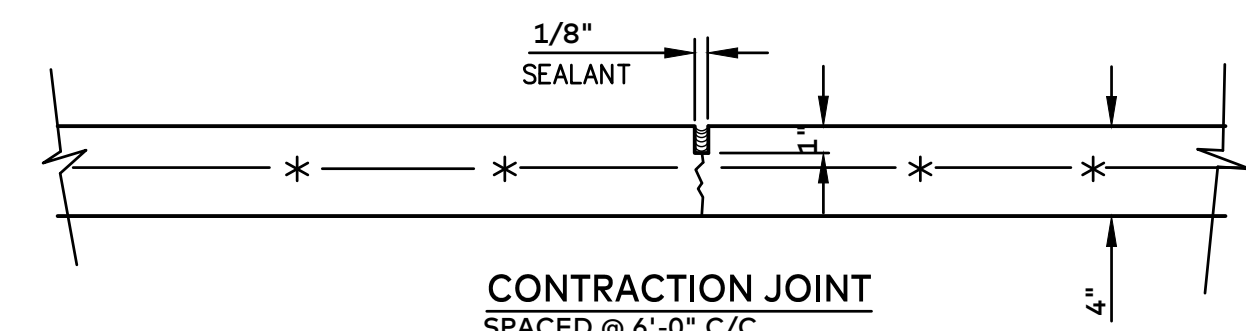

**CONTRACTION JOINT**  
SPACED @ 6'-0" C/C

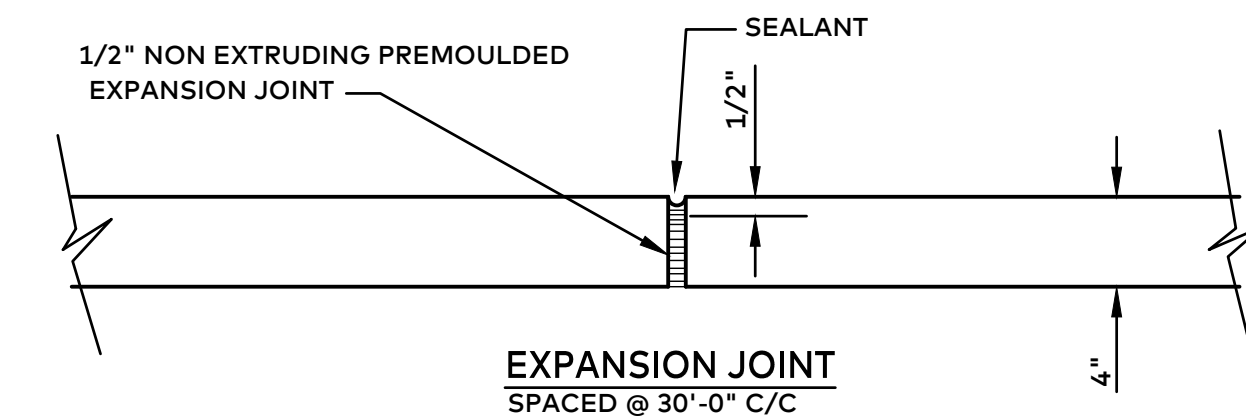


**TYPICAL DETAIL - SIDEWALK**  
NOT TO SCALE

WORKING PRESSURE : 200 P.S.I.								
PIPE SIZE (in)	L = MINIMUM LENGTH OF RESTRAINED PIPE (ft)							
	Δ=90°		Δ=45°		Δ=22.5°		Δ=11.25°	
	HORIZ.	VERT.	HORIZ.	VERT.	HORIZ.	VERT.	HORIZ.	VERT.
4	37	38	16	16	8	8	4	4
6	52	57	21	24	11	12	5	7
8	70	77	30	32	16	16	7	8


**NOTE:**

1. THE RESTRAINED LENGTH OF PIPE IS BASED ON THE FOLLOWING: A WORKING PRESSURE AS SHOWN IN THE TABLES, 3'-0" OF PIPE COVER, AND A SOIL TYPE CLASSIFICATION OF "MH".
2. PLUGS SHALL BE RESTRAINED BASED ON THE RESTRAINED LENGTH FOR 90° VERTICAL BENDS.
3. VALVES, TEES, AND WYES SHALL BE RESTRAINED BASED ON THE RESTRAINED LENGTH FOR 45° HORIZONTAL BENDS.
4. EXISTING PIPE ADJACENT TO PROPOSED BENDS, WYES, VALVES, TEES, AND PLUGS SHALL BE UNCOVERED AND THE EXISTING JOINTS SHALL BE RESTRAINED FOR THE LENGTH INDICATED. IF THE EXISTING WATER MAIN WILL NOT ACCEPT THE MECHANICAL JOINT RESTRAINING MECHANISM, THE EXISTING WATER MAIN SHALL BE REPLACED WITH DUCTILE IRON WATER MAIN FOR THE LENGTH INDICATED. MECHANICAL JOINT RESTRAINING MECHANISMS SHALL NOT BE USED ON EXISTING POLYVINYLCHLORIDE (PVC) PIPE.


**CONSTRUCTION DATA - MECHANICAL JOINT RESTRAINING DEVICES**  
NOT TO SCALE

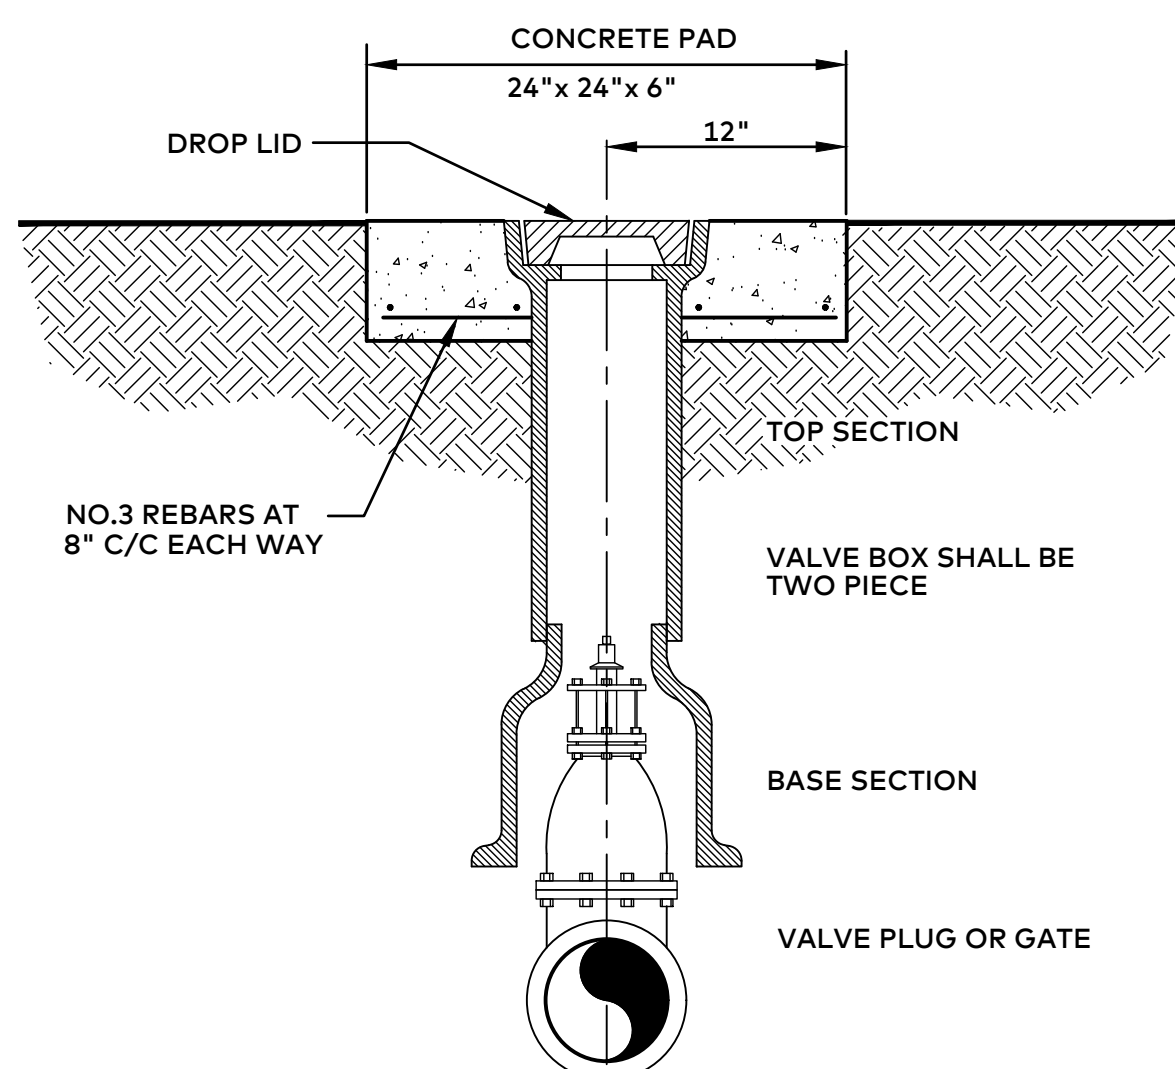


**TYPICAL DETAIL - VALVE BOX**  
NOT TO SCALE

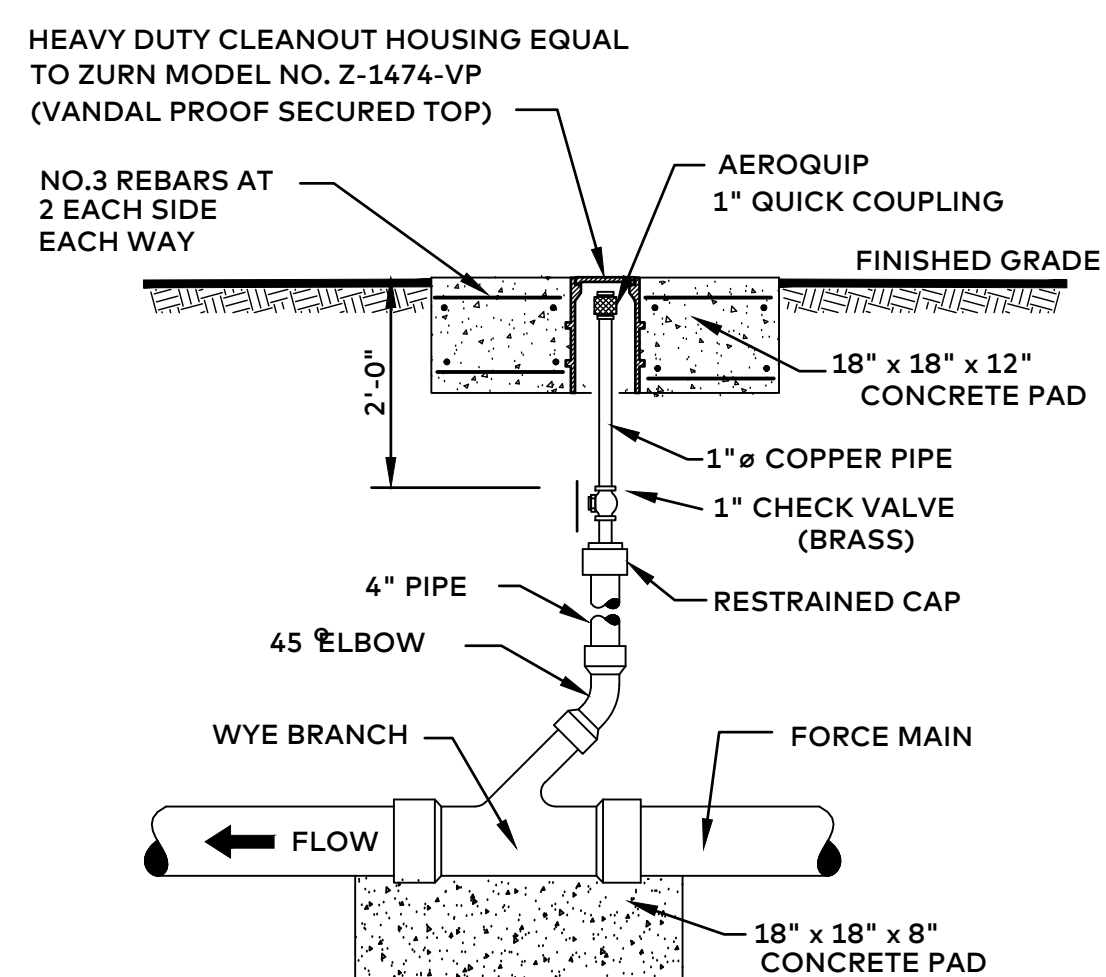

**TYPICAL DETAIL- PRESSURE CLEANOUT**  
NOT TO SCALE  
NOTE:  
ALL PRESSURE CLEANOUT PIPING SHALL BE RESTRAINED.

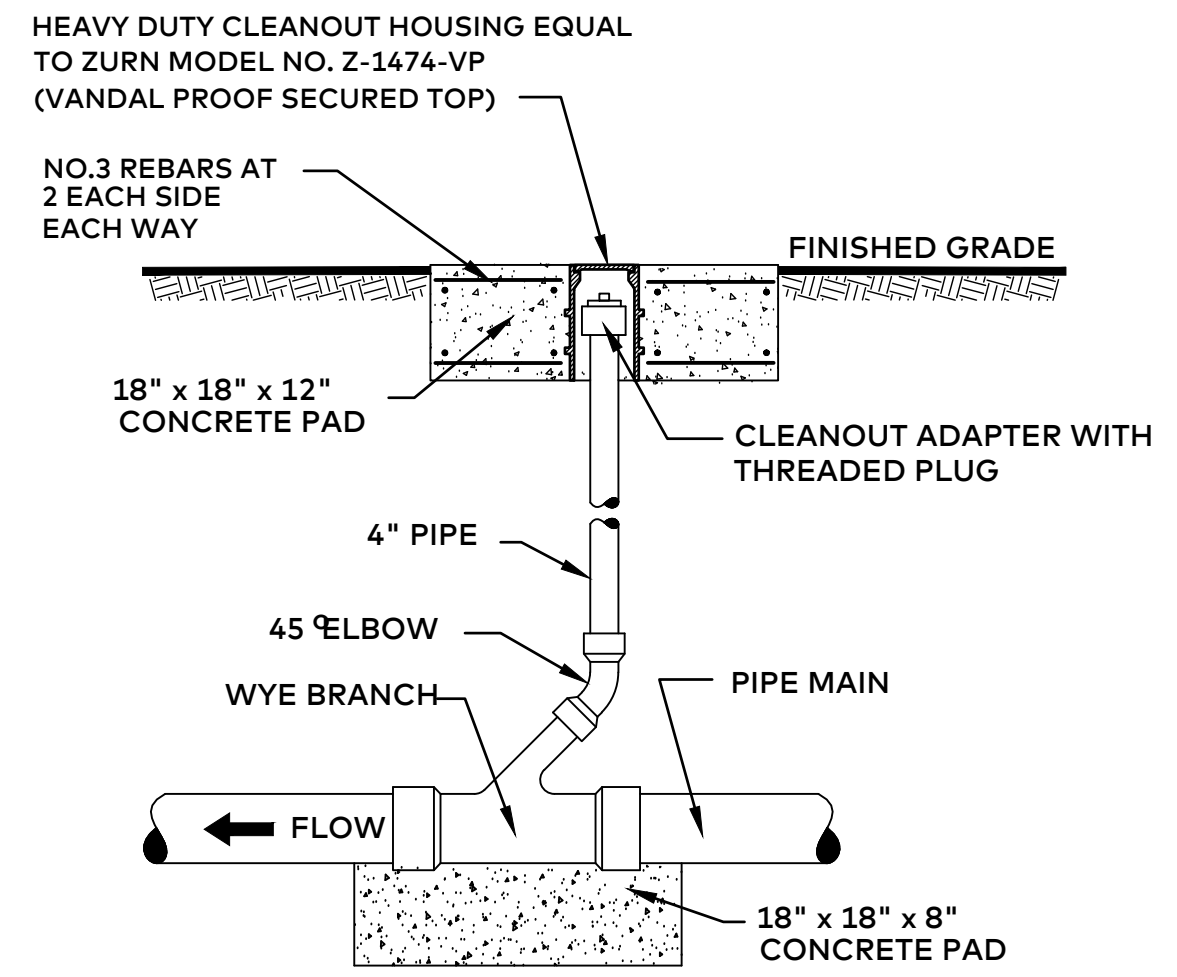

**TYPICAL DETAIL- CLEANOUT**  
NOT TO SCALE

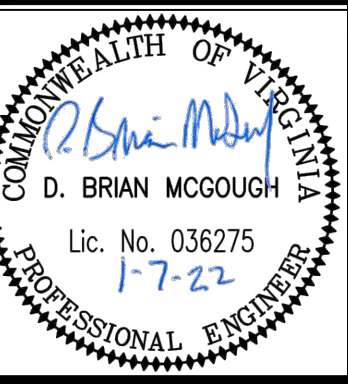

TOWN OF RICHLANDS - 4.0 MGD WWTP  
UPGRADES AND IMPROVEMENTS

MISCELLANEOUS DETAILS

Purpose of Document Issue	
ISSUED FOR DRG REVIEW	
ISSUED FOR TOWN REVIEW	
ISSUED FOR DRG REVIEW	
ISSUED FOR BIDS	
Date	
03-31-21	
04-15-21	
06-21-21	
01-07-22	
No.	

Designed	DBM
Drawn	ESB
Checked	
Date	JULY 2020




Project No.  
**14249**



Sheet No.

**C003**



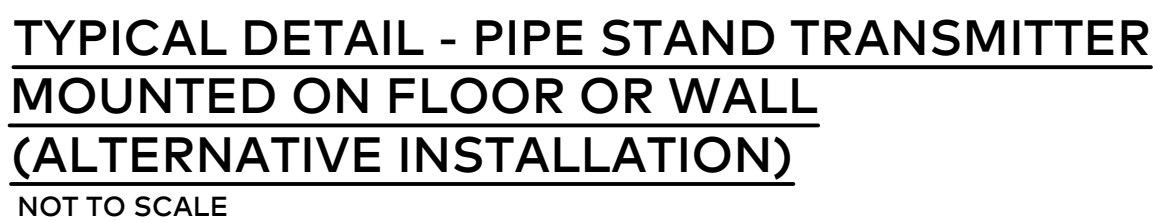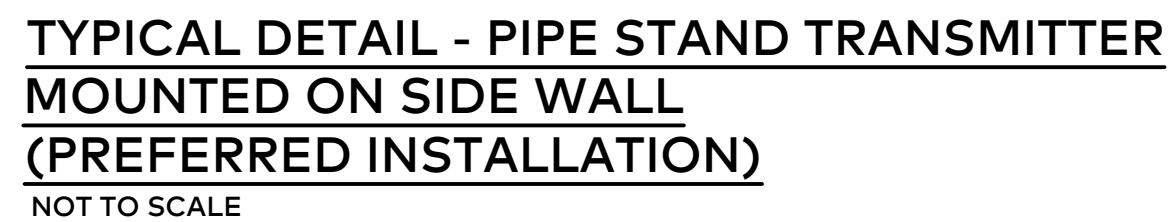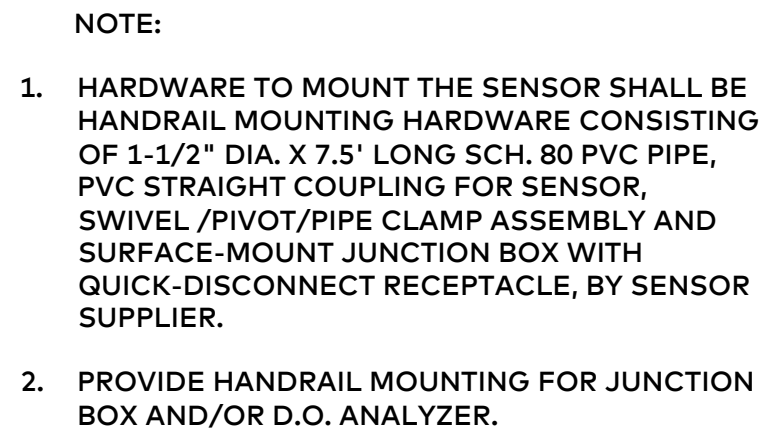


NOT TO SCALE



**NOTES:**

1. WALL PIPE REQUIRED FOR ALL WALL AND SLAB PENETRATIONS ON NEW CAST IN PLACE CONCRETE.
2. CUT PE PIPE FLUSH WITH WALL OR SLAB WHEN PIPE RUN ENDS AT WALL OR SLAB.
3. FLANGED WALL PIPE MAY BE CAST FLUSH WITH THE WALL IF FLANGE BOLTS ARE PRE-THREADED IN PLACE.
4. DETAIL APPLICABLE FOR PRESSURE PIPING.

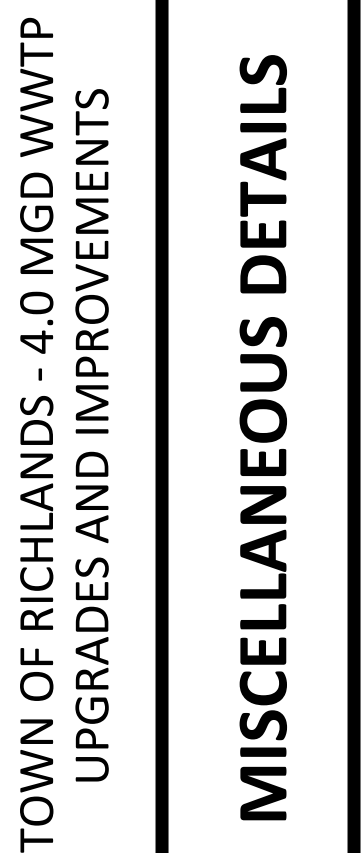Sheet No.

C004



BLOWER SCHEDULE

BLOWER NUMBER	DESIGNATION	CAPACITY (SCFM)	DISCHARGE PRESSURE (PSI)	MAXIMUM MOTOR (HP)	OPERATING SPEED (RPM)	BLOWER & STARTER TYPE
B10	GRIT CHAMBER	200	4.5	10	2510	POSITIVE DISPLACEMENT/VFD
B20	GRIT CHAMBER	200	4.5	10	2510	POSITIVE DISPLACEMENT/VFD
B30	POST AERATION	250	3.2	10	2950	POSITIVE DISPLACEMENT/VFD
B40	POST AERATION	250	3.2	10	2590	POSITIVE DISPLACEMENT/VFD

PUMP SCHEDULE


PUMP NUMBER	DESIGNATION	DESIGN CAPACITY (GPM)	DESIGN TDH (FT.)	MAX. MOTOR HP	MAX. OPERATING SPEED (R.P.M.)	PUMP TYPE	MOTOR TYPE
<del>P10</del>	<del>MAIN INFLUENT</del>	<del>4225</del>	<del>30</del>	<del>60</del>	<del>2160</del>	<del>NON-CLOG DRY PIT SUBMERSIBLE</del>	<del>O.D.P.</del>
<del>P20</del>	<del>MAIN INFLUENT</del>	<del>4235</del>	<del>30</del>	<del>60</del>	<del>2160</del>	<del>NON-CLOG DRY PIT SUBMERSIBLE</del>	<del>O.D.P.</del>
<del>P30</del>	<del>MAIN INFLUENT</del>	<del>4225</del>	<del>30</del>	<del>60</del>	<del>2160</del>	<del>NON-CLOG DRY PIT SUBMERSIBLE</del>	<del>O.D.P.</del>
P40	GRIT	270	32	10	1000	GRIT SLURRY	O.D.P.
P50	GRIT	270	32	10	1000	GRIT SLURRY	O.D.P.
P60	PRIMARY SLUDGE	65	16	3	1130	NON-CLOG SUBMERSIBLE	SUBMERSIBLE
P70	PRIMARY SLUDGE	65	16	3	1130	NON-CLOG SUBMERSIBLE	SUBMERSIBLE
P80	SECONDARY SLUDGE (RECIRC.)	2600	43	50	1180	NON-CLOG DRY PIT SUBMERSIBLE	TEFC
P90	SECONDARY SLUDGE (RECIRC.)	2600	43	50	1180	NON-CLOG DRY PIT SUBMERSIBLE	TEFC
<del>P100</del>	<del>EFFLUENT</del>	<del>14000</del>	<del>0</del>	<del>60</del>	<del>500</del>	<del>VERTICAL MIXED FLOW PROPELLER</del>	<del>TEFC</del>
<del>P110</del>	<del>EFFLUENT</del>	<del>14000</del>	<del>0</del>	<del>60</del>	<del>500</del>	<del>VERTICAL MIXED FLOW PROPELLER</del>	<del>TEFC</del>
<del>P120</del>	<del>SLUDGE TRANSFER</del>	<del>00 (MAX)</del>	<del>100 (MAX)</del>	<del>3</del>	<del>1200</del>	<del>PLUNGER SLUDGE</del>	<del>O.D.P.</del>
<del>P130</del>	<del>SLUDGE TRANSFER</del>	<del>00 (MAX)</del>	<del>100 (MAX)</del>	<del>3</del>	<del>1200</del>	<del>PLUNGER SLUDGE</del>	<del>O.D.P.</del>
<del>P140</del>	<del>SLUDGE RECIRCULATION</del>	<del>350</del>	<del>40</del>	<del>15</del>	<del>1750</del>	<del>NON-CLOG DRY PIT SUBMERSIBLE WITH RECESSED IMPELLER</del>	<del>O.D.P.</del>
<del>P150</del>	<del>SLUDGE TRANSFER (BIG)</del>	<del>350</del>	<del>40</del>	<del>15</del>	<del>1750</del>	<del>NON-CLOG DRY PIT SUBMERSIBLE WITH RECESSED IMPELLER</del>	<del>O.D.P.</del>
P160	PROCESSED SLUDGE	75	92	3	370	PROGRESSIVE CAVITY SLUDGE	O.D.P.
P170	PROCESSED SLUDGE	75	92	3	370	PROGRESSIVE CAVITY SLUDGE	O.D.P.
<del>P180</del>	<del>NOT USED</del>						
P190	NONPOTABLE WATER	160	260	20	3530	CLOSED IMPELLER	O.D.P.
P200	NONPOTABLE WATER	160	260	20	3530	CLOSED IMPELLER	O.D.P.
P210	SECONDARY SLUDGE (WASTE)	150	32	7.5	1170	NON-CLOG DRY PIT SUBMERSIBLE WITH RECESSED IMPELLER	TEFC
P220	SECONDARY SLUDGE (WASTE)	150	32	7.5	1170	NON-CLOG DRY PIT SUBMERSIBLE WITH RECESSED IMPELLER	TEFC
<del>P230</del>	<del>SUMP PUMP (DIGESTER)</del>	<del>67</del>	<del>15</del>	<del>0.5</del>	<del>1725</del>	<del>NON-CLOG SUBMERSIBLE</del>	<del>SUBMERSIBLE</del>
<del>P240</del>	<del>SUMP PUMP (MAIN P.S.)</del>	<del>50</del>	<del>20</del>	<del>0.5</del>	<del>1725</del>	<del>NON-CLOG SUBMERSIBLE</del>	<del>SUBMERSIBLE</del>
P250	SUMP PUMP (GRIT BLDG.)	50	20	0.5	1725	NON-CLOG SUBMERSIBLE	SUBMERSIBLE
P260	SUMP PUMP (SEC. P.S.)	50	20	0.5	1725	NON-CLOG SUBMERSIBLE	SUBMERSIBLE
<del>P270</del>	<del>LIME PUMP (GRAVITY THICKENER)</del>	<del>5</del>	<del>25</del>	<del>0.5</del>	<del>2000</del>	<del>CENTRIFUGAL</del>	<del>O.D.P.</del>
<del>P280</del>	<del>LIME PUMP (AERATION BASIN)</del>	<del>5</del>	<del>20</del>	<del>0.33</del>	<del>2000</del>	<del>CENTRIFUGAL</del>	<del>O.D.P.</del>
<del>P290</del>	<del>NOT USED</del>						
<del>P300</del>	<del>RAVEN-DORAN LIFT STATION</del>	<del>1500</del>	<del>120</del>	<del>100</del>	<del>1770</del>	<del>NON-CLOG SUBMERSIBLE</del>	<del>SUBMERSIBLE</del>
<del>P310</del>	<del>RAVEN-DORAN LIFT STATION</del>	<del>1500</del>	<del>120</del>	<del>100</del>	<del>1770</del>	<del>NON-CLOG SUBMERSIBLE</del>	<del>SUBMERSIBLE</del>
<del>P320</del>	<del>RAVEN-DORAN LIFT STATION</del>	<del>1500</del>	<del>120</del>	<del>100</del>	<del>1770</del>	<del>NON-CLOG SUBMERSIBLE</del>	<del>SUBMERSIBLE</del>

METER SCHEDULE

METER NUMBER	LOCATION	PROCESS FLUID	METER TYPE	METER SIZE (IN)	FLOW INDICATOR	FLOW RECORDER & TOTALIZER	MAXIMUM FLOW
M-10	GRIT BUILDING	GRIT	ULTRASONIC	6	X		270 GPM
M-11	PRIMARY CLARIFIERS	PRIMARY SLUDGE	ULTRASONIC	6	X		70 GPM
M-12	SECONDARY CLARIFIERS	WASTED SLUDGE	ULTRASONIC	6	X	X	150 GPM
<del>M-13</del>	<del>PLANT INFLUENT</del>	<del>WASTE WATER</del>	<del>ULTRASONIC</del>	<del>16</del>	<del>X</del>	<del>X</del>	<del>10 MGD</del>
<del>M-14</del>	<del>DIGESTER</del>	<del>THICKENED SLUDGE</del>	<del>ULTRASONIC</del>	<del>8</del>	<del>X</del>		<del>70 GPM</del>
M-15	SHOP BUILDING	THICKENED DIGESTED SLUDGE	ULTRASONIC	6	X	X	70 GPM
<del>M-16</del>	<del>PLANT EFFLUENT</del>	<del>TREATED SEWAGE</del>	<del>PARTIAL FLUME / ULTRASONIC</del>	<del>10</del>	<del>X</del>	<del>X</del>	<del>10 MGD</del>
<del>M-17</del>	<del>AERATION BASIN</del>	<del>WASTE WATER</del>	<del>ULTRASONIC</del>		<del>X</del>		<del>10 MGD</del>
<del>M-18</del>	<del>AERATION BASIN</del>	<del>WASTE WATER</del>	<del>ULTRASONIC</del>		<del>X</del>		<del>10 MGD</del>
<del>M-19</del>	<del>AERATION BASIN</del>	<del>WASTE WATER</del>	<del>ULTRASONIC</del>		<del>X</del>		<del>10 MGD</del>
M-20	RETURN SLUDGE SPLITTER BOX	RETURN SLUDGE	ULTRASONIC	10	X	X	10 MGD
M-21	RETURN SLUDGE SPLITTER BOX	RETURN SLUDGE	ULTRASONIC	10	X	X	10 MGD
M-22	RETURN SLUDGE SPLITTER BOX	RETURN SLUDGE	ULTRASONIC	10	X	X	10 MGD
M-23	RAVEN - DORAN FORCE MAIN	WASTE WATER	ULTRASONIC	12	X	X	1.5 MGD
M-24	SECONDARY CLARIFIER	RETURN SLUDGE	ULTRASONIC	14	X	X	10 MGD
<del>M-25</del>	<del>DIGESTER 1 GAS</del>	<del>METHANE</del>	<del>THERMAL GAS MASS FLOW</del>	<del>4</del>	<del>X</del>	<del>X</del>	<del>4000 SCFM</del>
<del>M-26</del>	<del>DIGESTER 2 GAS</del>	<del>METHANE</del>	<del>THERMAL GAS MASS FLOW</del>	<del>4</del>	<del>X</del>	<del>X</del>	<del>4000 SCFM</del>
<del>M-27</del>	<del>WASTE GAS</del>	<del>METHANE</del>	<del>THERMAL GAS MASS FLOW</del>	<del>4</del>	<del>X</del>	<del>X</del>	<del>4000 SCFM</del>

GATE SCHEDULE

GATE NUMBER	LOCATION	OPENING SIZE (W X H) (INCHES)	OPERATOR	REMARKS
<del>SG-1</del>	<del>INFLUENT PUMP STATION</del>	<del>30x36</del>	<del>HANDWHEEL</del>	<del>SELF-CONTAINED SLIDE GATE</del>
<del>SG-2</del>	<del>INFLUENT PUMP STATION</del>	<del>30x36</del>	<del>HANDWHEEL</del>	<del>SELF-CONTAINED SLIDE GATE</del>
<del>SG-3</del>	<del>MAIN P.S. WETWELL</del>	<del>30x30</del>	<del>HANDWHEEL W/FLOOR STAND</del>	<del>SLUICE GATE</del>
SG-4	MECH. BAR SCREEN	36x36	HANDWHEEL	SELF-CONTAINED SLIDE GATE
SG-5	MANUAL BAR SCREEN	36x36	HANDWHEEL	SELF-CONTAINED SLIDE GATE
<del>SG-6</del>	<del>DELETED</del>			
<del>SG-7</del>	<del>DELETED</del>			
SG-8	INFLUENT GRIT CHAMBER	36x36	HANDWHEEL	SELF-CONTAINED SLIDE GATE
SG-9	INFLUENT GRIT CHAMBER	36x36	HANDWHEEL	SELF-CONTAINED SLIDE GATE
<del>SG-10</del>	<del>NOT USED</del>			
<del>SG-11</del>	<del>NOT USED</del>			
<del>SG-12</del>	<del>NOT USED</del>			
<del>SG-13</del>	<del>NOT USED</del>			
<del>SG-14</del>	<del>INFLUENT POST AERATION</del>	<del>30x30</del>	<del>HANDWHEEL</del>	<del>SELF-CONTAINED SLIDE GATE</del>
<del>SG-15</del>	<del>INFLUENT POST AERATION</del>	<del>30x30</del>	<del>HANDWHEEL</del>	<del>SELF-CONTAINED SLIDE GATE</del>
<del>SG-16</del>	<del>PLANT EFFLUENT</del>	<del>30x36</del>	<del>ELECTRIC</del>	<del>SLUICE GATE W/WALL THIMBLE FOR 30" PIPE</del>
<del>SG-17</del>	<del>INFLUENT AERATION BASIN</del>	<del>30x30</del>	<del>HANDWHEEL W/FLOOR STAND</del>	<del>SLUICE GATE W/WALL THIMBLE FOR 30" PIPE</del>
<del>SG-18</del>	<del>INFLUENT AERATION BASIN</del>	<del>30x30</del>	<del>HANDWHEEL W/FLOOR STAND</del>	<del>SLUICE GATE W/WALL THIMBLE FOR 30" PIPE</del>
<del>SG-19</del>	<del>INFLUENT AERATION BASIN</del>	<del>30x30</del>	<del>HANDWHEEL W/FLOOR STAND</del>	<del>SLUICE GATE W/WALL THIMBLE FOR 30" PIPE</del>
SG-20	INFLUENT SEC. CLARIFIER	30x30	HANDWHEEL W/FLOOR STAND	SLUICE GATE W/WALL THIMBLE FOR 30" PIPE
SG-21	INFLUENT SEC. CLARIFIER	30x30	HANDWHEEL W/FLOOR STAND	SLUICE GATE W/WALL THIMBLE FOR 30" PIPE
SG-22	INFLUENT SEC. CLARIFIER	30x30	HANDWHEEL W/FLOOR STAND	SLUICE GATE W/WALL THIMBLE FOR 30" PIPE

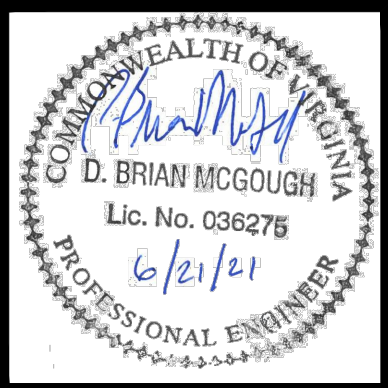

TOWN OF RICHLANDS - 4.0 MGD WWTP  
UPGRADES AND IMPROVEMENTS

MAJOR EQUIPMENT SCHEDULES

No.	Date	Purpose of Document Issue
	03-31-21	ISSUED FOR DEC REVIEW
	04-15-21	ISSUED FOR TOWN REVIEW
	06-21-21	ISSUED FOR DEC REVIEW
	01-07-22	ISSUED FOR BIDS
A	02-21-22	ADDENDUM NO. 4

Designed	DBM
Drawn	ESB
Checked	
Date	JULY 2020

Project No.	14249
-------------	-------




Sheet No.	C005
-----------	------







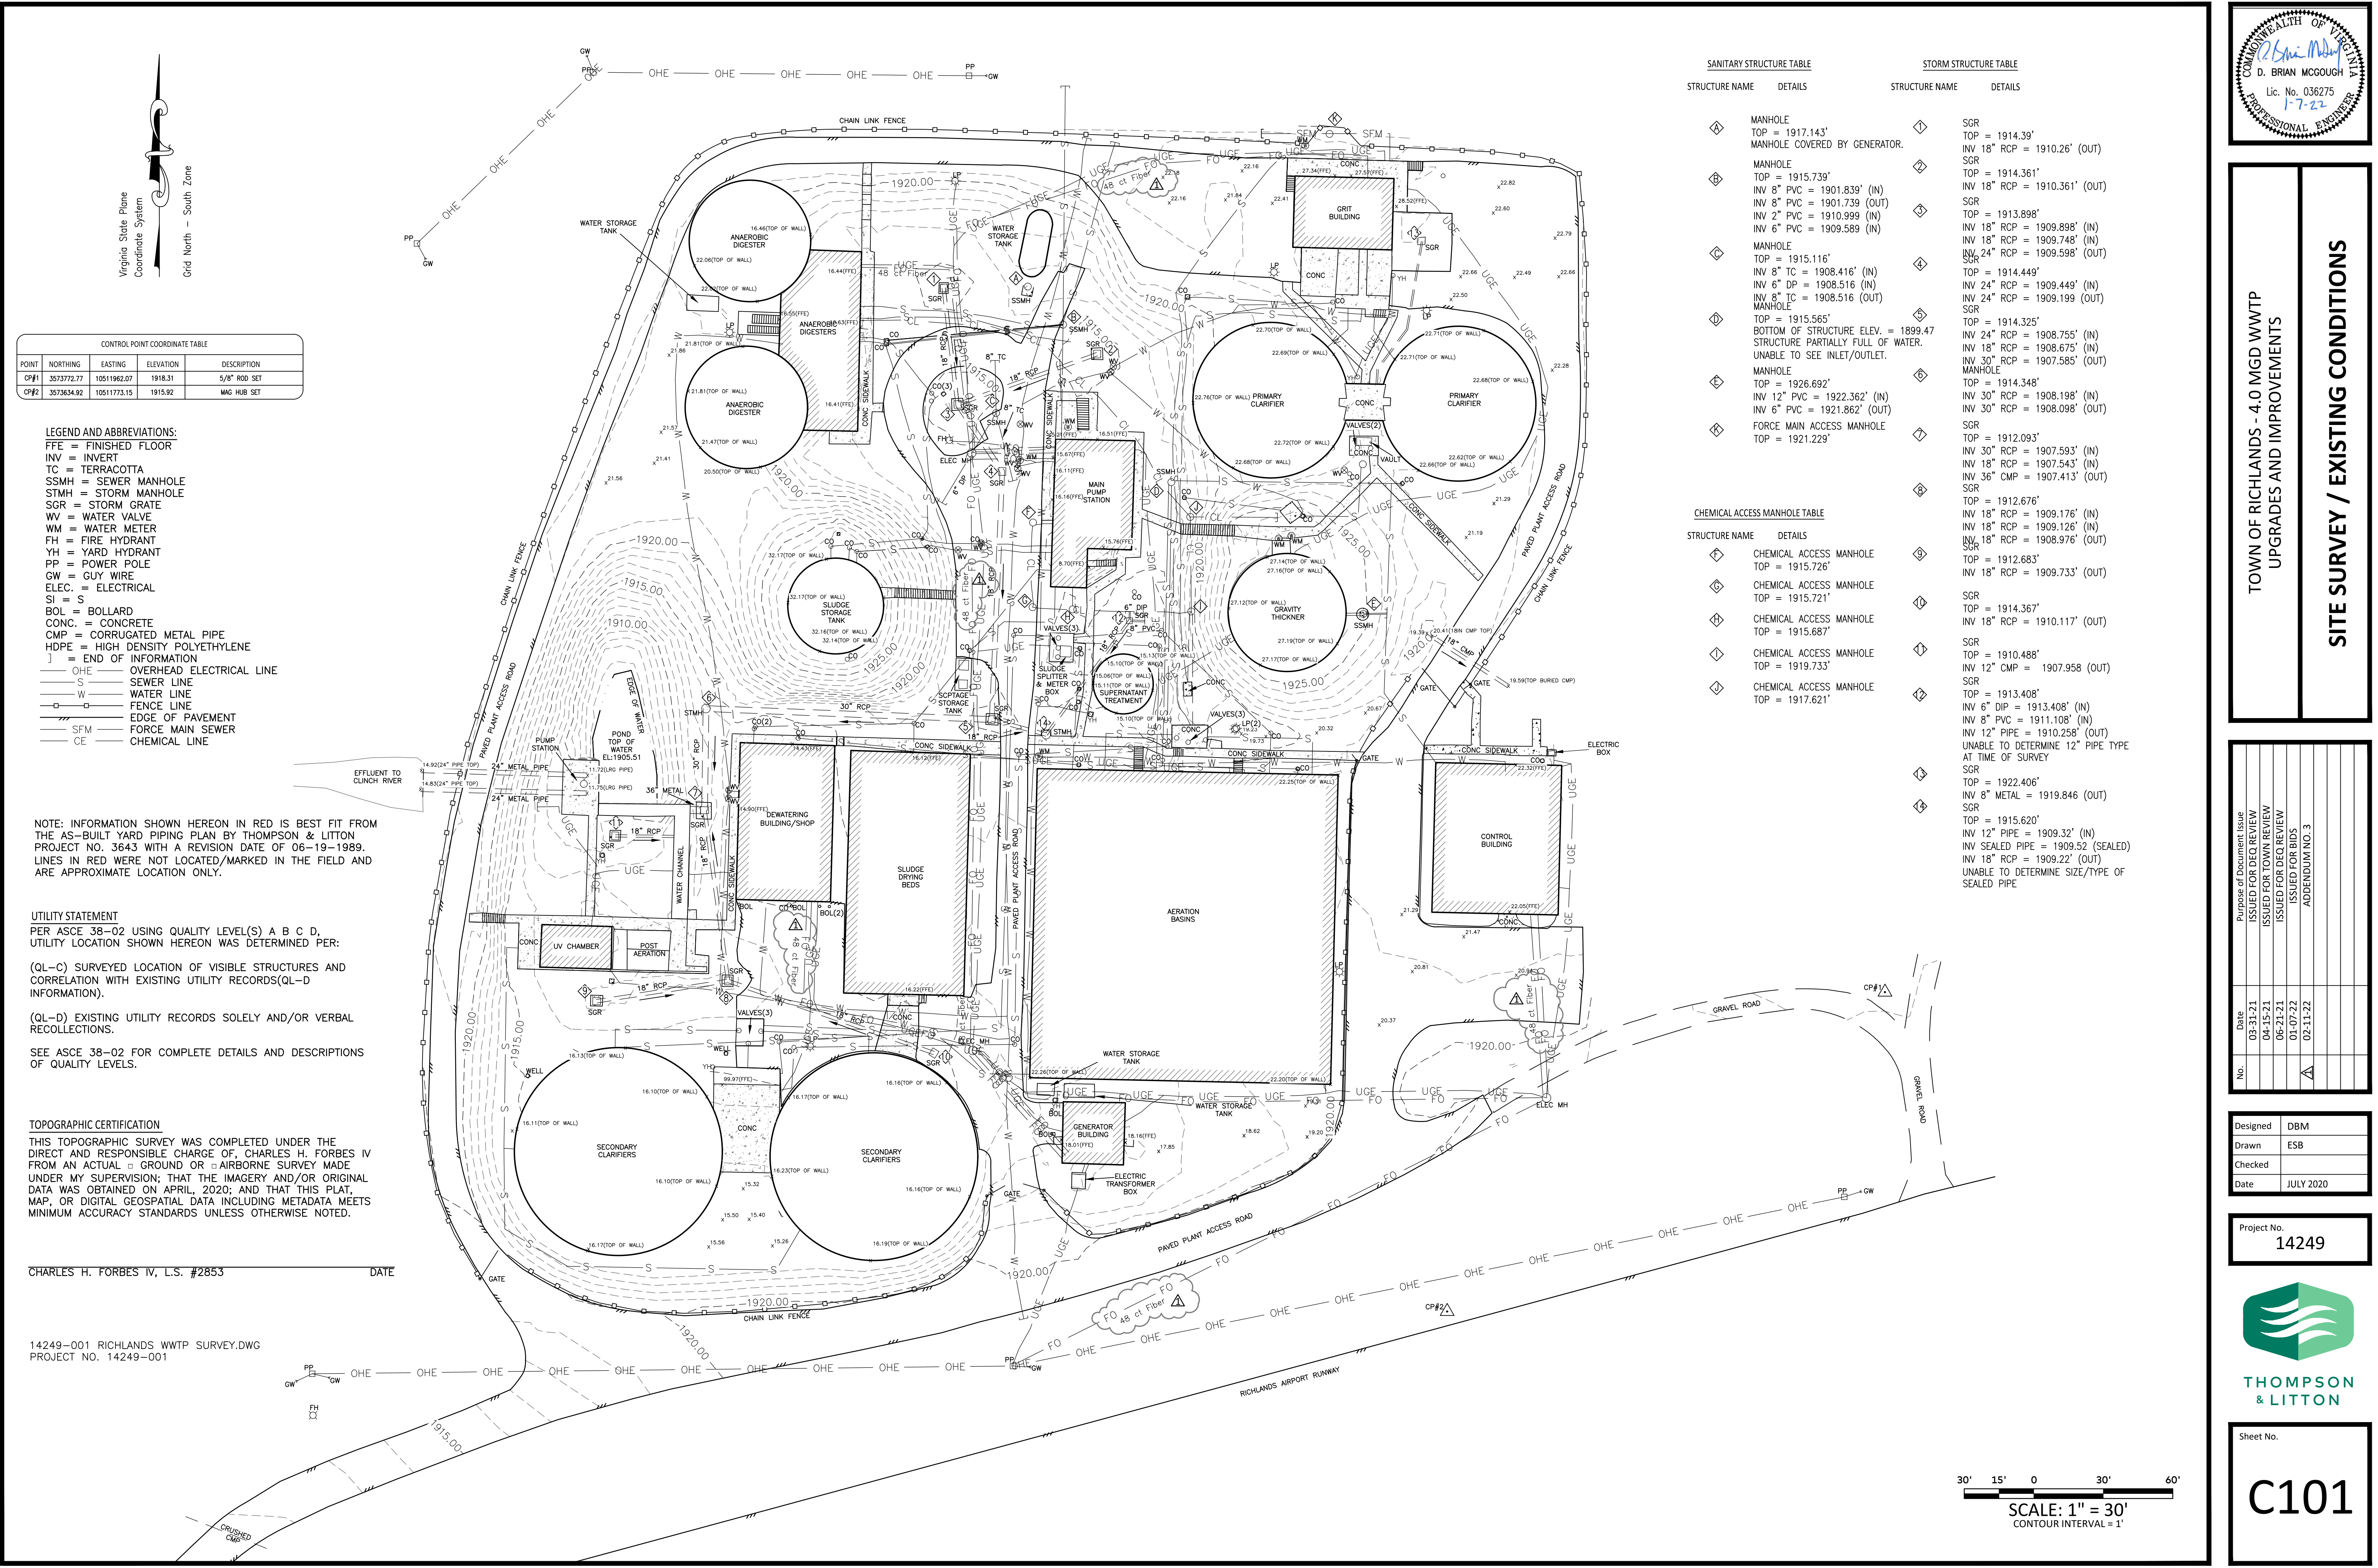

CONTROL POINT COORDINATE TABLE				
POINT	NORTHING	EASTING	ELEVATION	DESCRIPTION
CP#1	3573772.77	10511962.07	1918.31	5/8" ROD SET
CP#2	3573634.92	10511773.15	1915.92	WAG HUB SET

- LEGEND AND ABBREVIATIONS:
- FFE = FINISHED FLOOR
  - INV = INVERT
  - TC = TERRACOTTA
  - SSMH = SEWER MANHOLE
  - STMH = STORM MANHOLE
  - SGR = STORM GRATE
  - WV = WATER VALVE
  - WM = WATER METER
  - FH = FIRE HYDRANT
  - YH = YARD HYDRANT
  - PP = POWER POLE
  - GW = GUY WIRE
  - ELEC. = ELECTRICAL
  - SI = S
  - BOL = BOLLARD
  - CONC. = CONCRETE
  - CMP = CORRUGATED METAL PIPE
  - HDPE = HIGH DENSITY POLYETHYLENE
  - ] = END OF INFORMATION
  - OHE = OVERHEAD ELECTRICAL LINE
  - S = SEWER LINE
  - W = WATER LINE
  - F = FENCE LINE
  - P = EDGE OF PAVEMENT
  - SFM = FORCE MAIN SEWER
  - CE = CHEMICAL LINE

NOTE: INFORMATION SHOWN HEREON IN RED IS BEST FIT FROM THE AS-BUILT YARD PIPING PLAN BY THOMPSON & LITTON PROJECT NO. 3643 WITH A REVISION DATE OF 06-19-1989. LINES IN RED WERE NOT LOCATED/MARKED IN THE FIELD AND ARE APPROXIMATE LOCATION ONLY.

UTILITY STATEMENT  
PER ASCE 38-02 USING QUALITY LEVEL(S) A B C D,  
UTILITY LOCATION SHOWN HEREON WAS DETERMINED PER:  
  
(QL-C) SURVEYED LOCATION OF VISIBLE STRUCTURES AND CORRELATION WITH EXISTING UTILITY RECORDS(QL-D INFORMATION).  
  
(QL-D) EXISTING UTILITY RECORDS SOLELY AND/OR VERBAL RECOLLECTIONS.  
  
SEE ASCE 38-02 FOR COMPLETE DETAILS AND DESCRIPTIONS OF QUALITY LEVELS.

TOPOGRAPHIC CERTIFICATION  
THIS TOPOGRAPHIC SURVEY WAS COMPLETED UNDER THE DIRECT AND RESPONSIBLE CHARGE OF, CHARLES H. FORBES IV FROM AN ACTUAL □ GROUND OR □ AIRBORNE SURVEY MADE UNDER MY SUPERVISION; THAT THE IMAGERY AND/OR ORIGINAL DATA WAS OBTAINED ON APRIL, 2020; AND THAT THIS PLAN, MAP OR DIGITAL GEOSPATIAL DATA INCLUDING METADATA MEETS MINIMUM ACCURACY STANDARDS UNLESS OTHERWISE NOTED.

CHARLES H. FORBES IV, L.S. #2853 DATE

14249-001 RICHLANDS WWTP SURVEY.DWG  
PROJECT NO. 14249-001

SANITARY STRUCTURE TABLE



STRUCTURE NAME	DETAILS
MANHOLE	TOP = 1917.143'
MANHOLE COVERED BY GENERATOR.	
MANHOLE	TOP = 1915.739'
INV 8" PVC = 1901.839' (IN)	
INV 8" DP = 1901.739' (OUT)	
INV 2" PVC = 1910.999' (IN)	
INV 6" PVC = 1909.589' (IN)	
MANHOLE	TOP = 1915.116'
INV 8" TC = 1908.416' (IN)	
INV 6" DP = 1908.516' (IN)	
INV 8" TC = 1908.516' (OUT)	
MANHOLE	TOP = 1915.565'
BOTTOM OF STRUCTURE ELEV. = 1899.47	
STRUCTURE PARTIALLY FULL OF WATER.	
UNABLE TO SEE INLET/OUTLET.	
MANHOLE	TOP = 1926.692'
INV 12" PVC = 1922.362' (IN)	
INV 6" PVC = 1921.862' (OUT)	
FORCE MAIN ACCESS MANHOLE	TOP = 1921.229'

CHEMICAL ACCESS MANHOLE TABLE

STRUCTURE NAME	DETAILS
CHEMICAL ACCESS MANHOLE	TOP = 1915.726'
CHEMICAL ACCESS MANHOLE	TOP = 1915.721'
CHEMICAL ACCESS MANHOLE	TOP = 1915.687'
CHEMICAL ACCESS MANHOLE	TOP = 1919.733'
CHEMICAL ACCESS MANHOLE	TOP = 1917.621'

STORM STRUCTURE TABLE

STRUCTURE NAME	DETAILS
SGR	TOP = 1914.39'
INV 18" RCP = 1910.26' (OUT)	
SGR	TOP = 1914.361'
INV 18" RCP = 1910.361' (OUT)	
SGR	TOP = 1913.898'
INV 18" RCP = 1909.898' (IN)	
INV 18" RCP = 1909.748' (IN)	
INV 24" RCP = 1909.598' (OUT)	
SGR	TOP = 1914.449'
INV 24" RCP = 1909.449' (IN)	
INV 24" RCP = 1909.199' (OUT)	
SGR	TOP = 1914.325'
INV 24" RCP = 1908.755' (IN)	
INV 18" RCP = 1908.675' (IN)	
INV 30" RCP = 1907.585' (OUT)	
MANHOLE	TOP = 1914.348'
INV 30" RCP = 1908.198' (IN)	
INV 30" RCP = 1908.098' (OUT)	
SGR	TOP = 1912.093'
INV 30" RCP = 1907.593' (IN)	
INV 18" RCP = 1907.543' (IN)	
INV 36" CMP = 1907.413' (OUT)	
SGR	TOP = 1912.676'
INV 18" RCP = 1909.176' (IN)	
INV 18" RCP = 1909.126' (IN)	
INV 18" RCP = 1908.976' (OUT)	
SGR	TOP = 1912.683'
INV 18" RCP = 1909.733' (OUT)	
SGR	TOP = 1914.367'
INV 18" RCP = 1910.117' (OUT)	
SGR	TOP = 1910.488'
INV 12" CMP = 1907.958' (OUT)	
SGR	TOP = 1913.408'
INV 6" DIP = 1913.408' (IN)	
INV 8" PVC = 1911.108' (IN)	
INV 12" PIPE = 1910.258' (OUT)	
UNABLE TO DETERMINE 12" PIPE TYPE AT TIME OF SURVEY	
SGR	TOP = 1922.406'
INV 8" METAL = 1919.846' (OUT)	
SGR	TOP = 1915.620'
INV 12" PIPE = 1909.32' (IN)	
INV SEALED PIPE = 1909.52' (SEALED)	
INV 18" RCP = 1909.22' (OUT)	
UNABLE TO DETERMINE SIZE/TYPE OF SEALED PIPE	

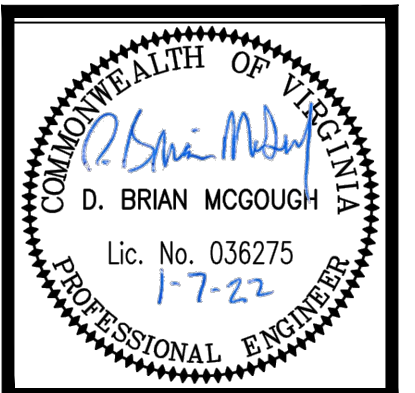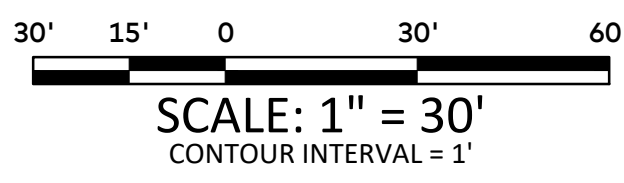


TOWN OF RICHLANDS - 4.0 MGD WWTP  
UPGRADES AND IMPROVEMENTS  
  
SITE SURVEY / EXISTING CONDITIONS

Purpose of Document Issue		Date	No.
ISSUED FOR DEC REVIEW	03-31-21		
ISSUED FOR TOWN REVIEW	04-15-21		
ISSUED FOR DEC REVIEW	06-21-21		
ISSUED FOR BIDS	01-07-22		
ADDENDUM NO. 3	02-11-22		

Designed	DBM
Drawn	ESB
Checked	
Date	JULY 2020

Project No.  
14249

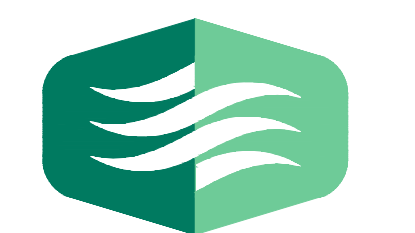

THOMPSON  
& LITTON

Sheet No.

C101



CONTROL POINT COORDINATE TABLE				
POINT	NORTHING	EASTING	ELEVATION	DESCRIPTION
CP#1	3573772.77	10511962.07	1918.31	5/8" ROD SET
CP#2	3573634.92	10511773.15	1915.92	WAG HUB SET

LEGEND AND ABBREVIATIONS:

FFE = FINISHED FLOOR  
 INW = INVERT  
 TC = TERRACOTTA  
 SSMH = SEWER MANHOLE  
 STMH = STORM MANHOLE  
 SGR = STORM GRATE  
 WV = WATER VALVE  
 WM = WATER METER  
 FH = FIRE HYDRANT  
 YH = YARD HYDRANT  
 PP = POWER POLE  
 GW = GUY WIRE  
 ELEC. = ELECTRICAL  
 SI = S  
 BOL = BOLLARD  
 CONC. = CONCRETE  
 CMP = CORRUGATED METAL PIPE  
 HDPE = HIGH DENSITY POLYETHYLENE  
 ] = END OF INFORMATION



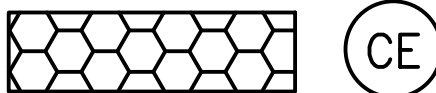
— OHE — OVERHEAD ELECTRICAL LINE  
 — S — SEWER LINE  
 — W — WATER LINE  
 — F — FENCE LINE  
 — SFM — FORCE MAIN SEWER  
 — CE — CHEMICAL LINE


### SUGGESTED SEQUENCE OF CONSTRUCTION

PHASE I:

- INSTALL CONSTRUCTION ENTRANCE.
- INSTALL SILT FENCE.
- INSTALL STORM DRAIN INLET PROTECTION.

### EROSION AND SEDIMENT CONTROL LEGEND

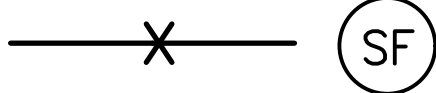SYMBOL	DESCRIPTION
	SILT FENCE
	STORM DRAIN INLET PROTECTION
	CONSTRUCTION ENTRANCE

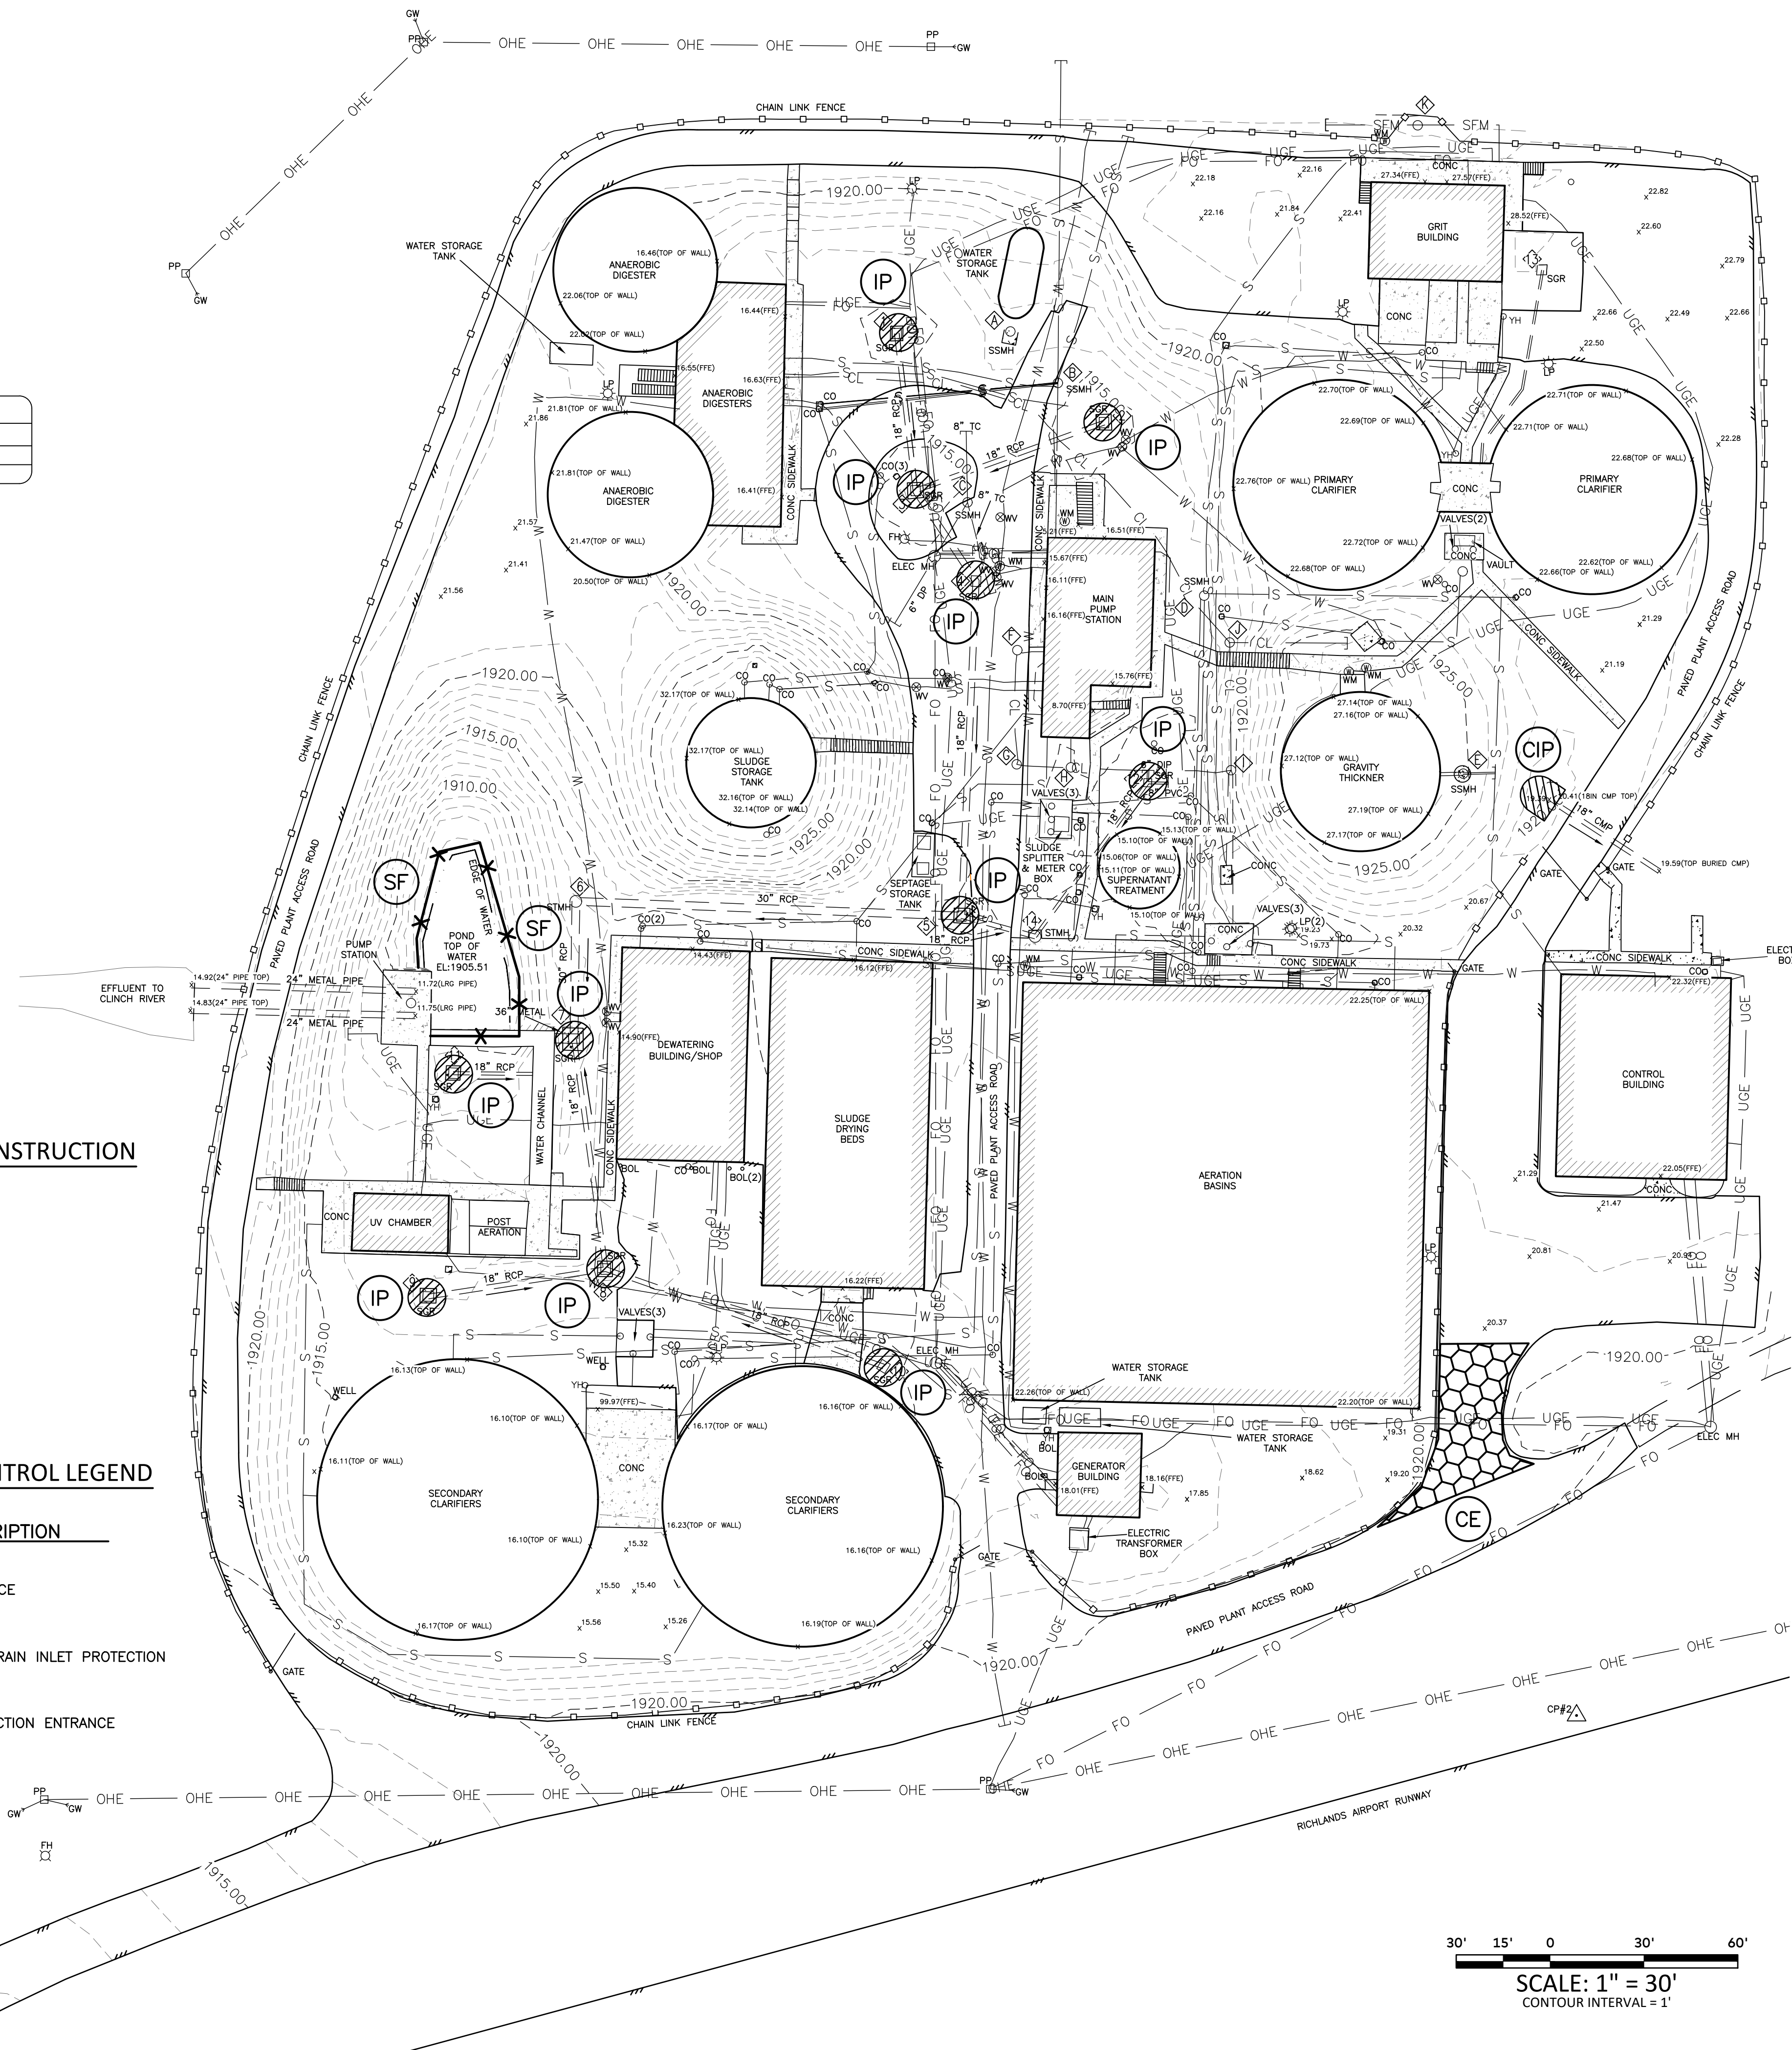

### EROSION AND SEDIMENT CONTROL NOTES

- EROSION AND SEDIMENT CONTROL SHALL BE IMPLEMENTED IN ACCORDANCE WITH ALL LOCAL REQUIREMENTS, THE EROSION AND SEDIMENT CONTROL PLAN FOR THIS PROJECT, AND THE LATEST EDITION OF THE "VIRGINIA EROSION AND SEDIMENT CONTROL HANDBOOK," BY THE DEPARTMENT OF ENVIRONMENTAL QUALITY, AS APPLICABLE.
- THE CONTRACTOR SHALL KEEP AT THE PROJECT SITE COPIES OF THE "VIRGINIA EROSION AND SEDIMENT CONTROL HANDBOOK" AND THE EROSION AND SEDIMENT CONTROL PLAN FOR THIS PROJECT.
- THE CONTRACTOR SHALL BE RESPONSIBLE FOR THE INSTALLATION OF ANY ADDITIONAL EROSION AND SEDIMENT CONTROL FACILITIES NECESSARY TO PREVENT EROSION AND SEDIMENTATION ON-SITE OR OFF-SITE AS DETERMINED BY THE PLAN-APPROVING AUTHORITY.
- ALL DISTURBED AREAS SHALL DRAIN TO APPROVED EROSION AND SEDIMENT CONTROL FACILITIES AT ALL TIMES DURING LAND DISTURBING ACTIVITIES UNTIL FINAL STABILIZATION IS ACHIEVED. ALL EROSION AND SEDIMENT CONTROL FACILITIES SHALL BE CONSTRUCTED AS A FIRST STEP IN ALL LAND DISTURBING ACTIVITIES AND SHALL BE MADE FUNCTIONAL BEFORE UPSLOPE LAND DISTURBANCE TAKES PLACE.
- ALL TEMPORARY EROSION CONTROL MEASURES MUST BE REMOVED WITHIN 30 DAYS. AFTER REACHING FINAL GRADE OR AFTER THEY ARE NO LONGER NEEDED, TRAPPED SEDIMENT AND DISTURBED AREAS RESULTING FROM THE DISPOSITION OF TEMPORARY PRACTICES MUST BE PERMANENTLY STABILIZED TO PREVENT FURTHER EROSION AND SEDIMENTATION.
- MATERIAL STOCKPILES SHALL BE CONTAINED WITHIN SEDIMENT BARRIERS. STOCKPILES THAT ARE TO REMAIN UNWORKED FOR MORE THAN 30 DAYS SHALL BE STABILIZED WITH TEMPORARY SEEDING WITHIN 14 DAYS AFTER THE COMPLETION OF STOCKPILING.
- TEMPORARY STABILIZATION SHALL BE INSTALLED WITHIN 14 DAYS ON DENUDED AREAS THAT ARE TO REMAIN DORMANT FOR GREATER THAN 30 DAYS. PERMANENT STABILIZATION SHALL BE APPLIED TO AREAS THAT ARE TO BE LEFT DORMANT FOR MORE THAN ONE YEAR. PERMANENT STABILIZATION SHALL BE INSTALLED WITHIN 7 DAYS OF FINAL STABILIZATION.
- ALL AREAS WHICH REQUIRE SEEDING SHALL BE "TOPSOILED" AND STABILIZED WITH MULCH IN ACCORDANCE WITH THE SPECIFICATIONS FOR THIS PROJECT.
- A PERMANENT VEGETATIVE COVER SHALL BE ESTABLISHED ON DENUDED AREAS NOT OTHERWISE PERMANENTLY STABILIZED. PERMANENT VEGETATION SHALL NOT BE CONSIDERED ESTABLISHED UNTIL A GROUND COVER IS ACHIEVED THAT, IN THE OPINION OF THE LOCAL PROGRAM ADMINISTRATOR OR HIS DESIGNATED AGENT, IS UNIFORM, MATURE ENOUGH TO SURVIVE, AND INHIBITS EROSION.
- CONCENTRATED RUNOFF SHALL NOT FLOW DOWN CUT OR FILL SLOPES UNLESS CONTAINED WITHIN AN ADEQUATE TEMPORARY OR PERMANENT CHANNEL, FLUME, OR SLOPE DRAIN STRUCTURE.
- CUT AND FILL SLOPES SHALL BE CONSTRUCTED IN A MANNER THAT WILL MINIMIZE EROSION. SLOPES THAT ARE FOUND TO BE ERODING EXCESSIVELY WITHIN ONE YEAR OF PERMANENT STABILIZATION SHALL BE PROVIDED WITH ADDITIONAL SLOPE STABILIZING MEASURES UNTIL THE PROBLEM IS CORRECTED.
- NO MORE THAN 500 LINEAR FEET OF TRENCH MAY BE OPEN AT ONE TIME.
- EXCAVATED MATERIAL SHALL BE PLACED ON THE UPHILL SIDE OF TRENCHES.
- PAVED OR PUBLIC ROAD SURFACES SHALL BE CLEANED THOROUGHLY AT THE END OF EACH DAY.
- EFFLUENT FROM DEWATERING OPERATIONS SHALL BE FILTERED OR PASSED THROUGH A DEWATERING STRUCTURE AND DISCHARGED IN A MANNER THAT DOES NOT ADVERSELY AFFECT FLOWING STREAMS OR OFF-SITE PROPERTY.
- WHERE CONSTRUCTION VEHICLE ACCESS ROUTES INTERSECT PAVED OR PUBLIC ROADS, A CONSTRUCTION ENTRANCE SHALL BE INSTALLED, AS NECESSARY, TO MINIMIZE THE TRANSPORT OF SEDIMENT BY VEHICULAR TRACKING ONTO THE PAVED SURFACE. PAVED OR PUBLIC ROAD SURFACES SHALL BE CLEANED THOROUGHLY AT THE END OF EACH DAY.




TOWN OF RICHLANDS - 4.0 MGD WWTP  
 UPGRADES AND IMPROVEMENTS

## SITE DEMOLITION AND EROSION & SEDIMENT CONTROL PLAN PHASE 1

Purpose of Document Issue		Date	No.
ISSUED FOR DDG REVIEW		03-31-21	
ISSUED FOR TOWN REVIEW		04-15-21	
ISSUED FOR DDG REVIEW		06-21-21	
ISSUED FOR BIDS		01-07-22	

Designed	DBM
Drawn	ESB
Checked	
Date	JULY 2020

Project No.	14249
-------------	-------

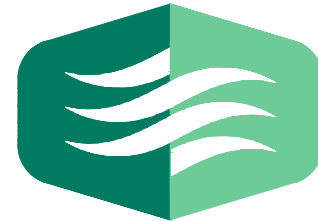


THOMPSON  
& LITTON


Sheet No.

C102





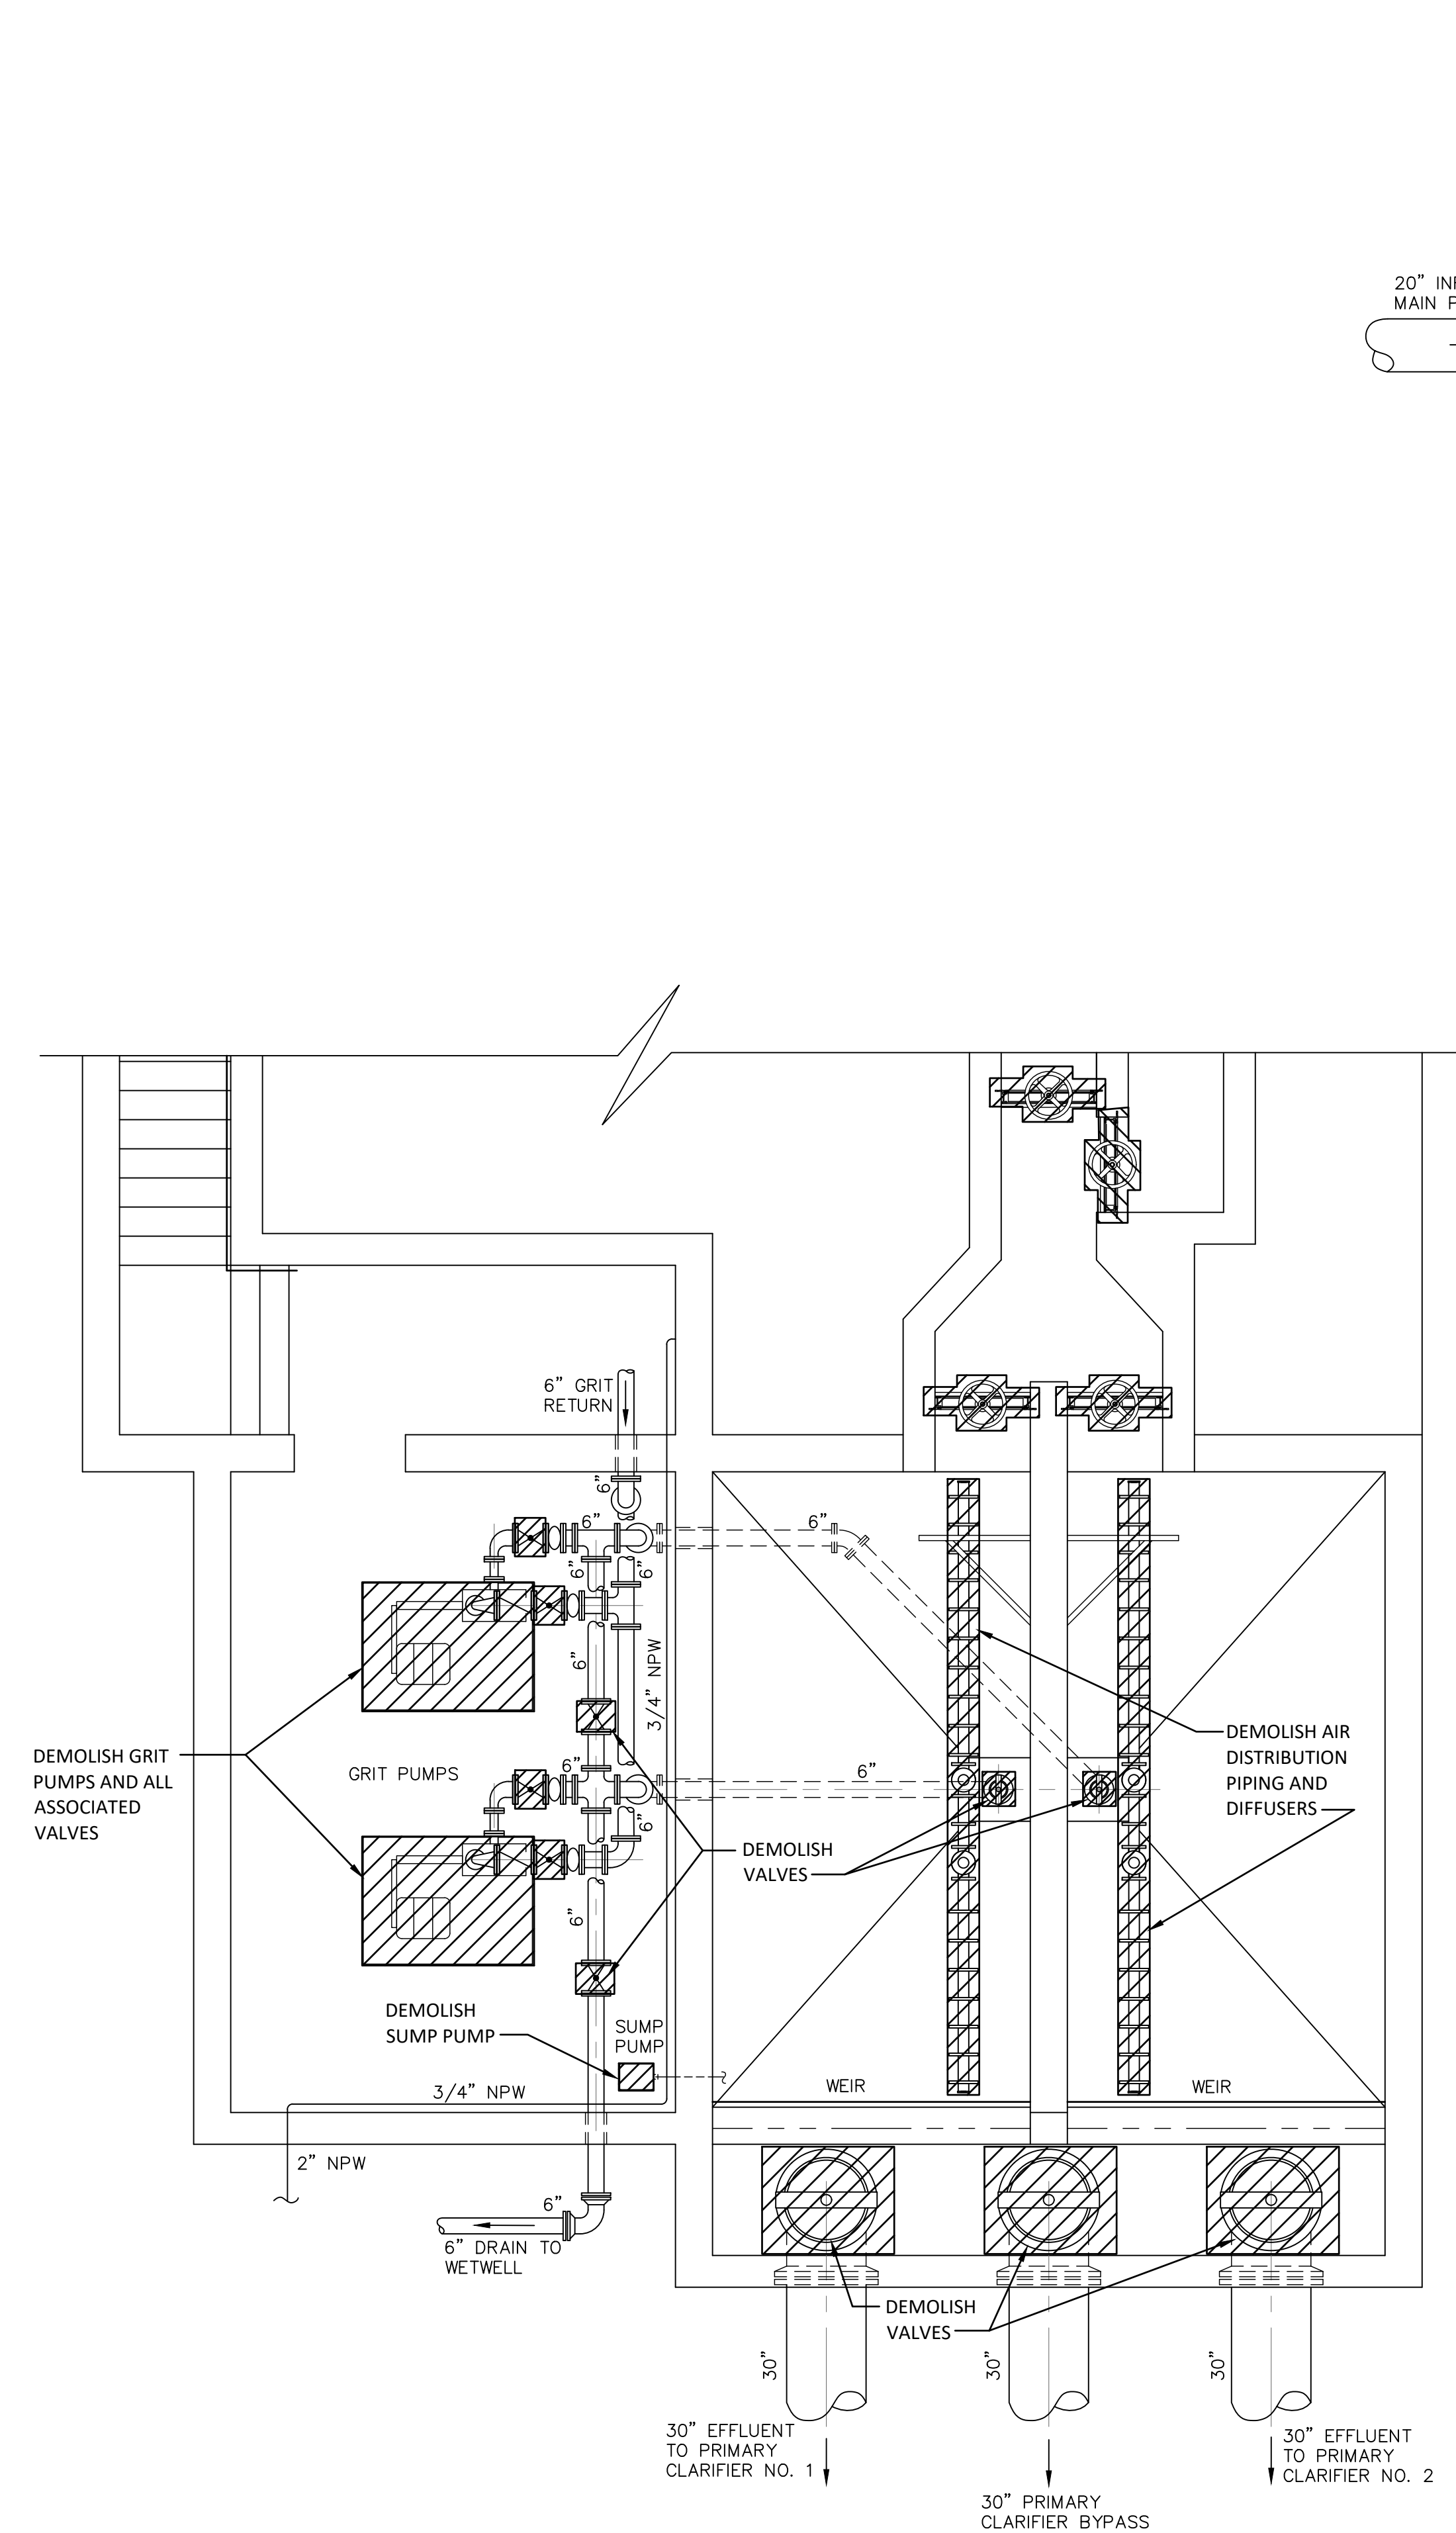

**LOWER FLOOR PLAN**  
SCALE: 1/4" = 1'-0"

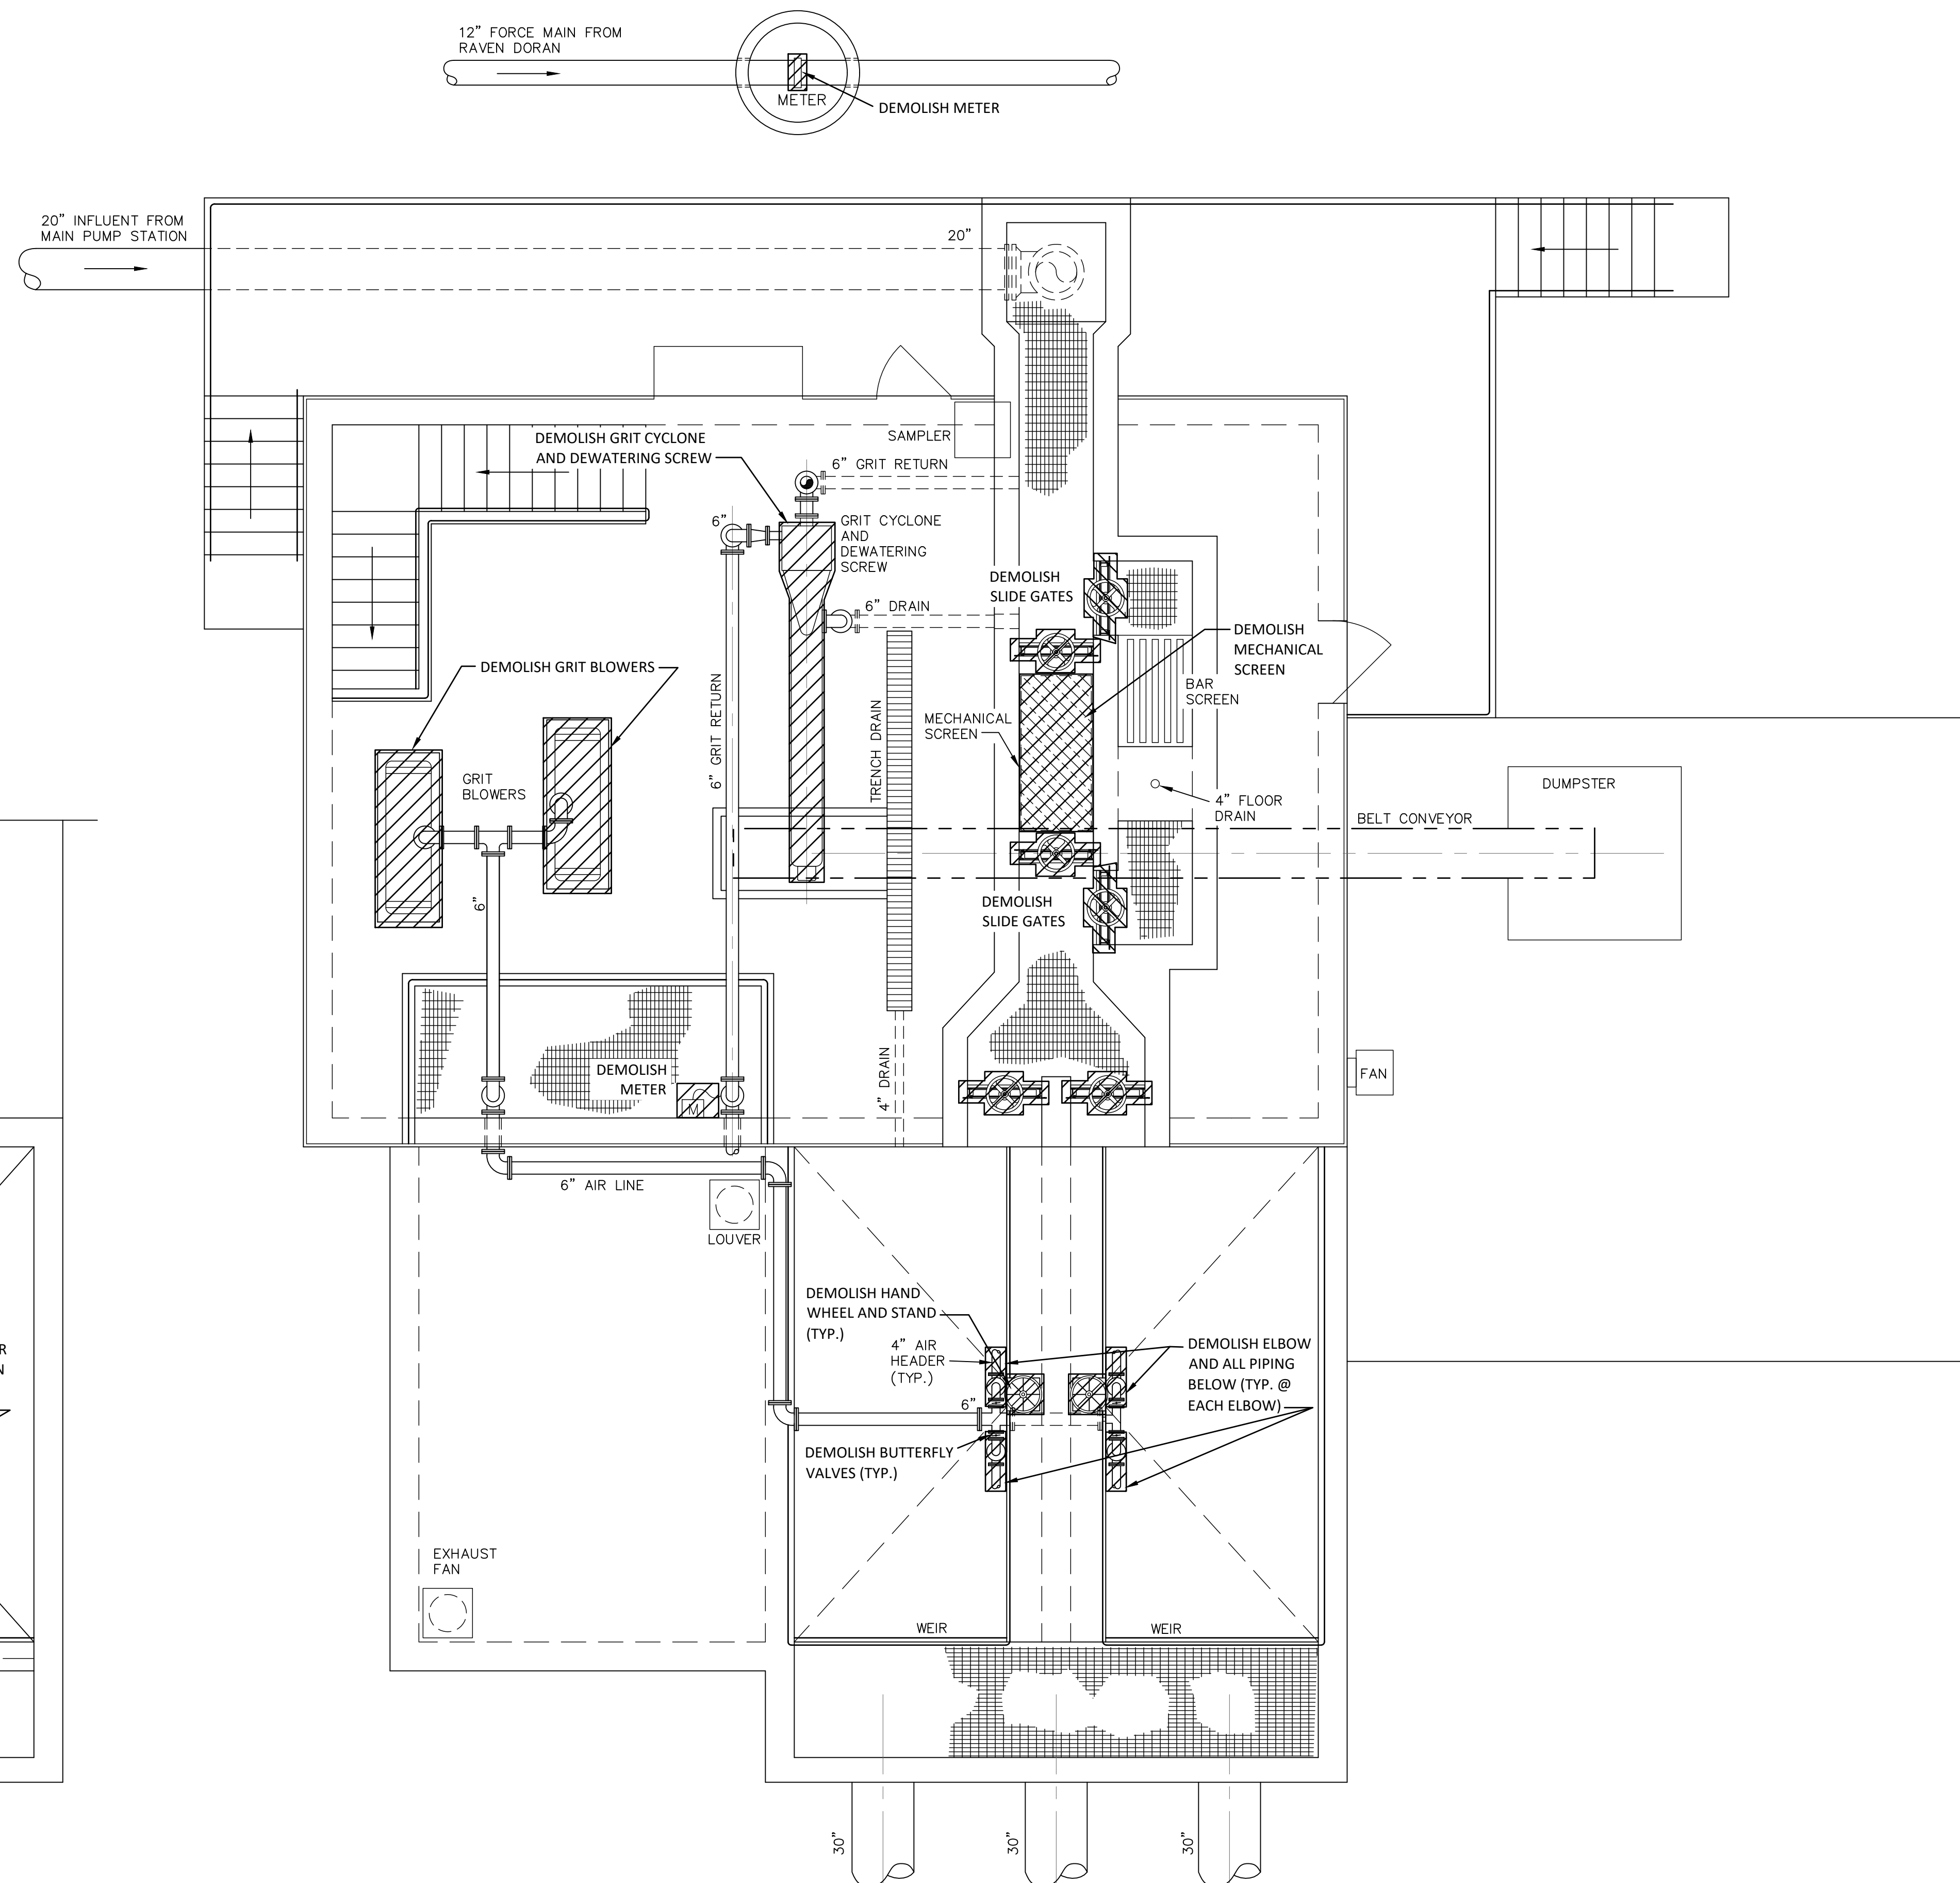

**UPPER FLOOR PLAN**  
SCALE: 1/4" = 1'-0"

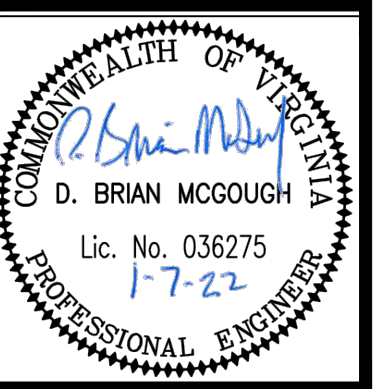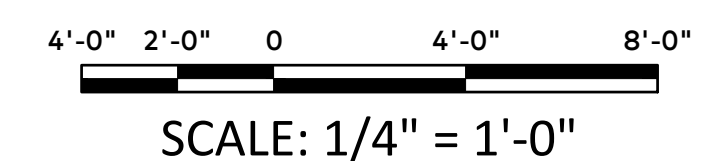


# TOWN OF RICHLANDS - 4.0 MGD WWTP UPGRADES AND IMPROVEMENTS

# PRELIMINARY TREATMENT BUILDING DEMOLITION PLAN

No.	Date	Purpose of Document Issue
	03-31-21	ISSUED FOR DEQ REVIEW
	04-15-21	ISSUED FOR DEQ REVIEW
	06-21-21	ISSUED FOR DEQ REVIEW
	01-07-22	ISSUED FOR BIDS

Designed	DBM
Drawn	ESB
Checked	
Date	JULY 2020

Project No.  
14249

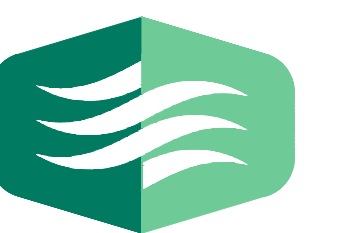


THOMPSON  
& LITTON

Sheet No.

# C202



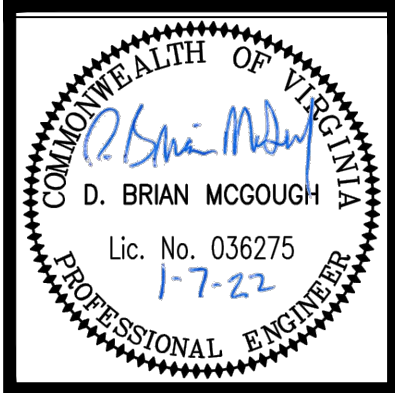

TOWN OF RICHLANDS - 4.0 MGD WWTP  
UPGRADES AND IMPROVEMENTS

SHOP BUILDING EQUIPMENT DEMOLITION PLAN

No.	Date	Purpose of Document Issue
	03-31-21	ISSUED FOR DEO REVIEW
	04-15-21	ISSUED FOR TOWN REVIEW
	06-21-21	ISSUED FOR DEO REVIEW
	01-07-22	ISSUED FOR BIDS


Designed	DBM
Drawn	ESB
Checked	
Date	JULY 2020

Project No.	14249
-------------	-------




Sheet No.

C209

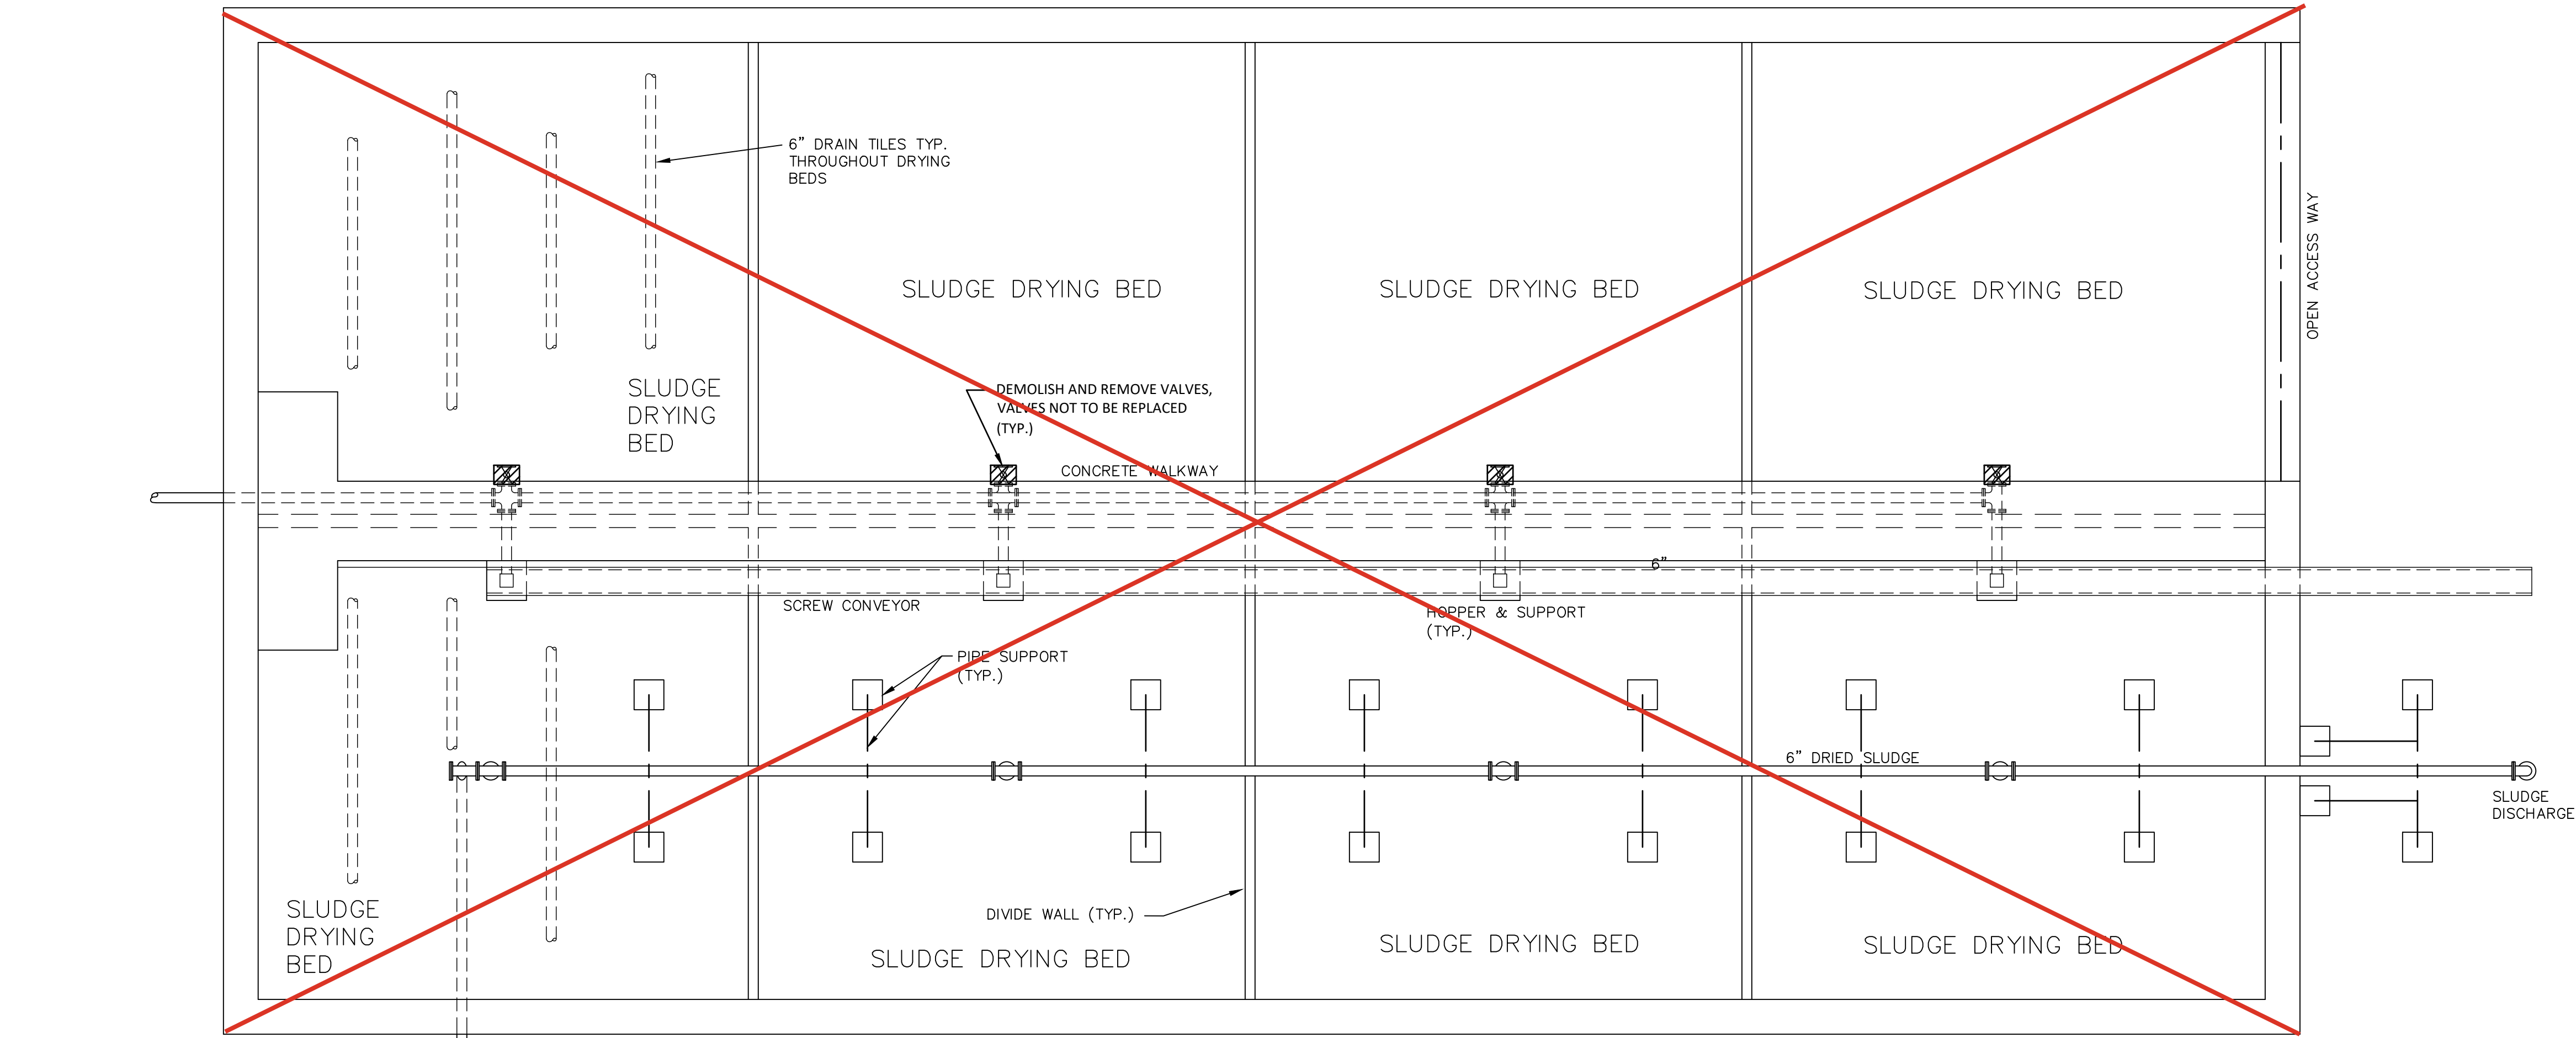


PLAN - SLUDGE DRYING BEDS  
SCALE: 3/16" = 1'-0"

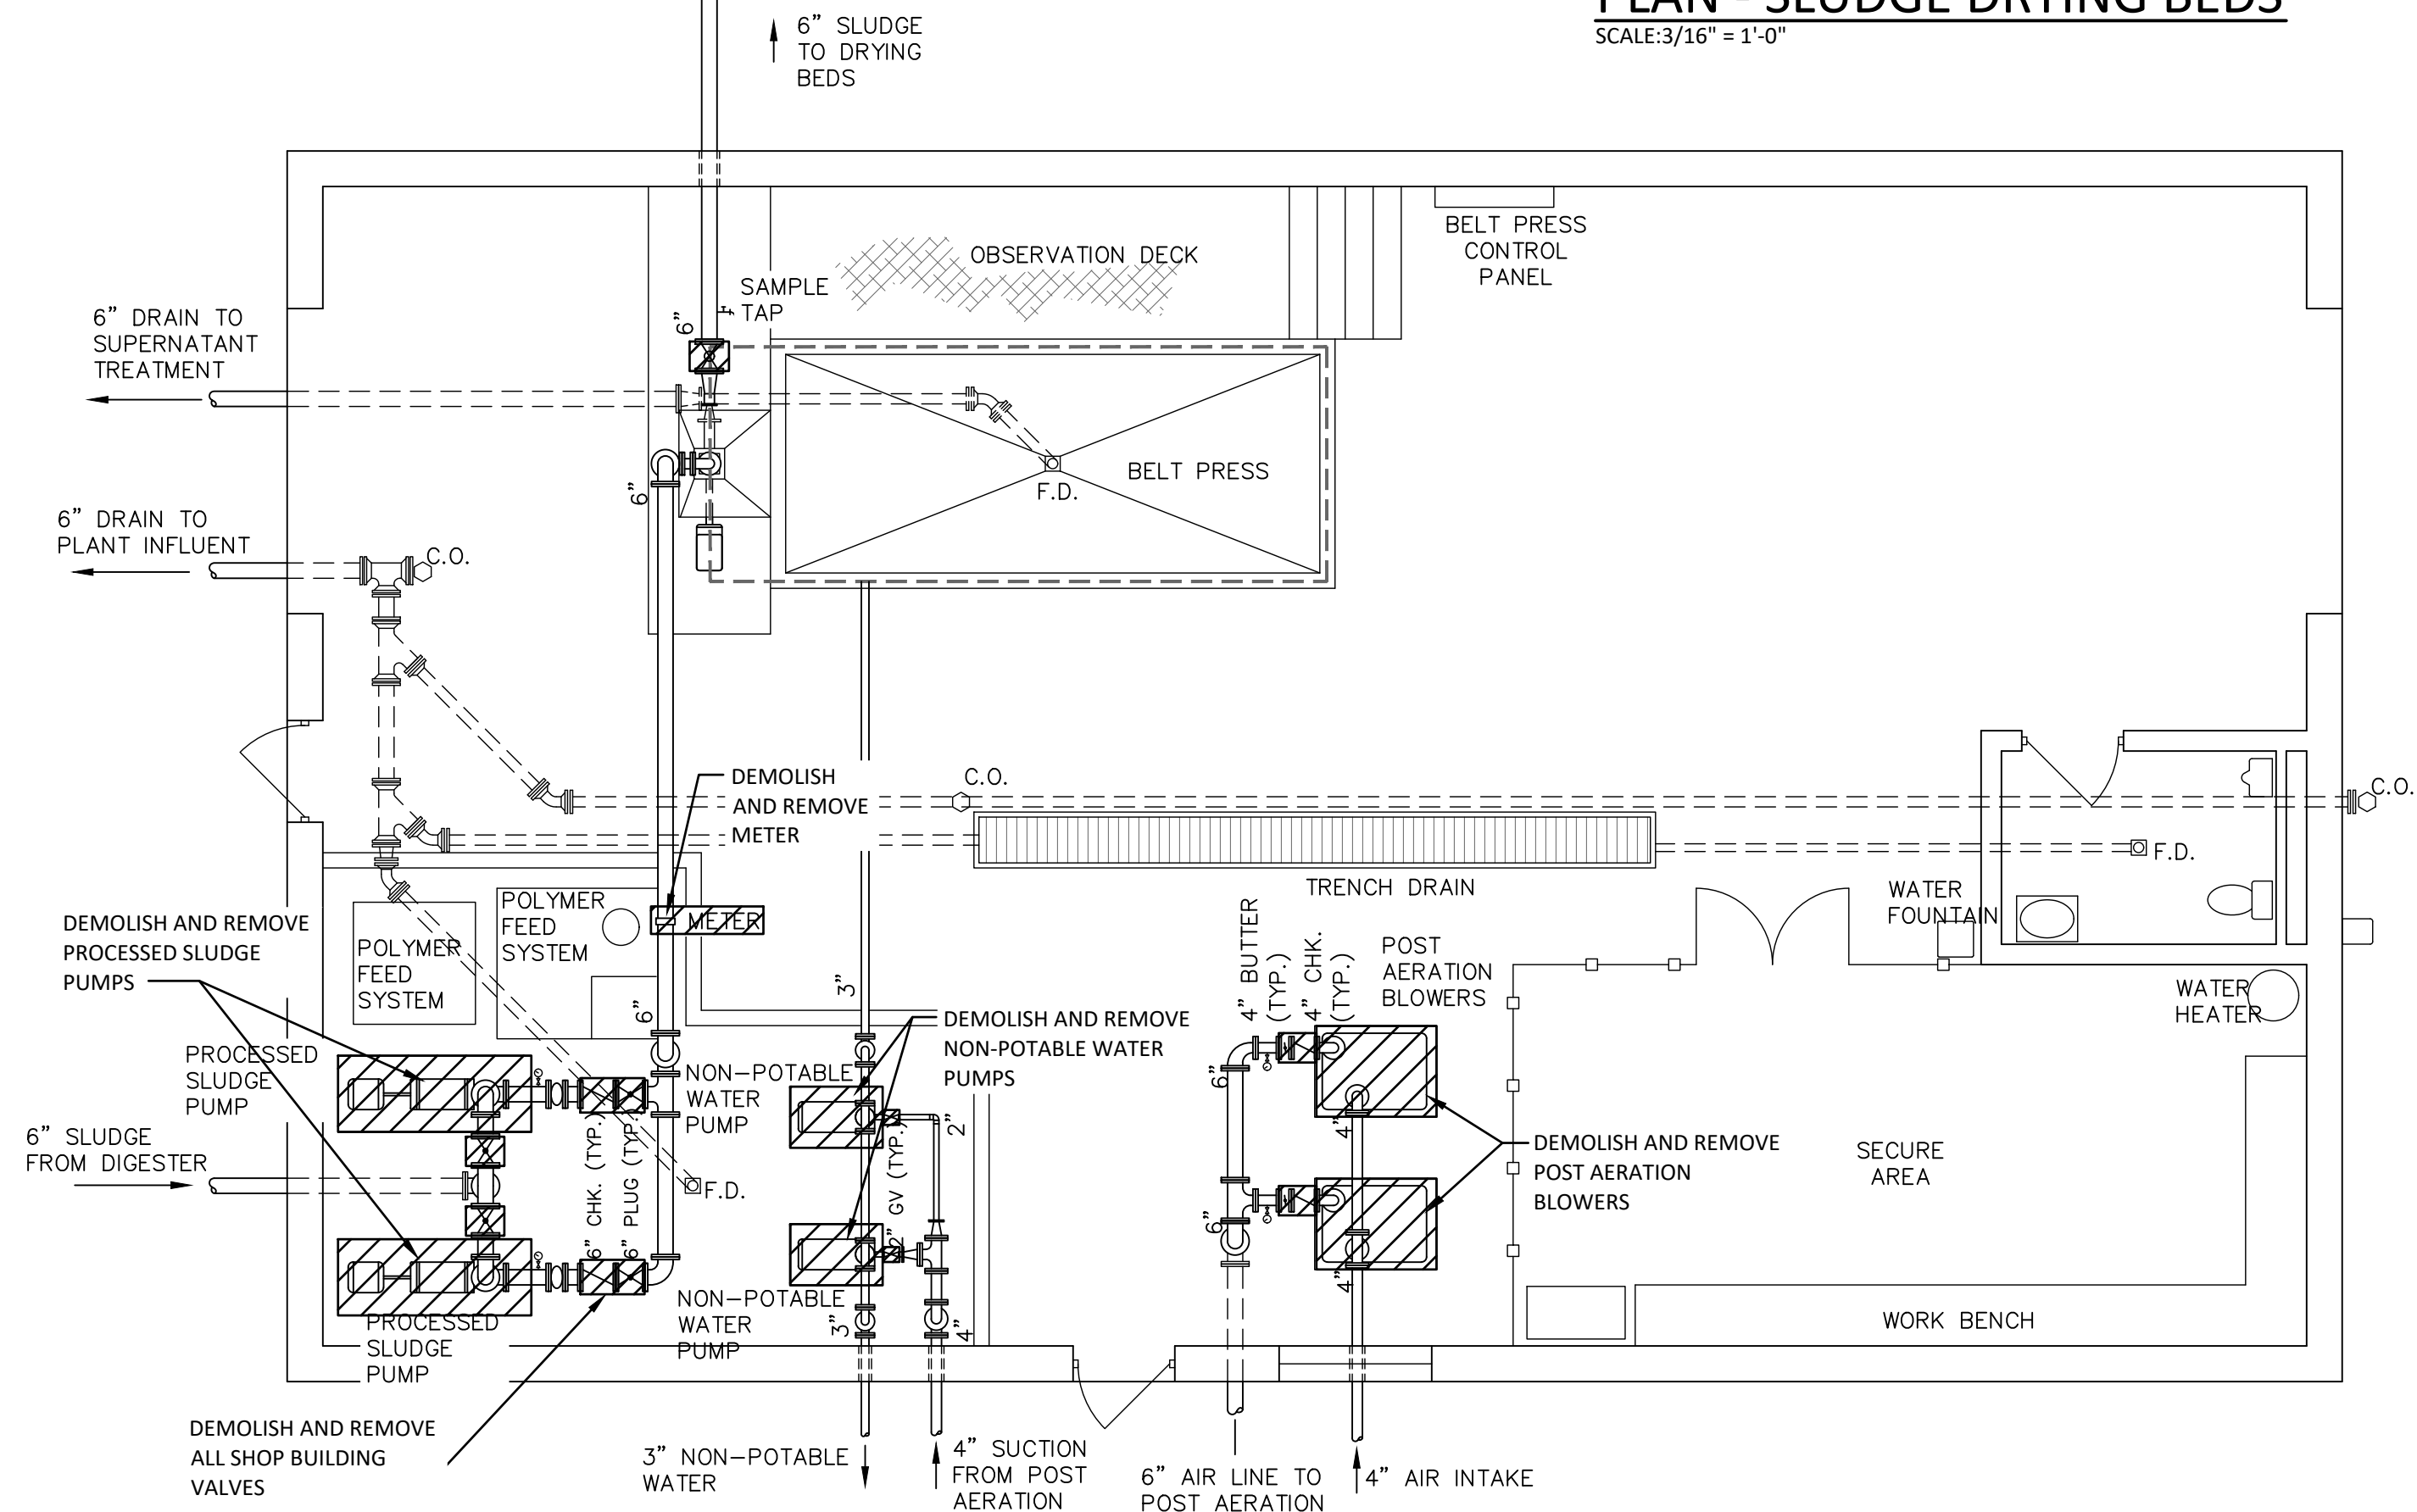

PLAN - SHOP BUILDING  
SCALE: 3/16" = 1'-0"

5'-4" 2'-8" 0 5'-4" 10'-8"  
SCALE: 3/16" = 1'-0"



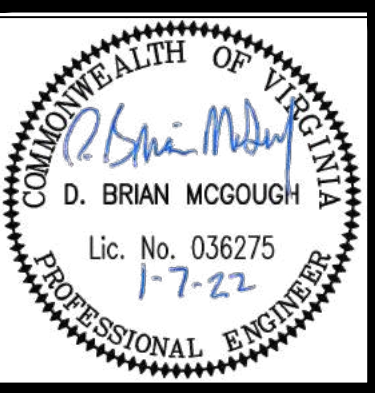

TOWN OF RICHLANDS - 4.0 MGD WWTP  
UPGRADES AND IMPROVEMENTS

PRELIMINARY TREATMENT BUILDING  
RENOVATION PLAN

Purpose of Document Issue	
No.	
Date	
03-31-21	ISSUED FOR DEO REVIEW
04-15-21	ISSUED FOR TOWN REVIEW
06-21-21	ISSUED FOR DEO REVIEW
01-07-22	ISSUED FOR BIDS


Designed	DBM
Drawn	ESB
Checked	
Date	JULY 2020

Project No.  
14249




Sheet No.

C401

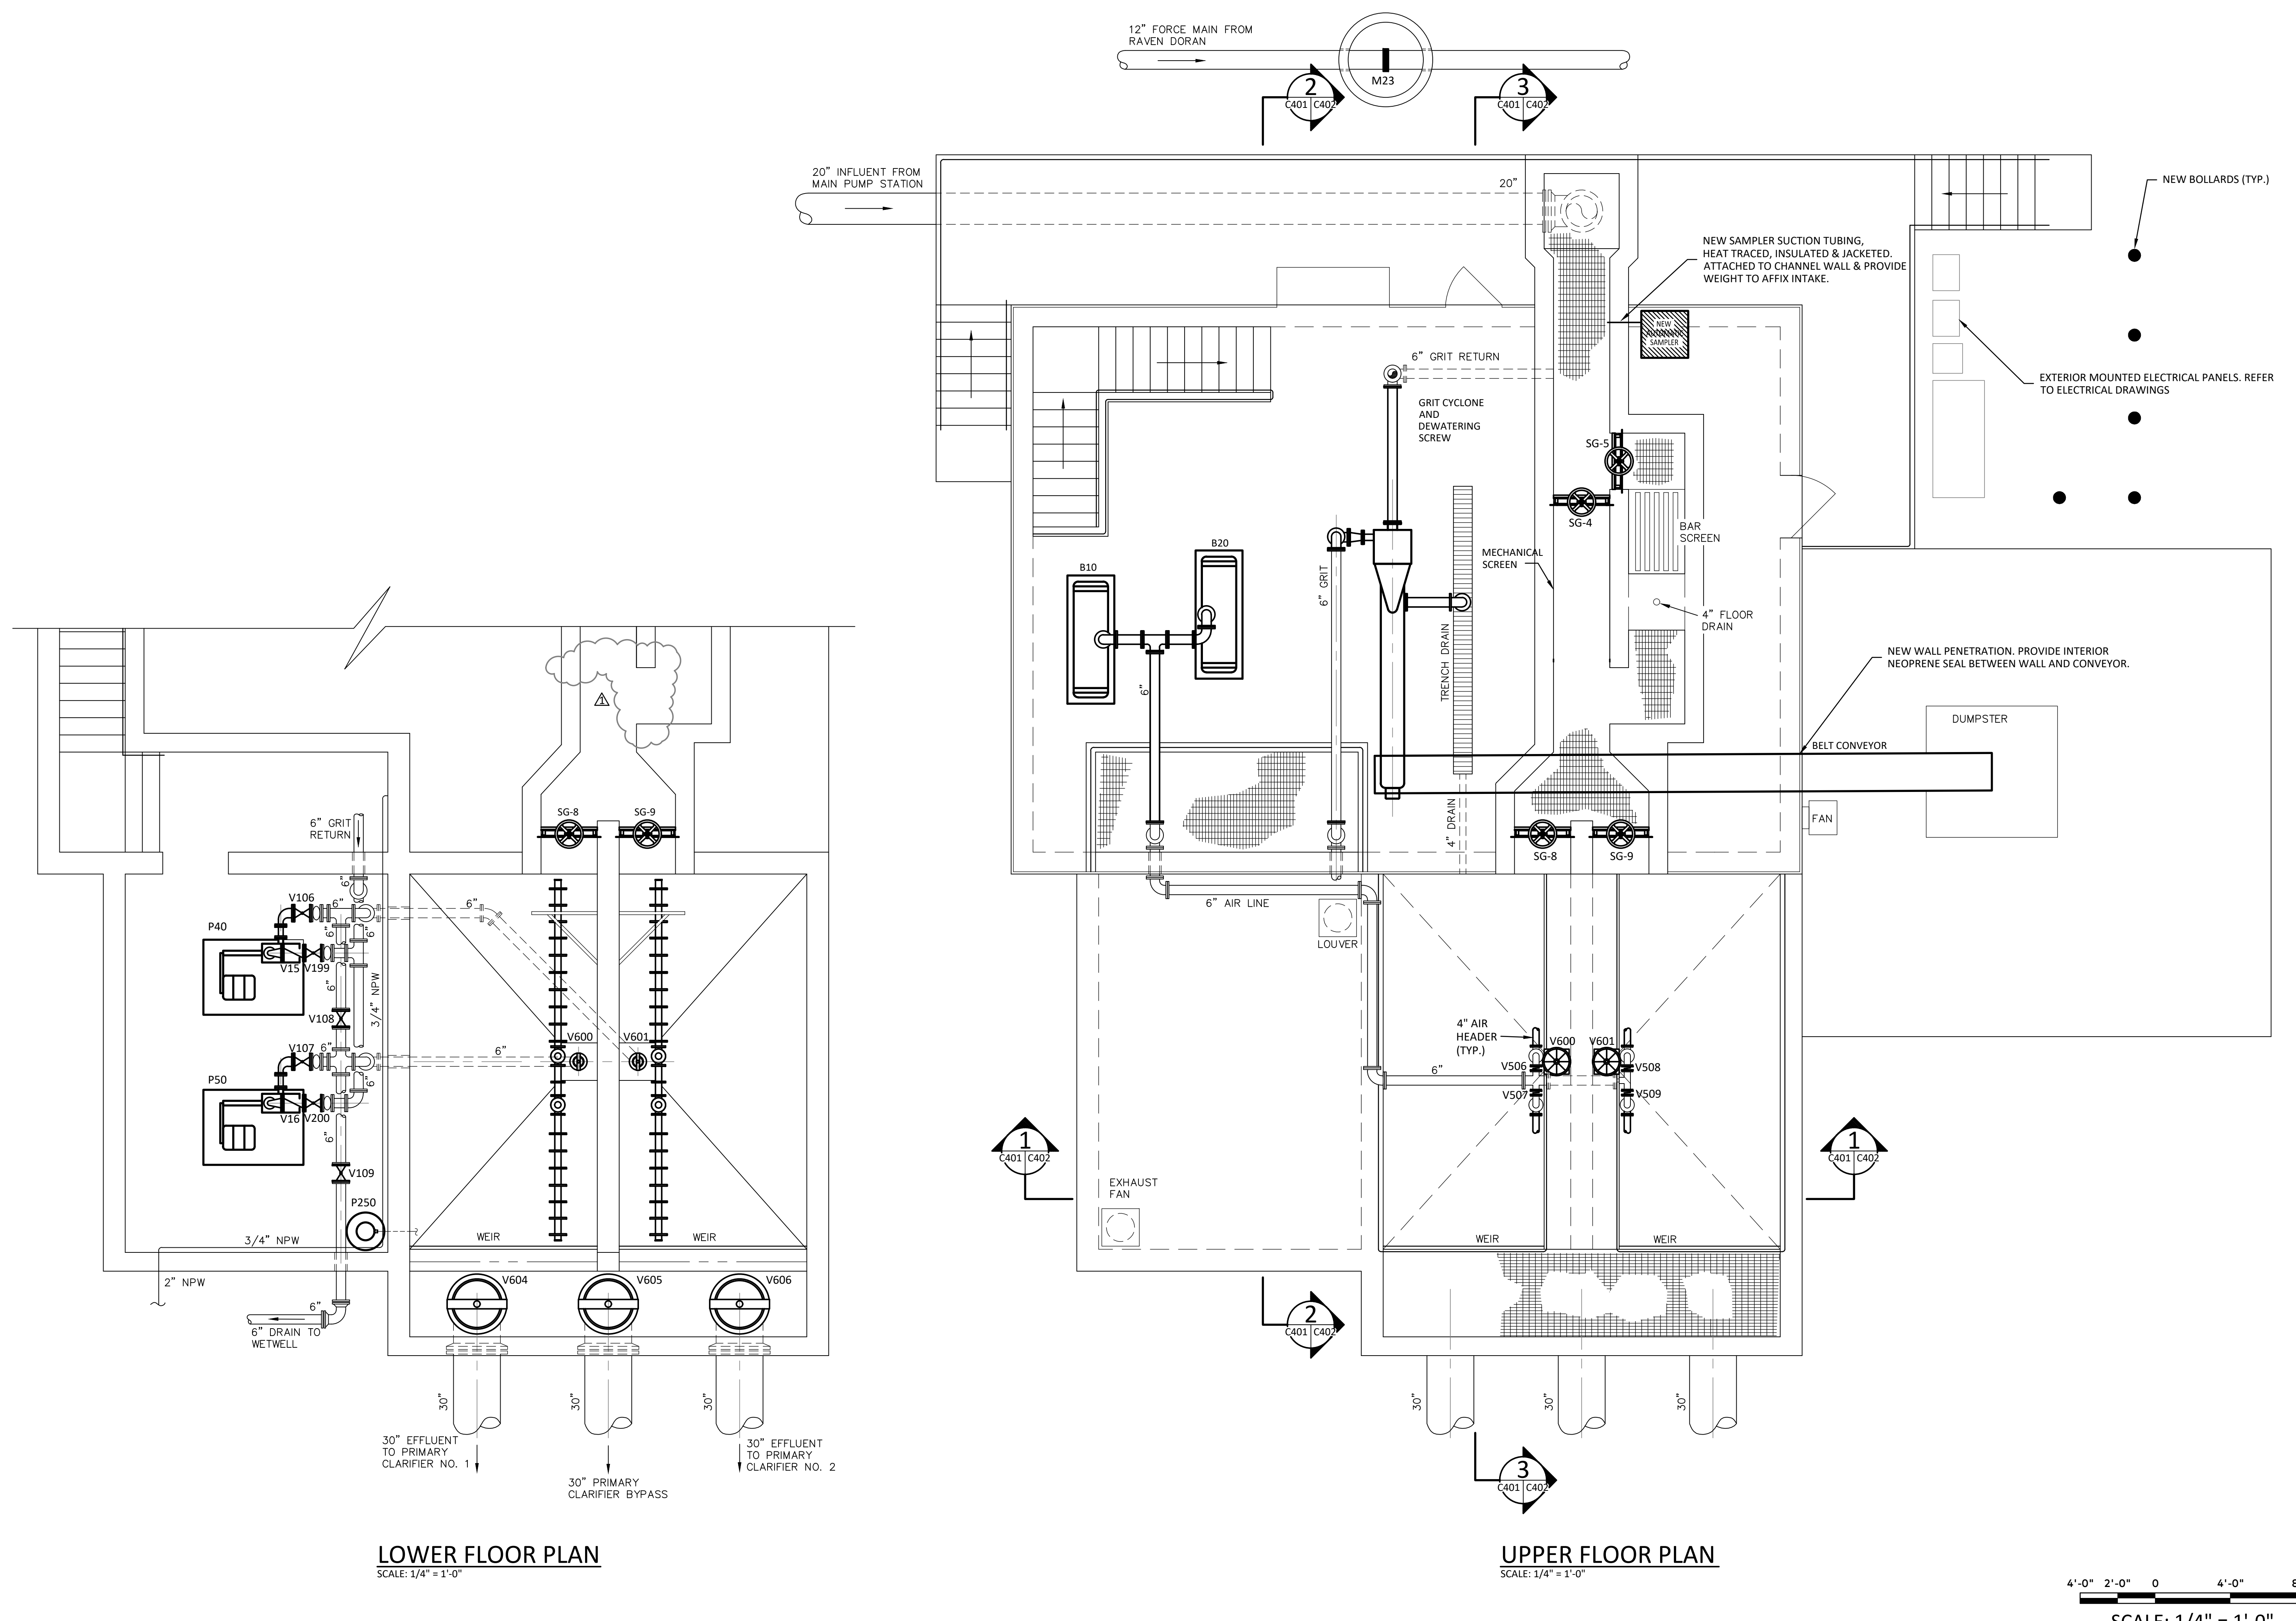



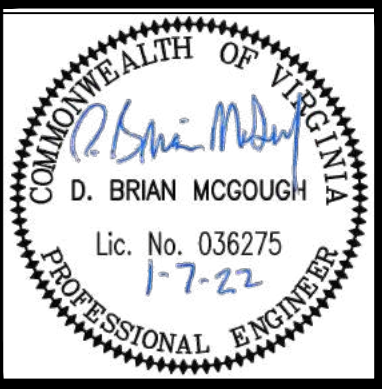


TOWN OF RICHLANDS - 4.0 MGD WWTP  
UPGRADES AND IMPROVEMENTS

PRELIMINARY TREATMENT BUILDING SECTIONS

No.	Date	Purpose of Document Issue
	03-31-21	ISSUED FOR DEO REVIEW
	04-15-21	ISSUED FOR TOWN REVIEW
	06-21-21	ISSUED FOR DEO REVIEW
	01-07-22	ISSUED FOR BIDS
	02-25-22	ADDENDUM NO. 5

Designed	DBM
Drawn	ESB
Checked	
Date	JULY 2020


Project No.	14249
-------------	-------

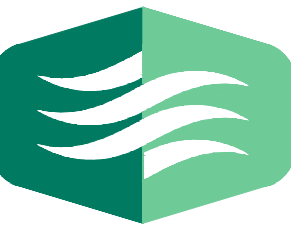


THOMPSON  
& LITTON

Sheet No.


C402

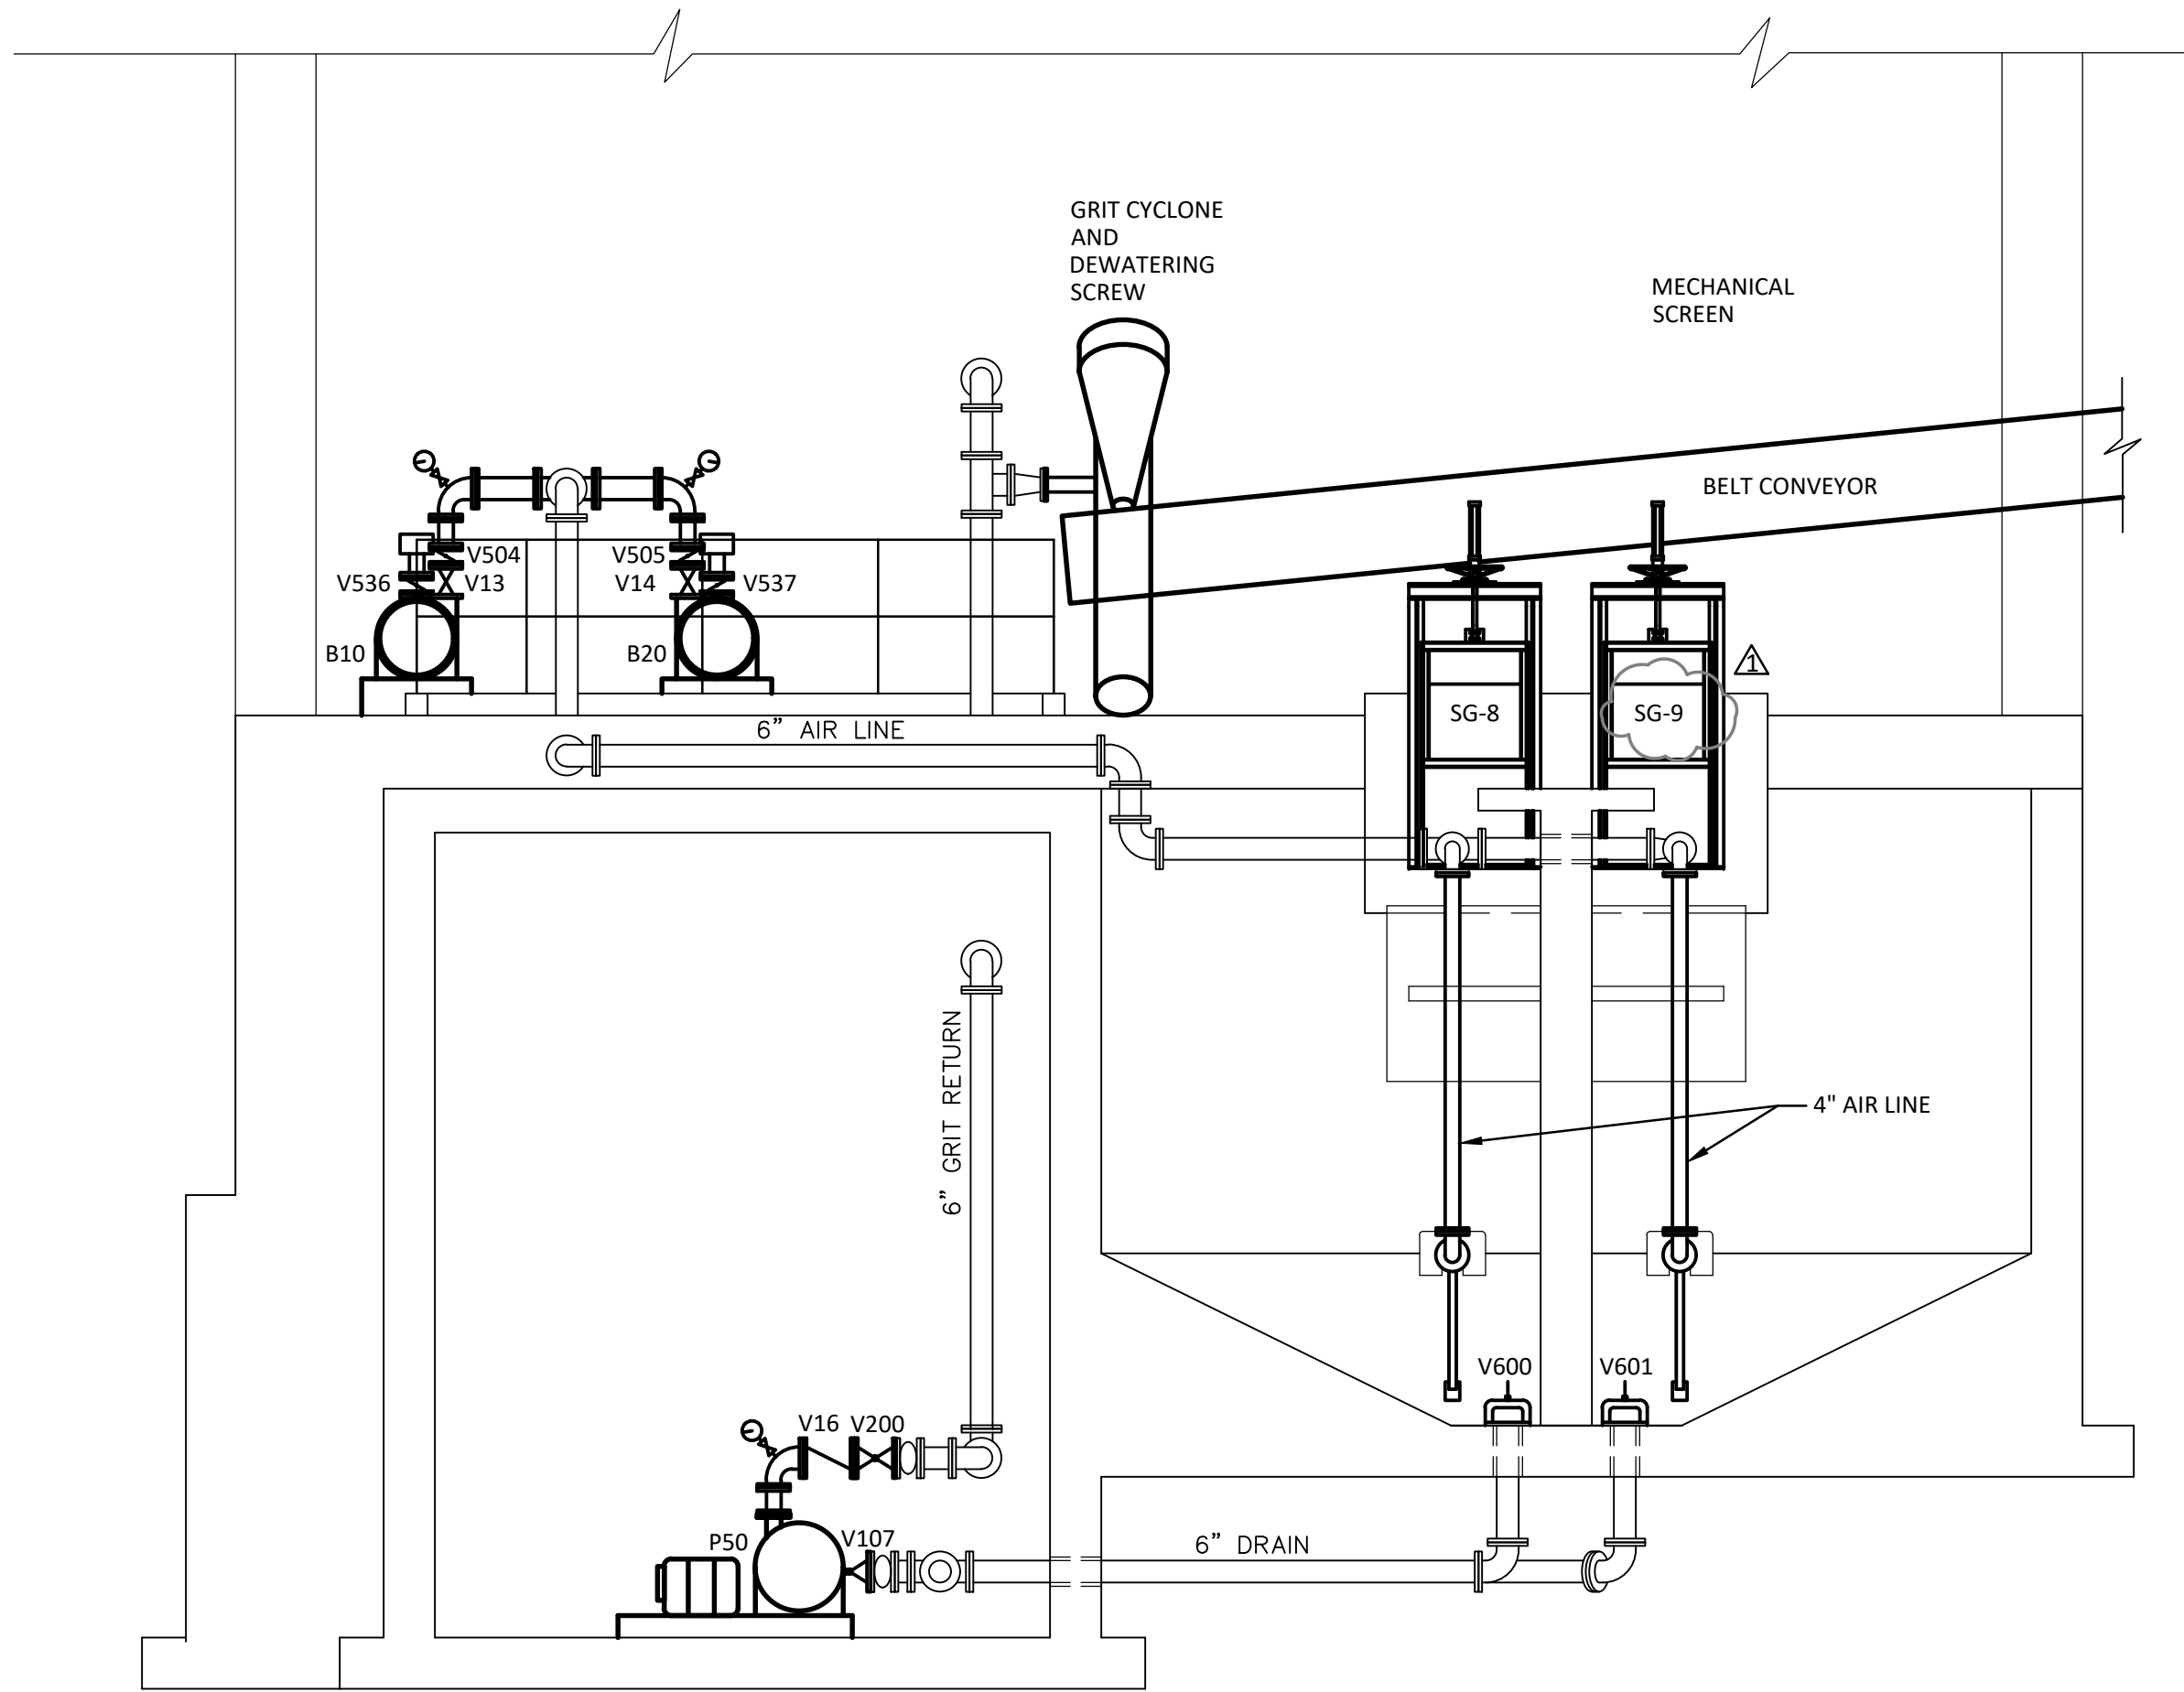

SECTION 1  
SCALE: 1/4" = 1'-0" CX01 CX02

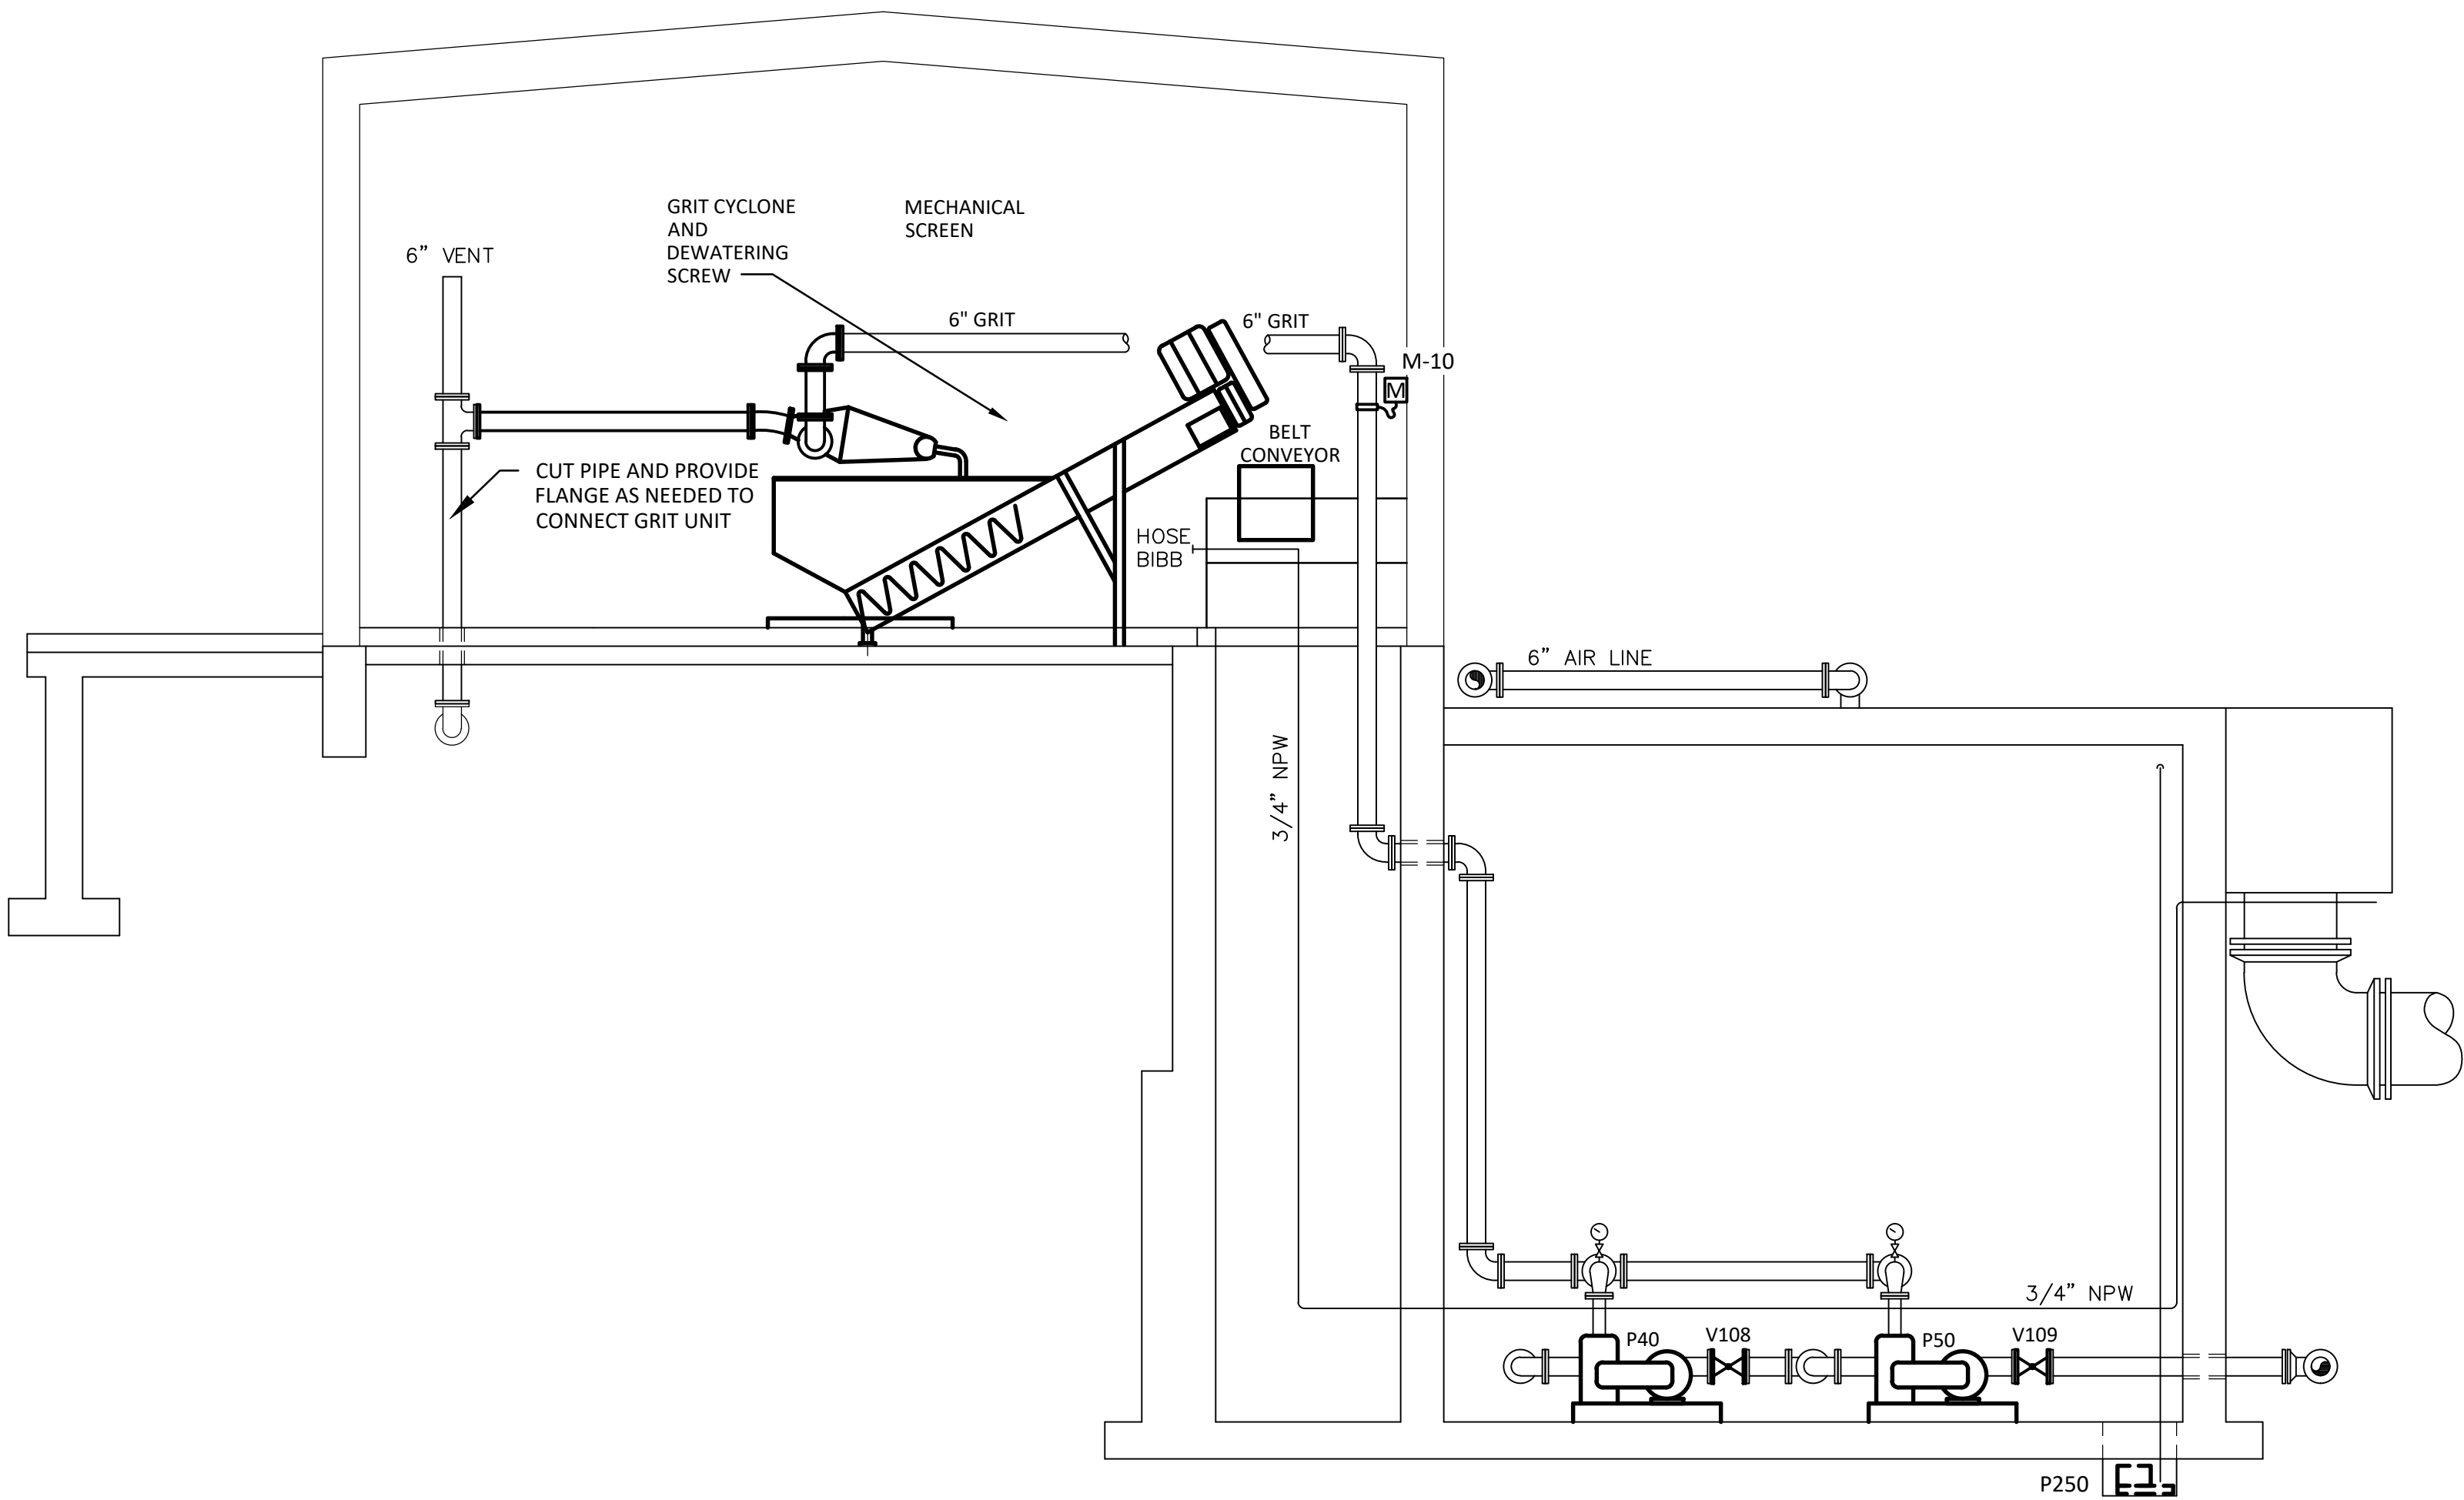


SECTION 2  
SCALE: 1/4" = 1'-0" CX01 CX02

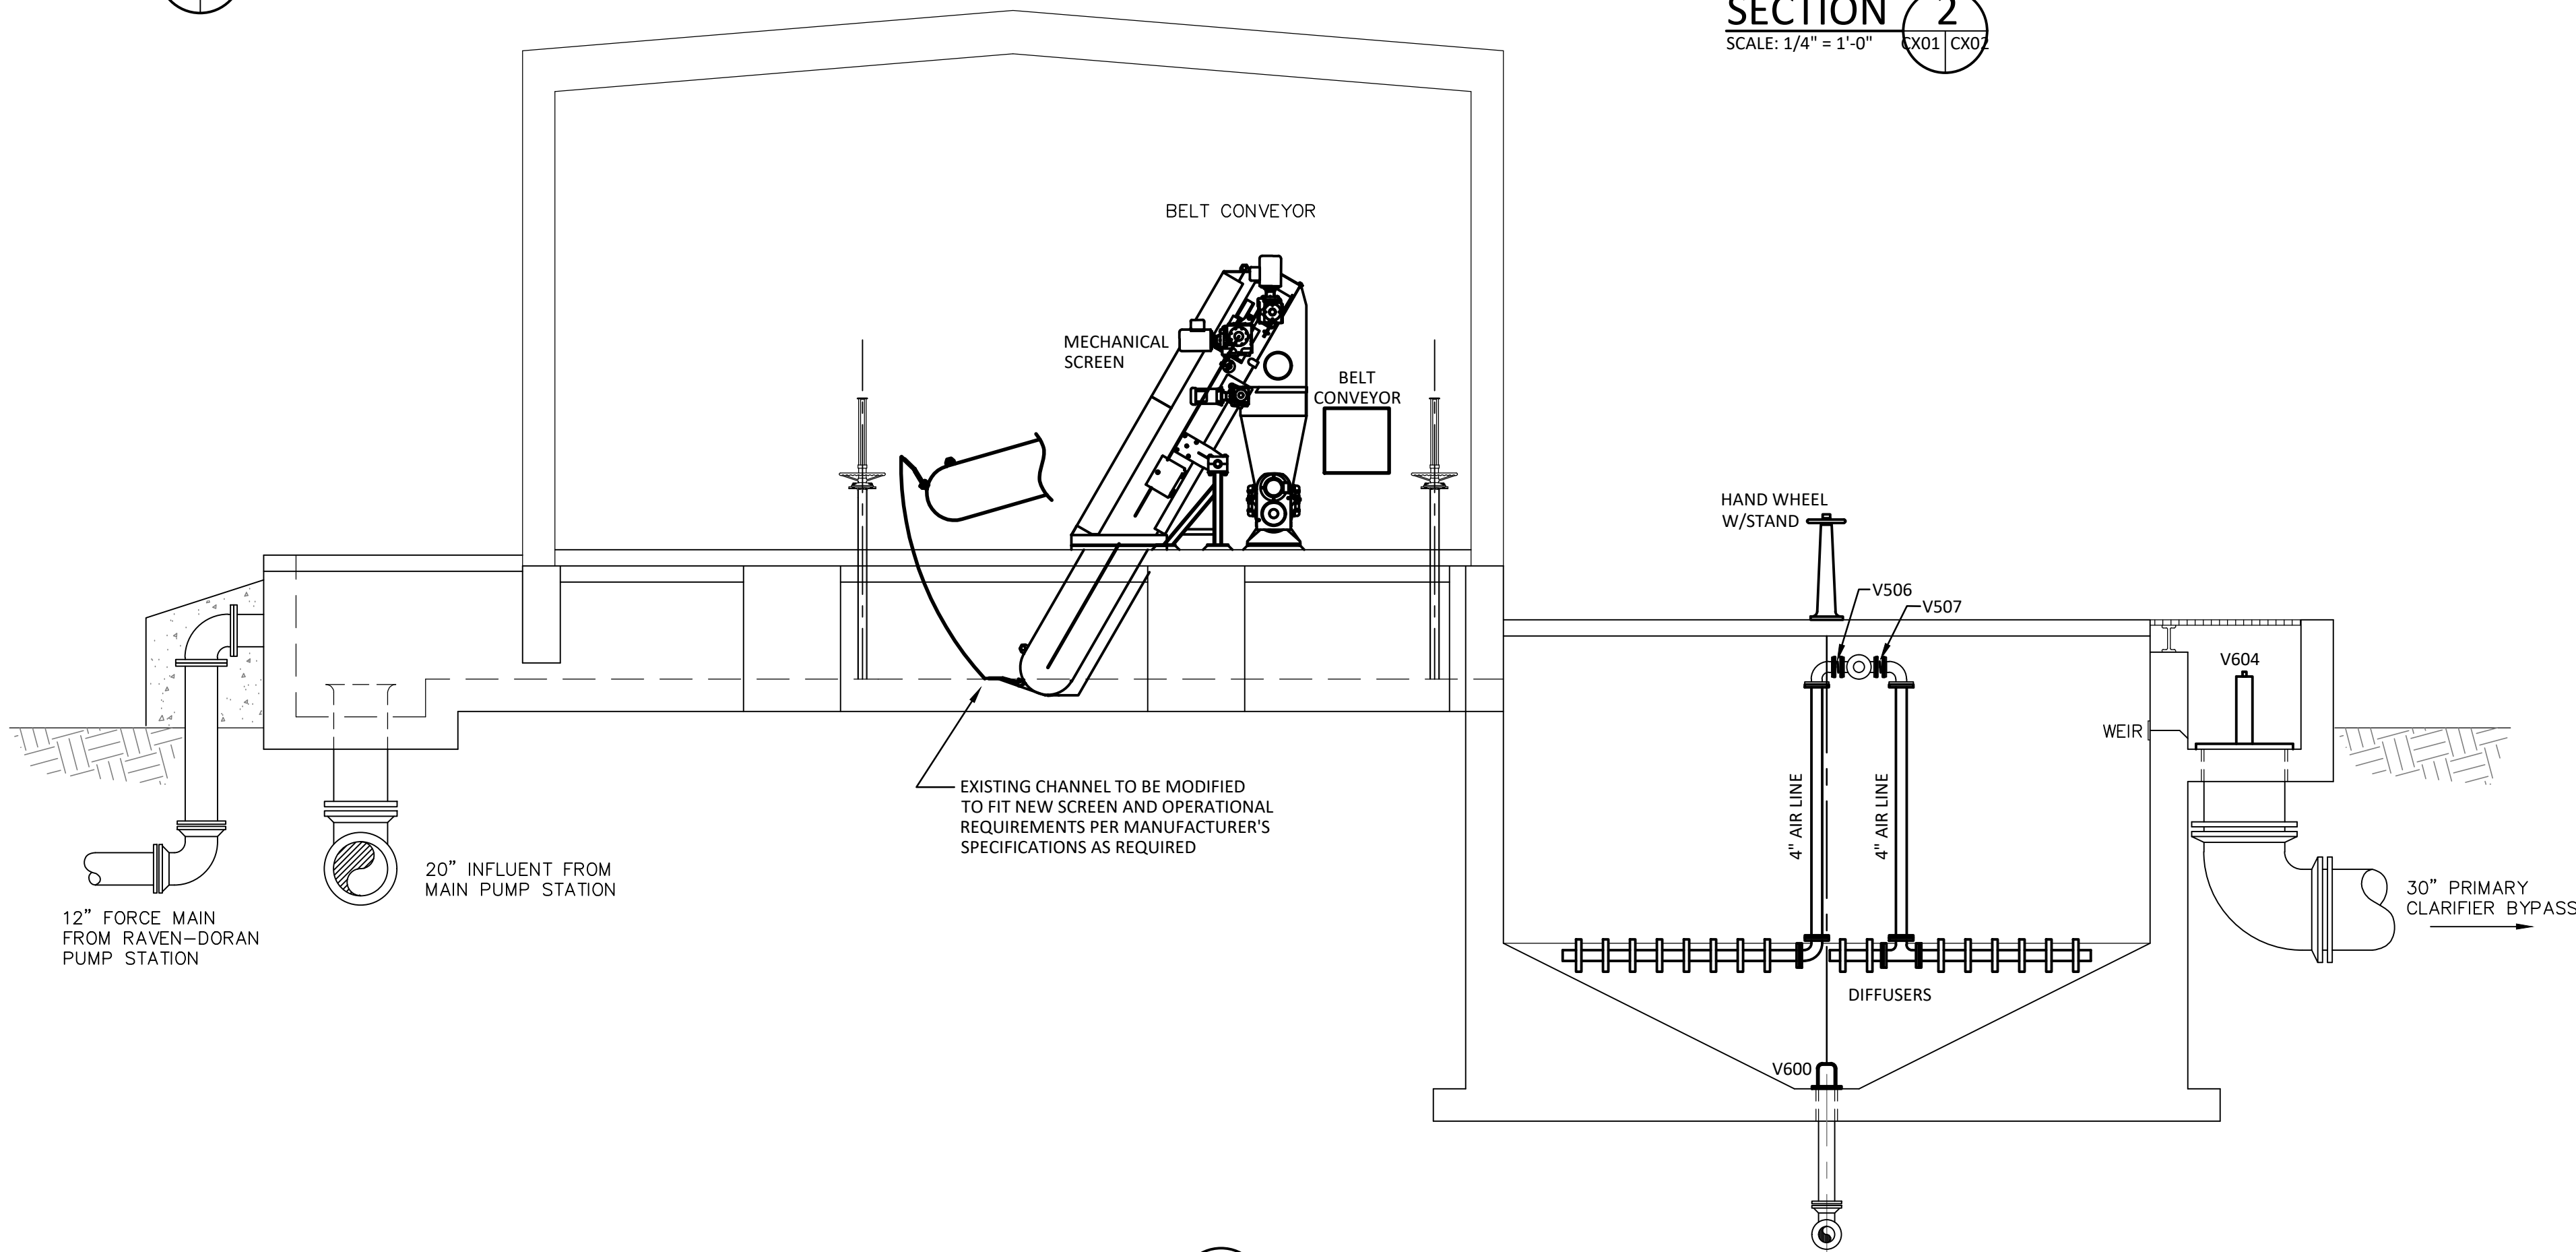

SECTION 3  
SCALE: 1/4" = 1'-0" CX01 CX02

4'-0" 2'-0" 0 4'-0" 8'-0"  
SCALE: 1/4" = 1'-0"



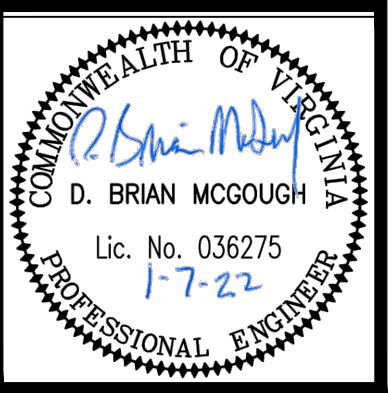


TOWN OF RICHLANDS - 4.0 MGD WWTP  
UPGRADES AND IMPROVEMENTS

PRIMARY CLARIFIERS RENOVATION PLAN

Purpose of Document Issue			
No.	Date	Issued For	Issued For
	03-31-21	ISSUED FOR DEC REVIEW	
	04-15-21	ISSUED FOR TOWN REVIEW	
	06-21-21	ISSUED FOR DEC REVIEW	
	01-07-22	ISSUED FOR BIDS	

Designed	DBM
Drawn	ESB
Checked	
Date	JULY 2020


Project No.	14249
-------------	-------

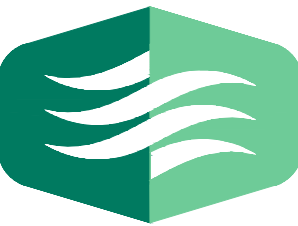


THOMPSON  
& LITTON

Sheet No.

C501

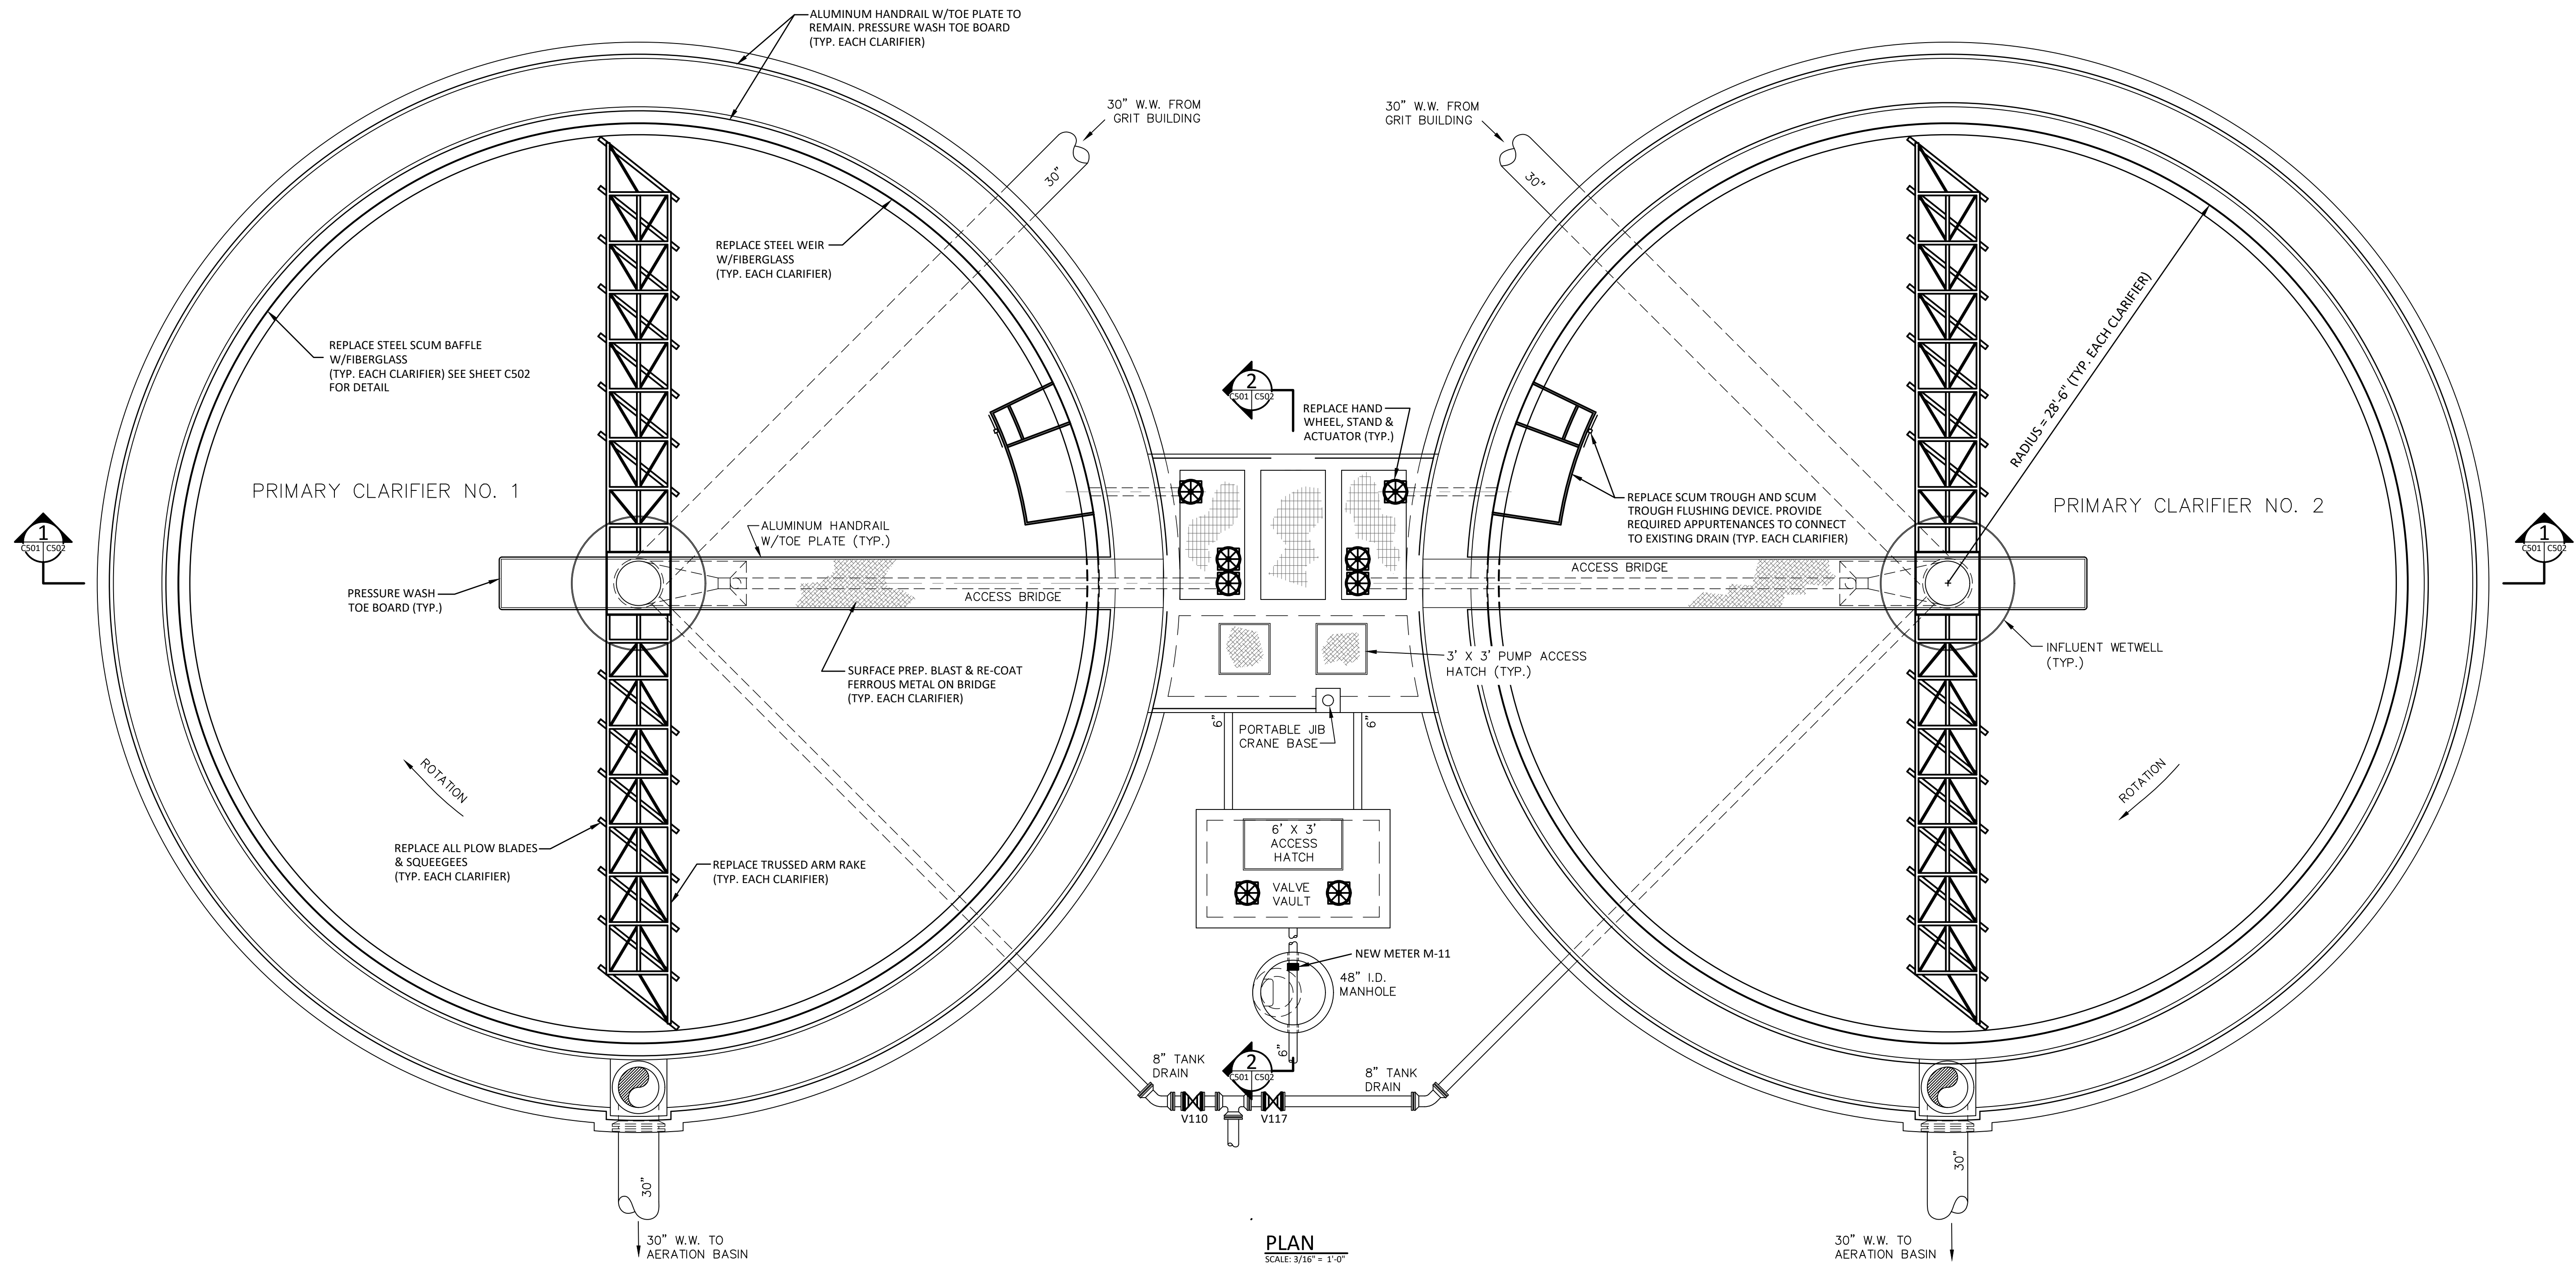


PLAN  
SCALE: 3/16" = 1'-0"

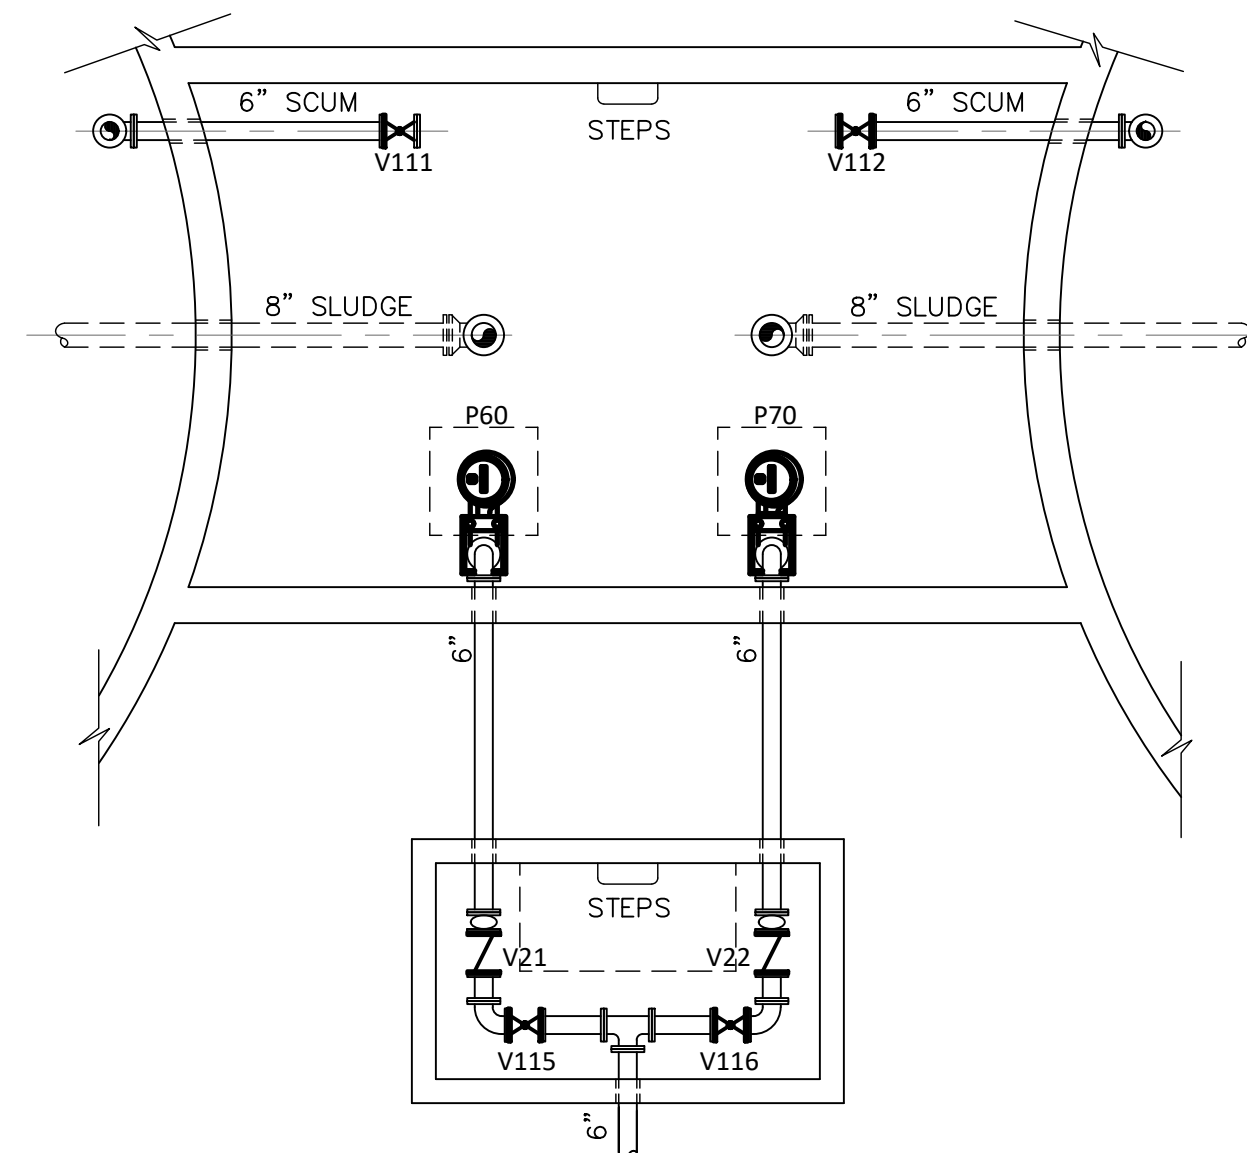


PLAN @ PUMP LEVEL  
SCALE: 3/16" = 1'-0"

NOTE:  
REFER TO SPECIFICATIONS FOR COMPLETE  
CLARIFIER MECHANISM REHABILITATION  
REQUIREMENTS.

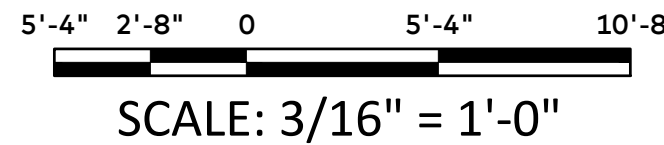



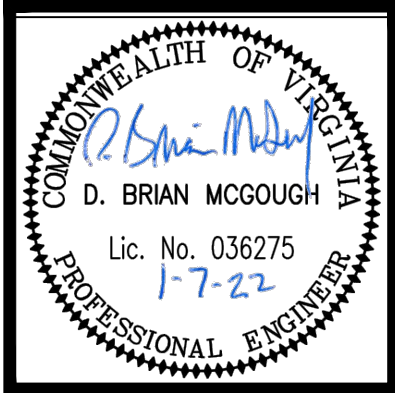

TOWN OF RICHLANDS - 4.0 MGD WWTP  
UPGRADES AND IMPROVEMENTS

PRIMARY CLARIFIERS SECTIONS

No.	Date	Purpose of Document Issue
	03-31-21	ISSUED FOR DEO REVIEW
	04-15-21	ISSUED FOR TOWN REVIEW
	06-21-21	ISSUED FOR DEO REVIEW
	01-07-22	ISSUED FOR BIDS
	02-21-22	ADDENDUM NO. 4


Designed	DBM
Drawn	ESB
Checked	
Date	JULY 2020

Project No.	14249
-------------	-------




Sheet No.


C502

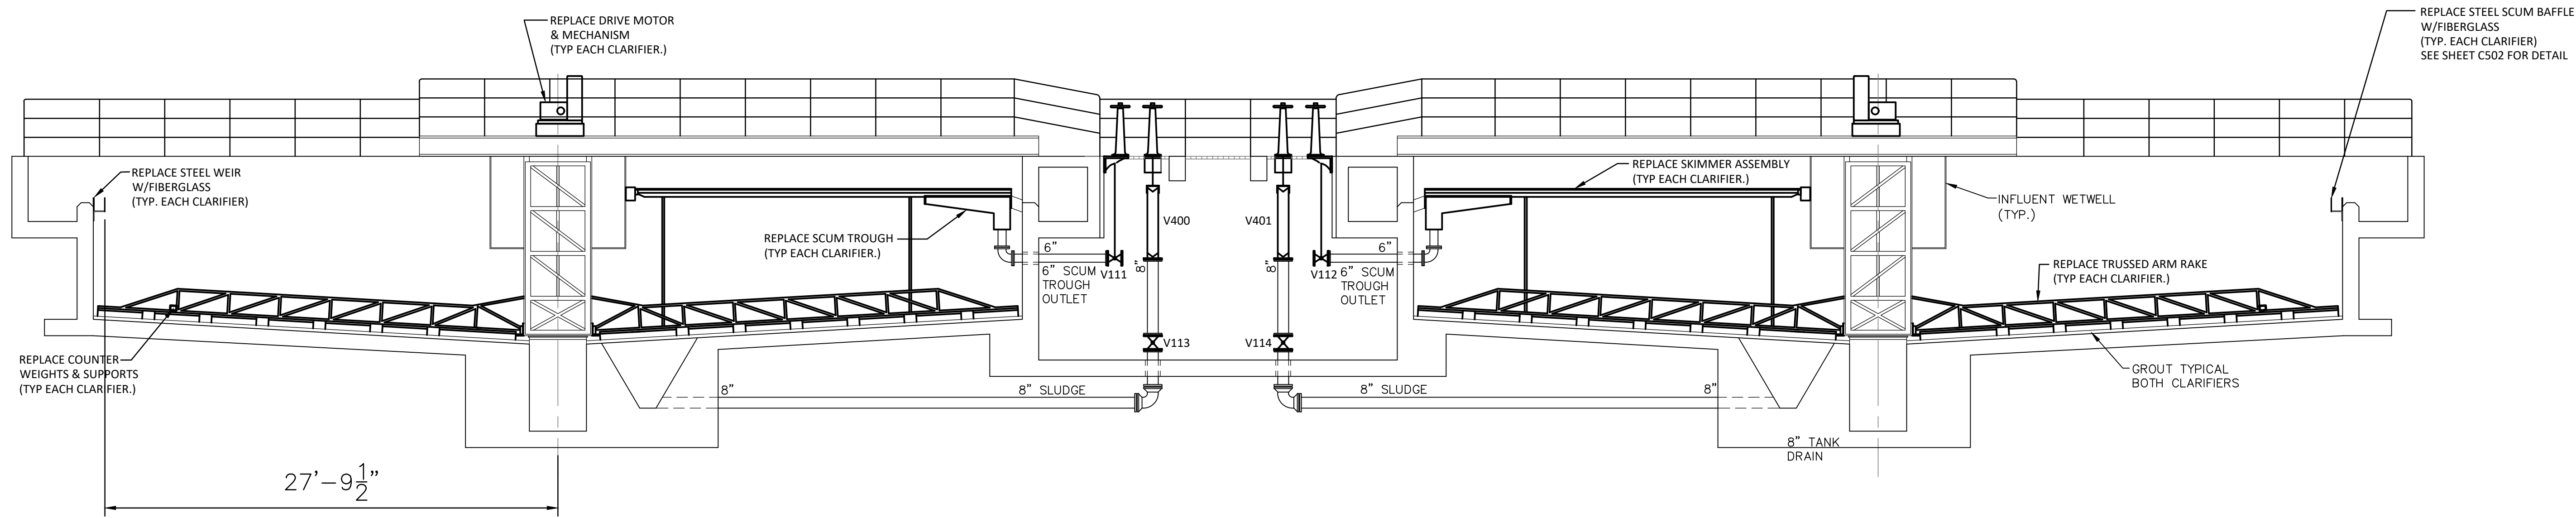


SECTION 1  
SCALE: 3/16" = 1'-0"

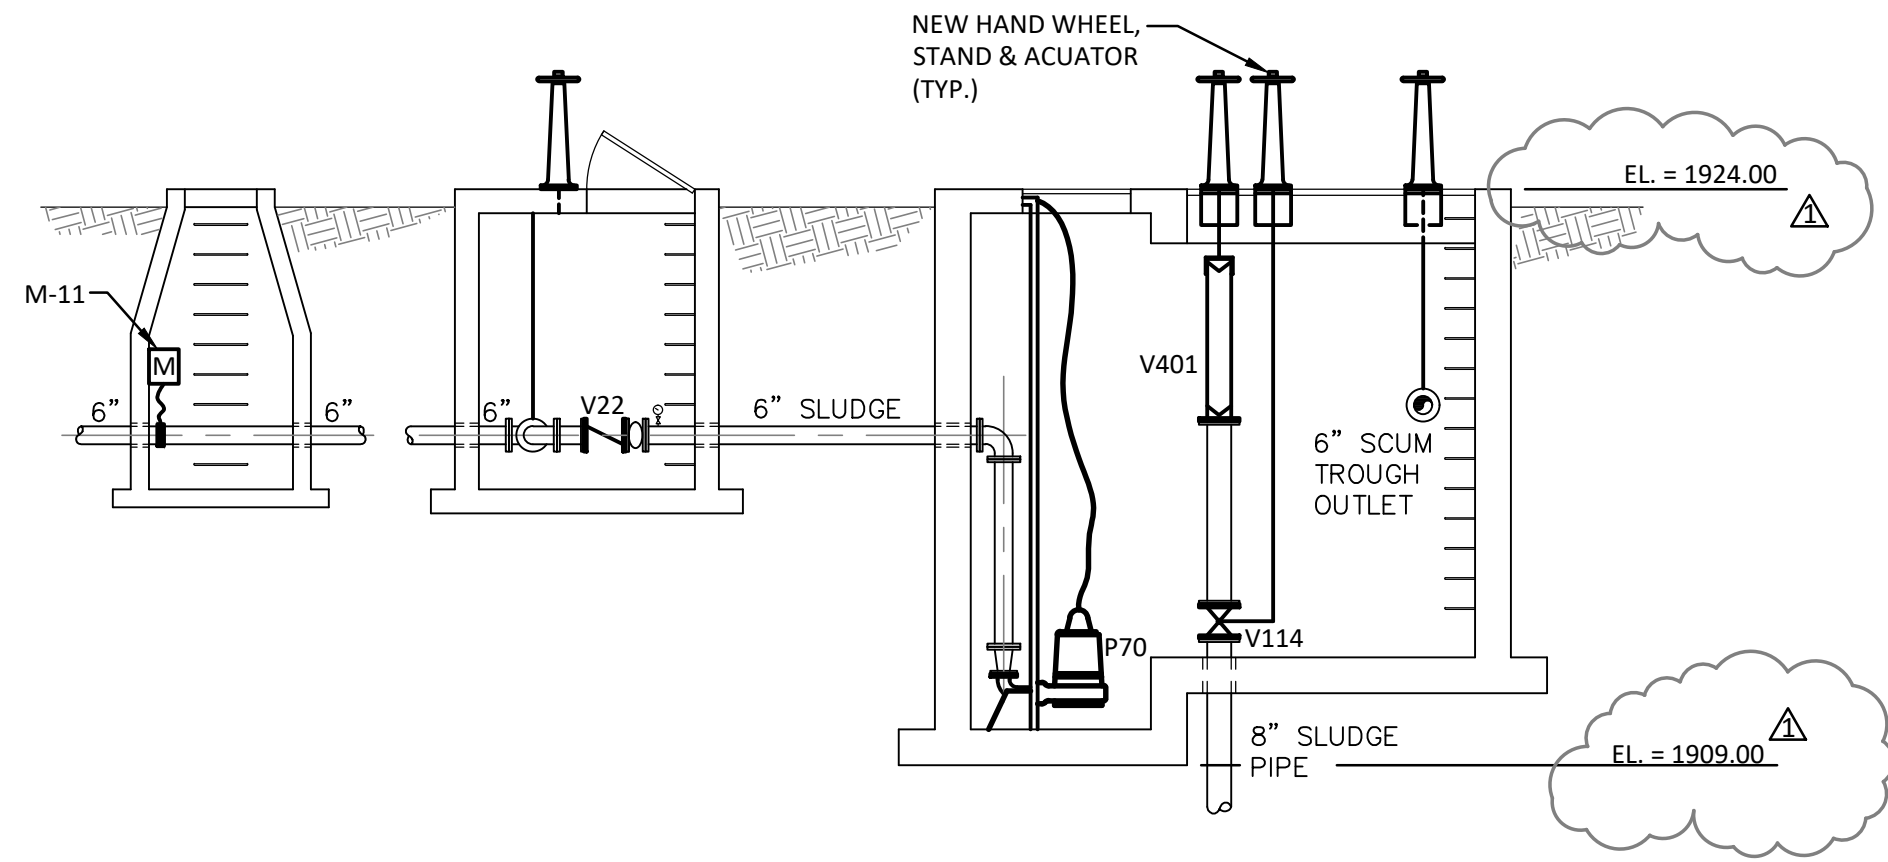


SECTION 2  
SCALE: 3/16" = 1'-0"

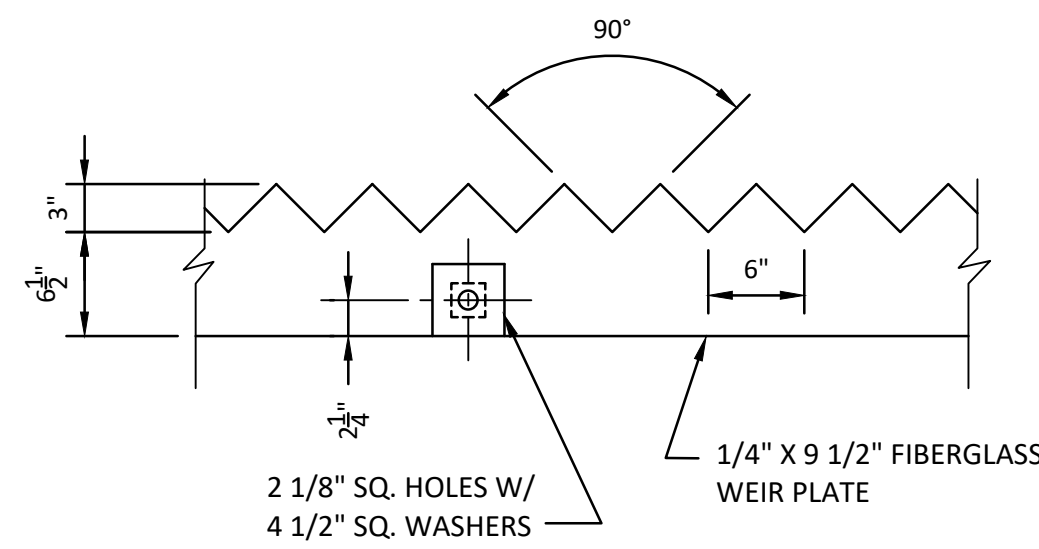


WEIR DETAIL  
SCALE: 1" = 1'-0"

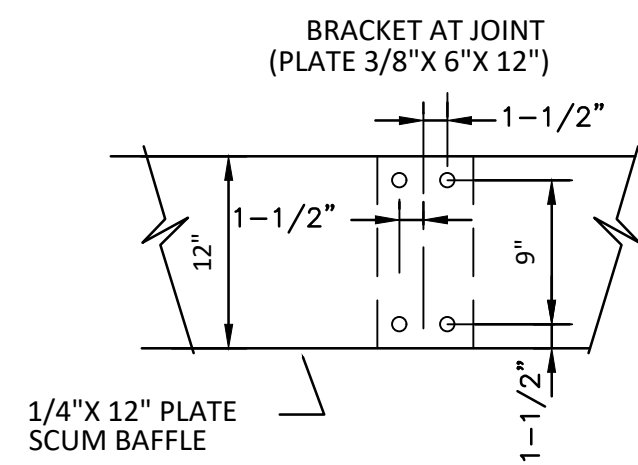

SCUM BAFFLE DETAIL  
SCALE: 1" = 1'-0"


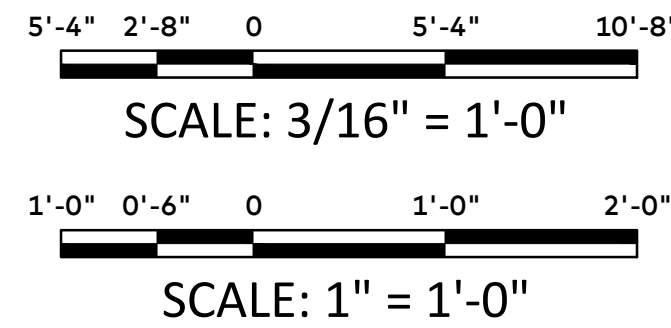




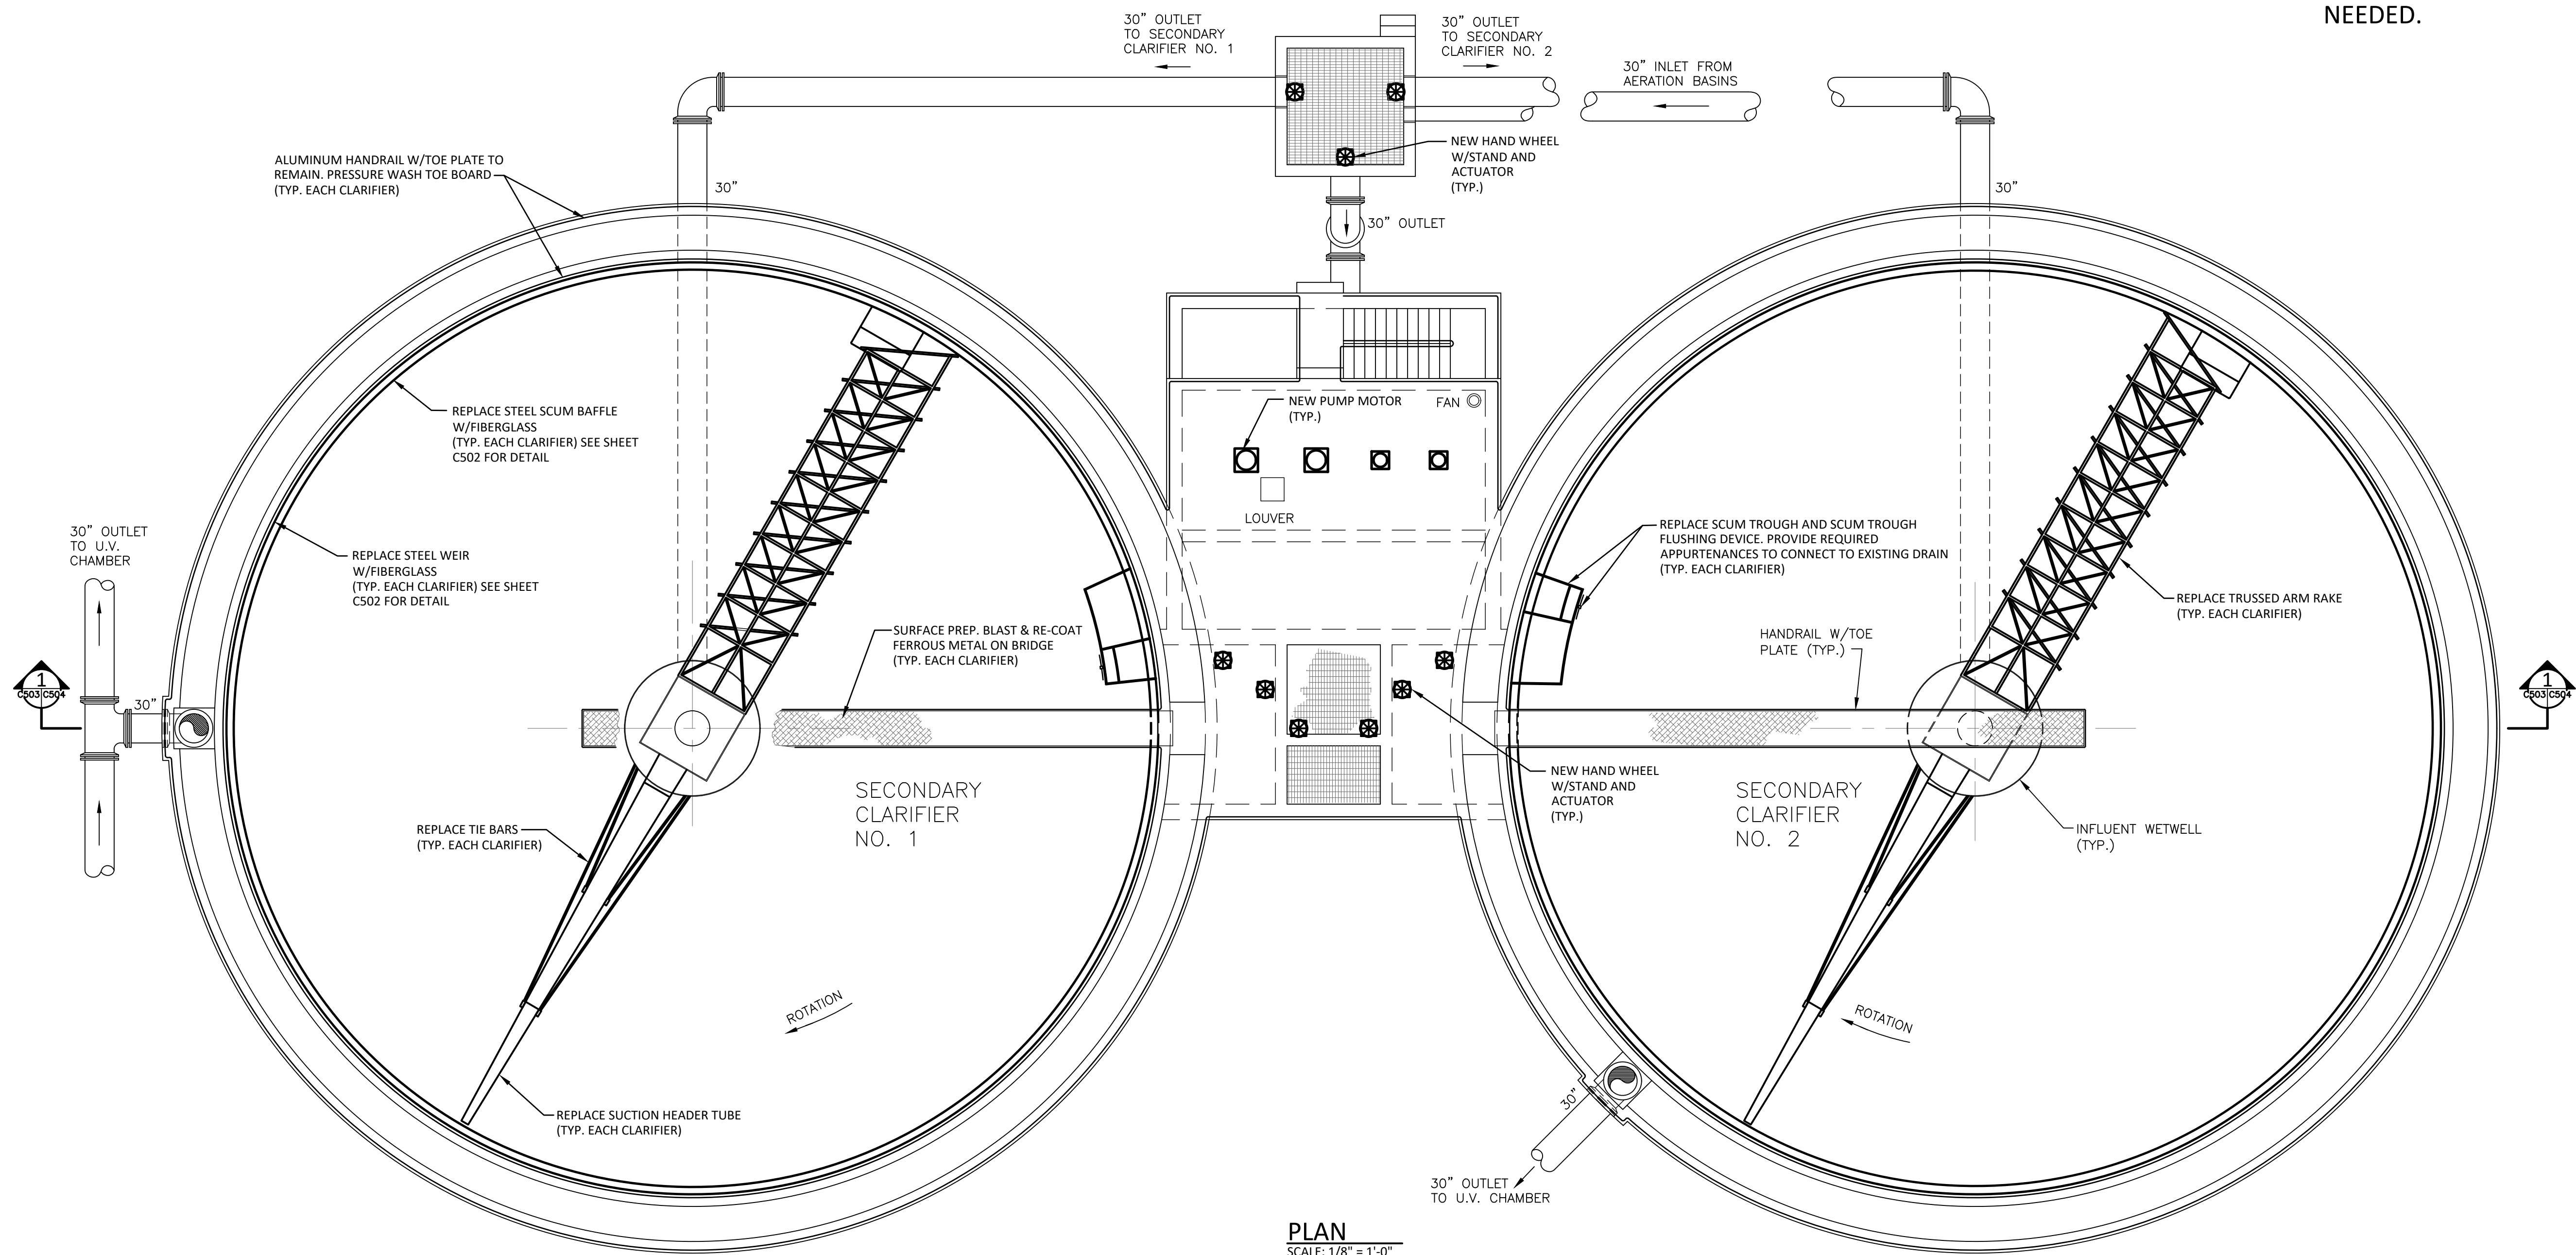

PLAN  
SCALE: 1/8" = 1'-0"

- NOTE:
- REFER TO SPECIFICATIONS FOR COMPLETE CLARIFIER MECHANISM REHABILITATION REQUIREMENTS.
  - WELL POINT PUMPING WILL NEED TO BE PERFORMED WHEN CLARIFIERS ARE DRAINED. UTILIZE EXISTING GROUNDWATER OBSERVATION WELLS AND INSTALL ADDITIONAL WELLS AS NEEDED.

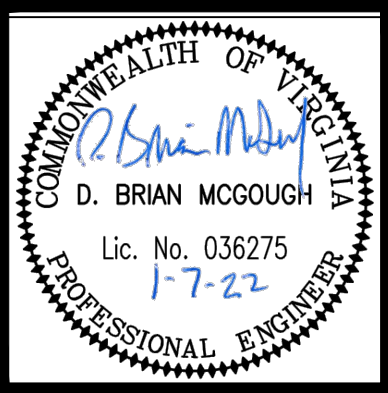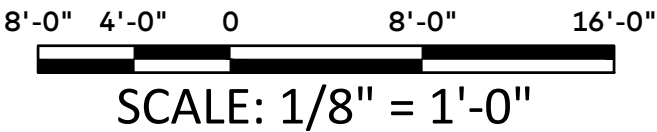

TOWN OF RICHLANDS - 4.0 MGD WWTP  
UPGRADES AND IMPROVEMENTS

## SECONDARY CLARIFIERS RENOVATION PLAN

No.	Date	Purpose of Document Issue
	03-31-21	ISSUED FOR DEO REVIEW
	04-15-21	ISSUED FOR TOWN REVIEW
	06-21-21	ISSUED FOR DEO REVIEW
	01-07-22	ISSUED FOR BIDS


Designed	DBM
Drawn	ESB
Checked	
Date	JULY 2020

Project No.  
**14249**



Sheet No.  
**C503**



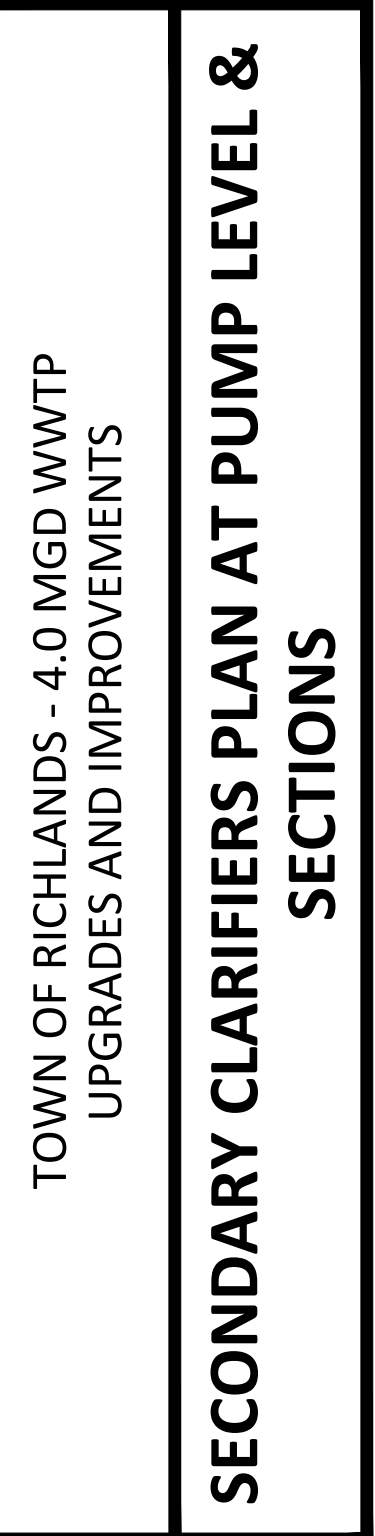

Designed	DBM
Drawn	ESB
Checked	
Date	JULY 2020



THOMPSON  
& LITTON


Sheet No.

C504



4'-0" 2'-0" 0 4'-0" 8'-0"  
SCALE: 1/4" = 1'-0"

8'-0" 4'-0" 0 8'-0" 16'-0"  
SCALE: 1/8" = 1'-0"



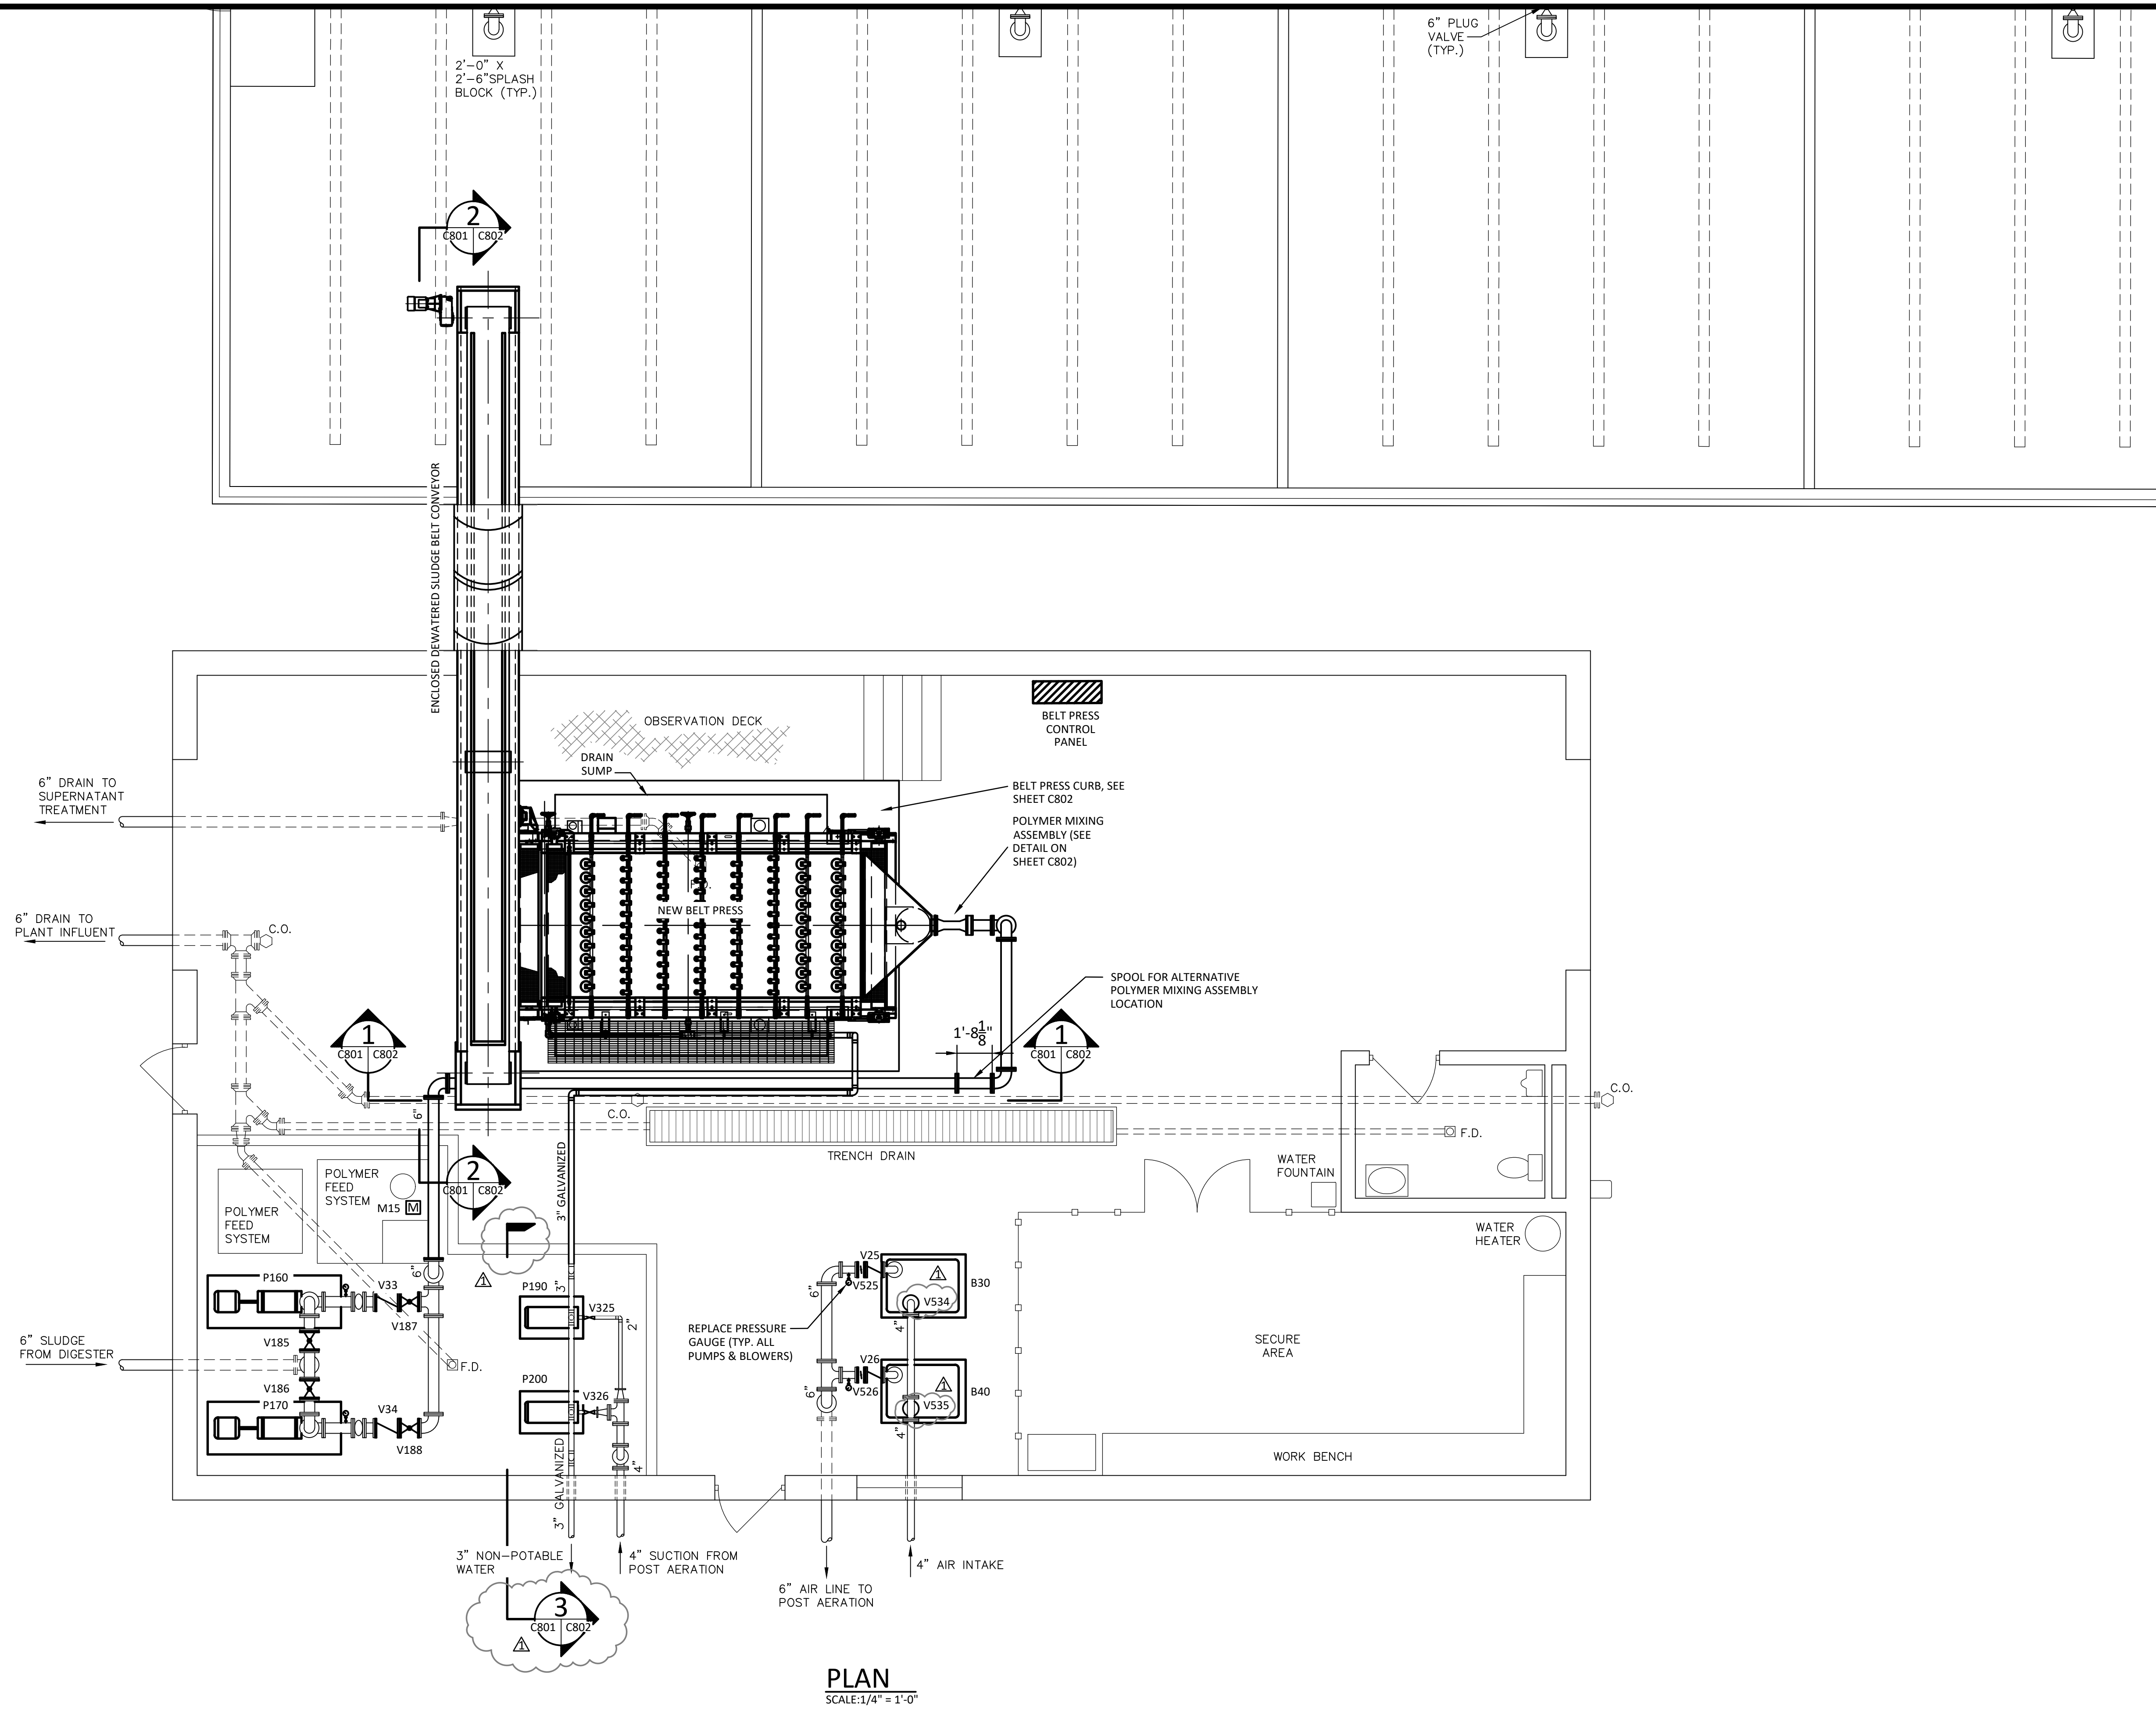

PLAN  
SCALE: 1/4" = 1'-0"

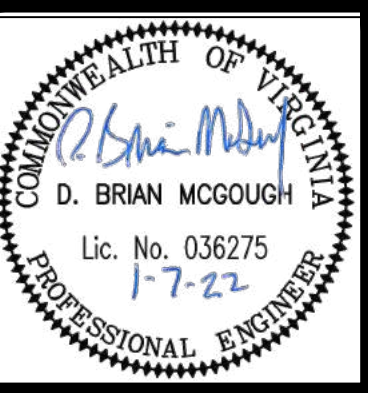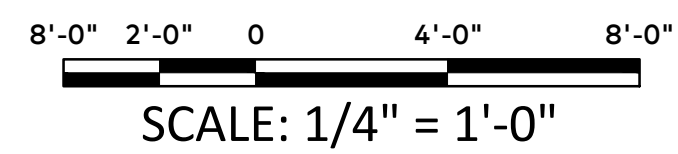


TOWN OF RICHLANDS - 4.0 MGD WWTP  
UPGRADES AND IMPROVEMENTS

SHOP BUILDING RENOVATION PLAN

Purpose of Document Issue		Date	
ISSUED FOR DEO REVIEW		03-31-21	
ISSUED FOR TOWN REVIEW		04-15-21	
ISSUED FOR DEO REVIEW		06-21-21	
ISSUED FOR BIDS		01-07-22	
APPENDIX NO. 5		02-25-22	
No.			

Designed	DBM
Drawn	ESB
Checked	
Date	JULY 2020

Project No.	14249
-------------	-------

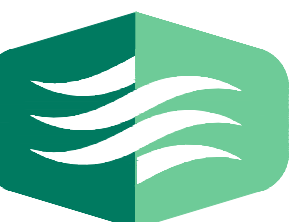


THOMPSON  
& LITTON

Sheet No.	C801
-----------	------







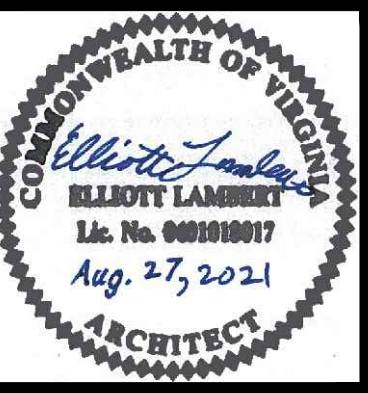

TOWN OF RICHLANDS - 4.0 MGD WWTP  
UPGRADES AND IMPROVEMENTS

**NEW PRELIMINARY TREATMENT BUILDING  
EXTERIOR ELEVATIONS**


No.	Purpose of Document Issue		
	ISSUED FOR 60% REVIEW		
	ISSUED FOR 100% REVIEW		
	ISSUED FOR BID		
Date	10-21-20	02-26-21	01-07-22

Designed	EL
Drawn	MLT
Checked	EL
Date	08-27-2021


Project No.  
**14249-00**




Sheet No.  
**A201**

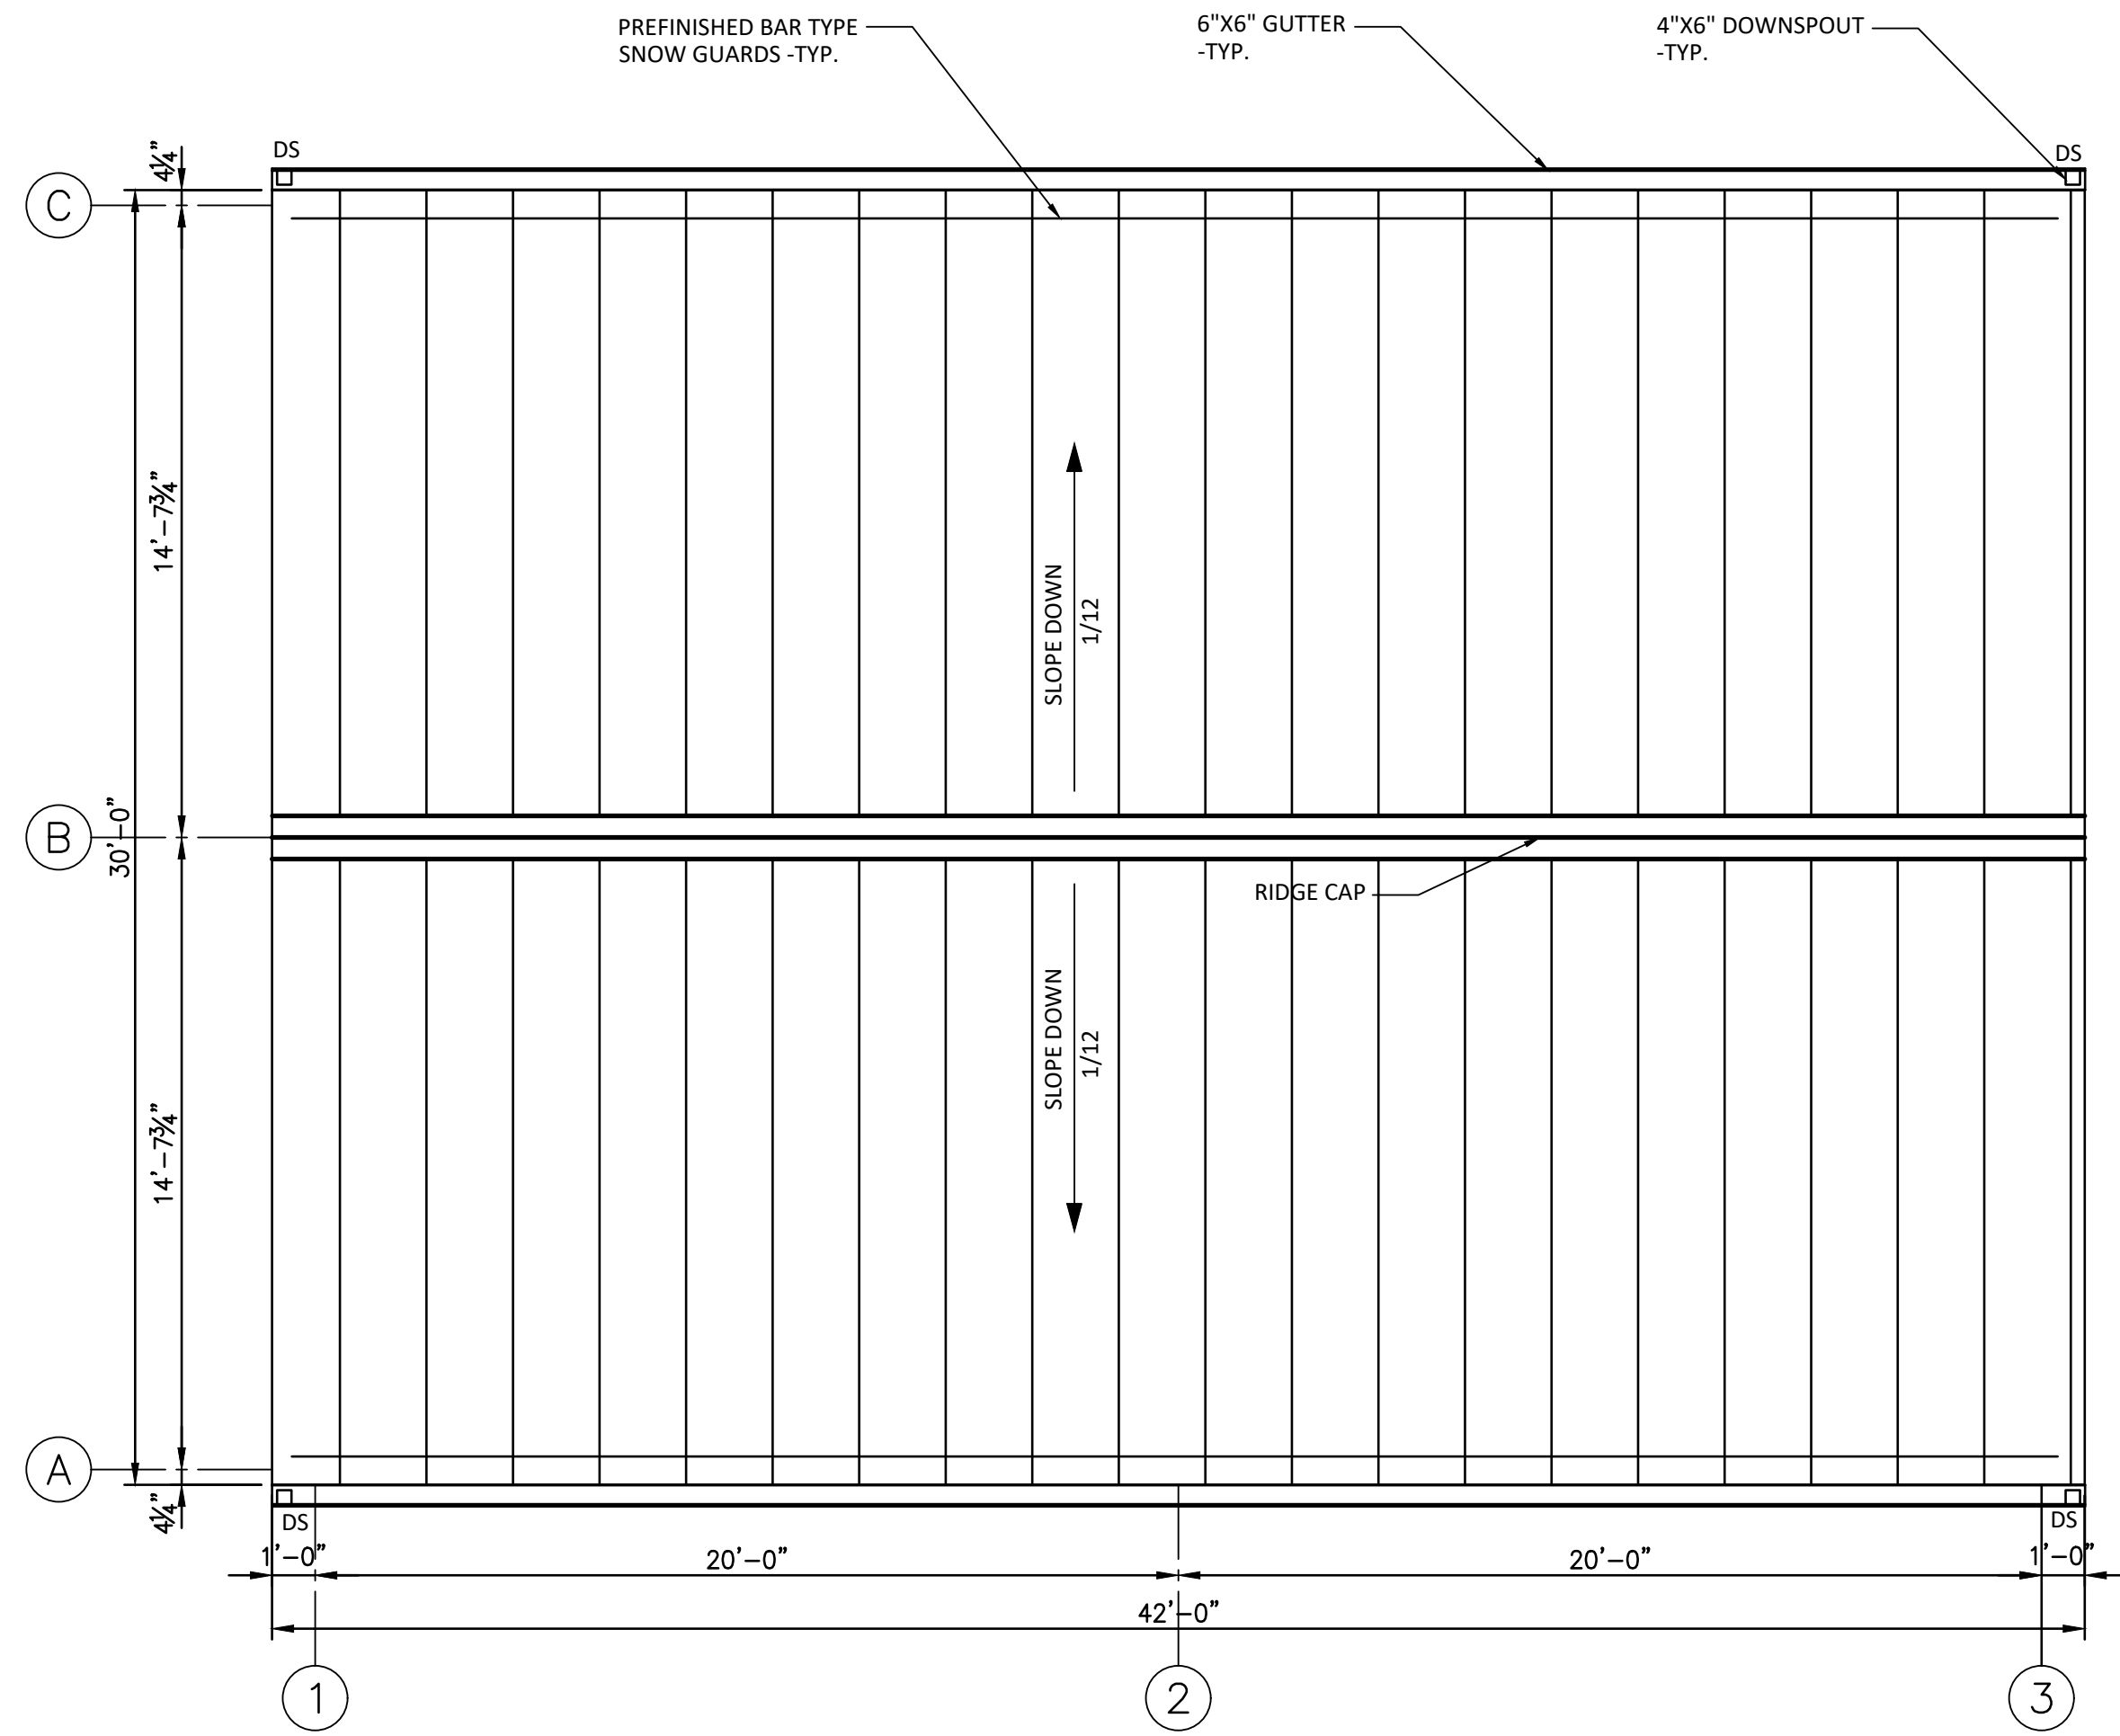


**ROOF FRAMING PLAN**  
SCALE: 1/4"=1'-0"  
PLAN NORTH

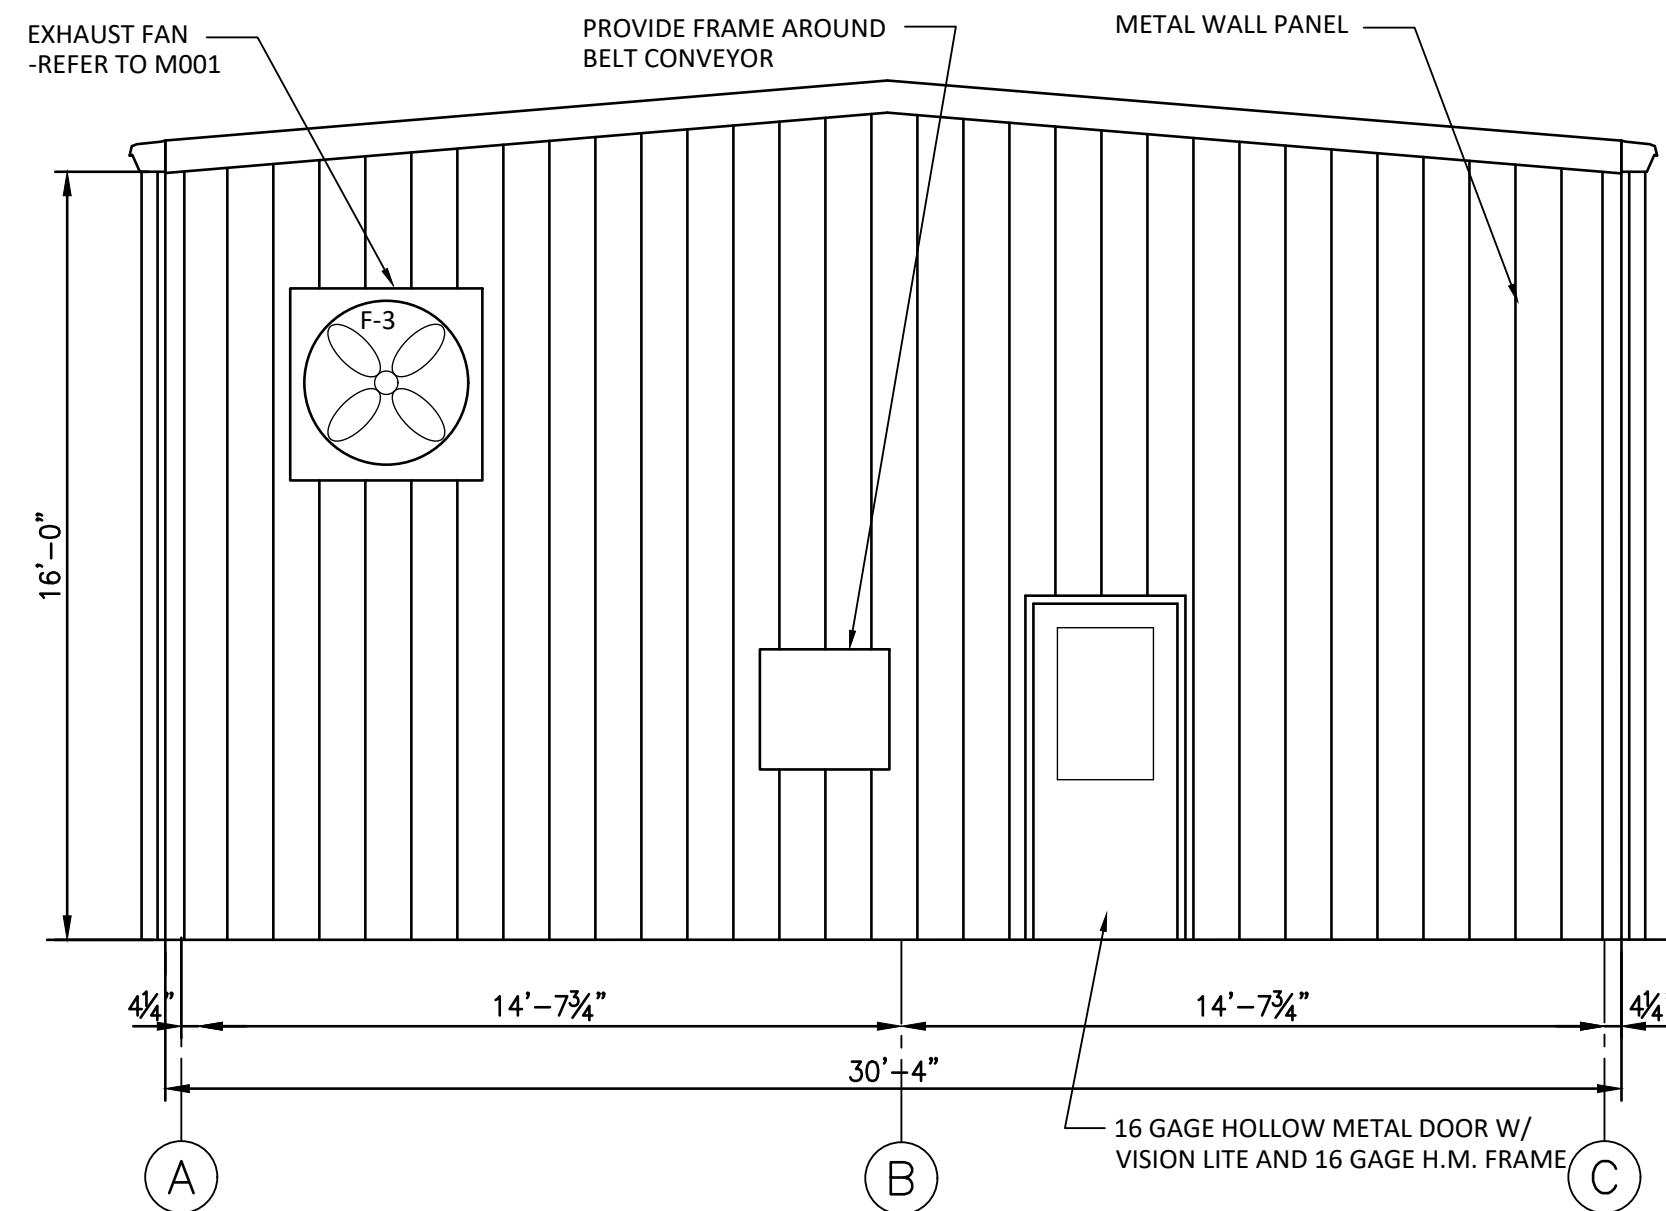


**EAST ELEVATION**  
SCALE: 1/4"=1'-0"

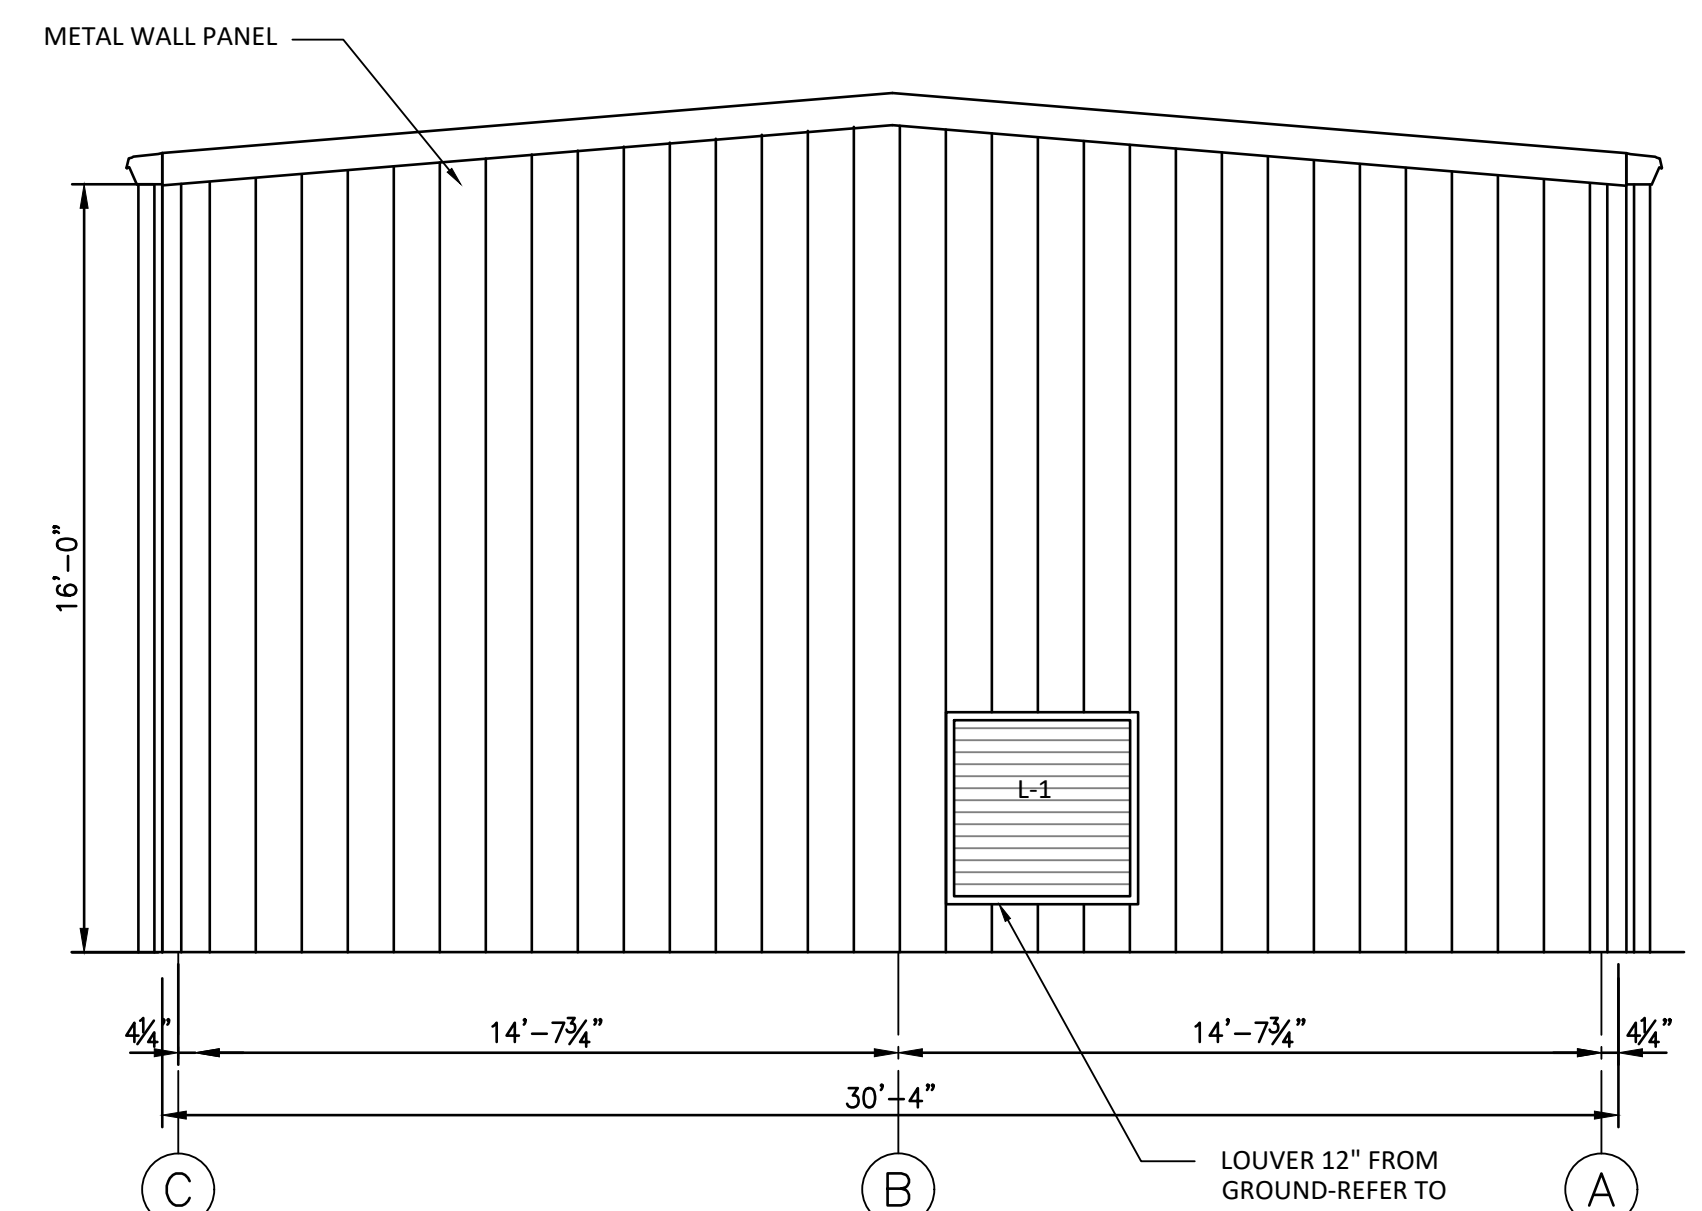

**WEST ELEVATION**  
SCALE: 1/4"=1'-0"

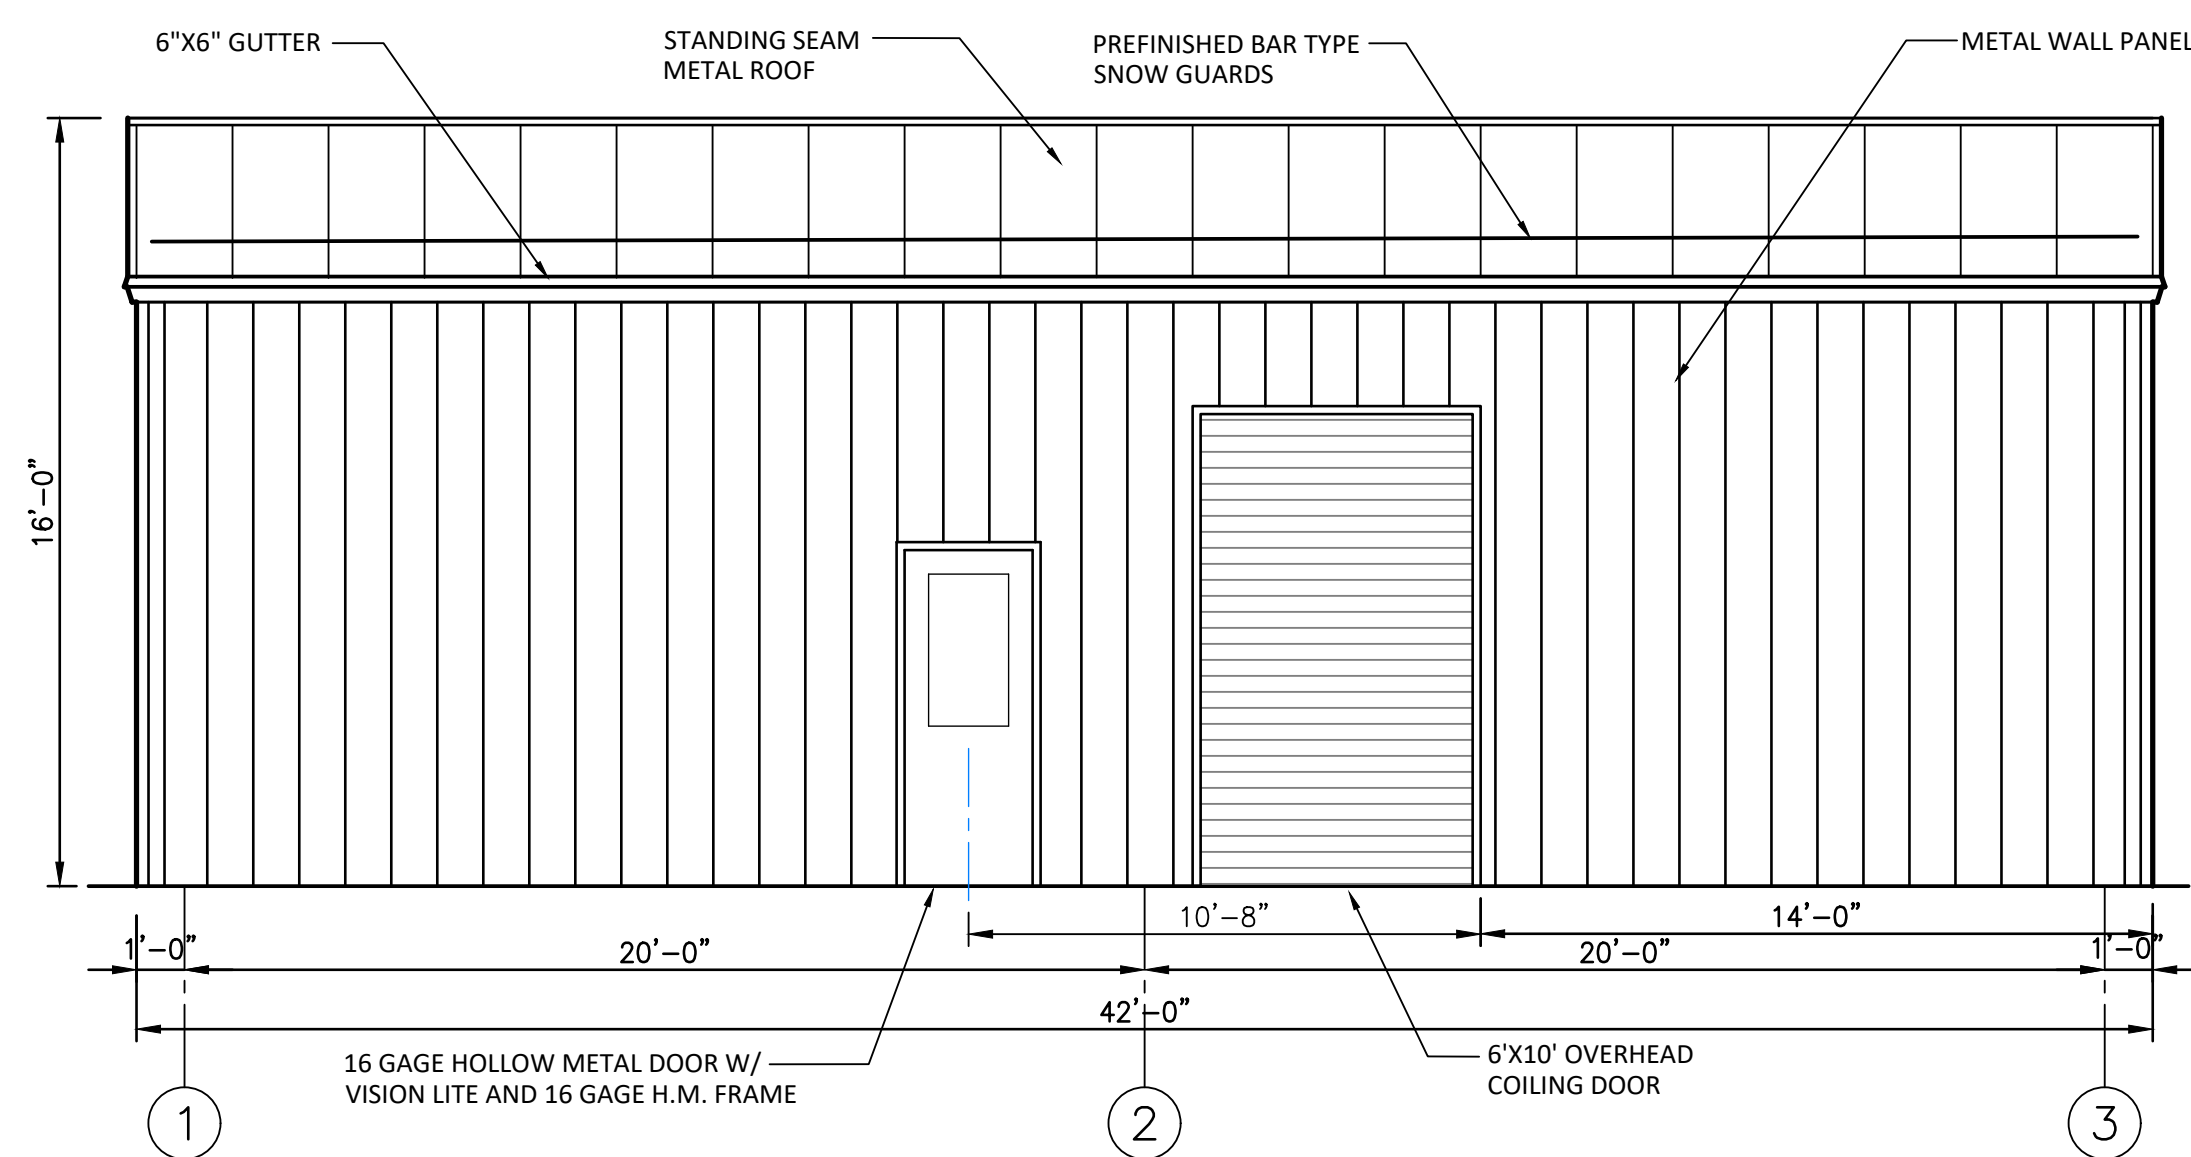

**NORTH ELEVATION**  
SCALE: 1/4"=1'-0"

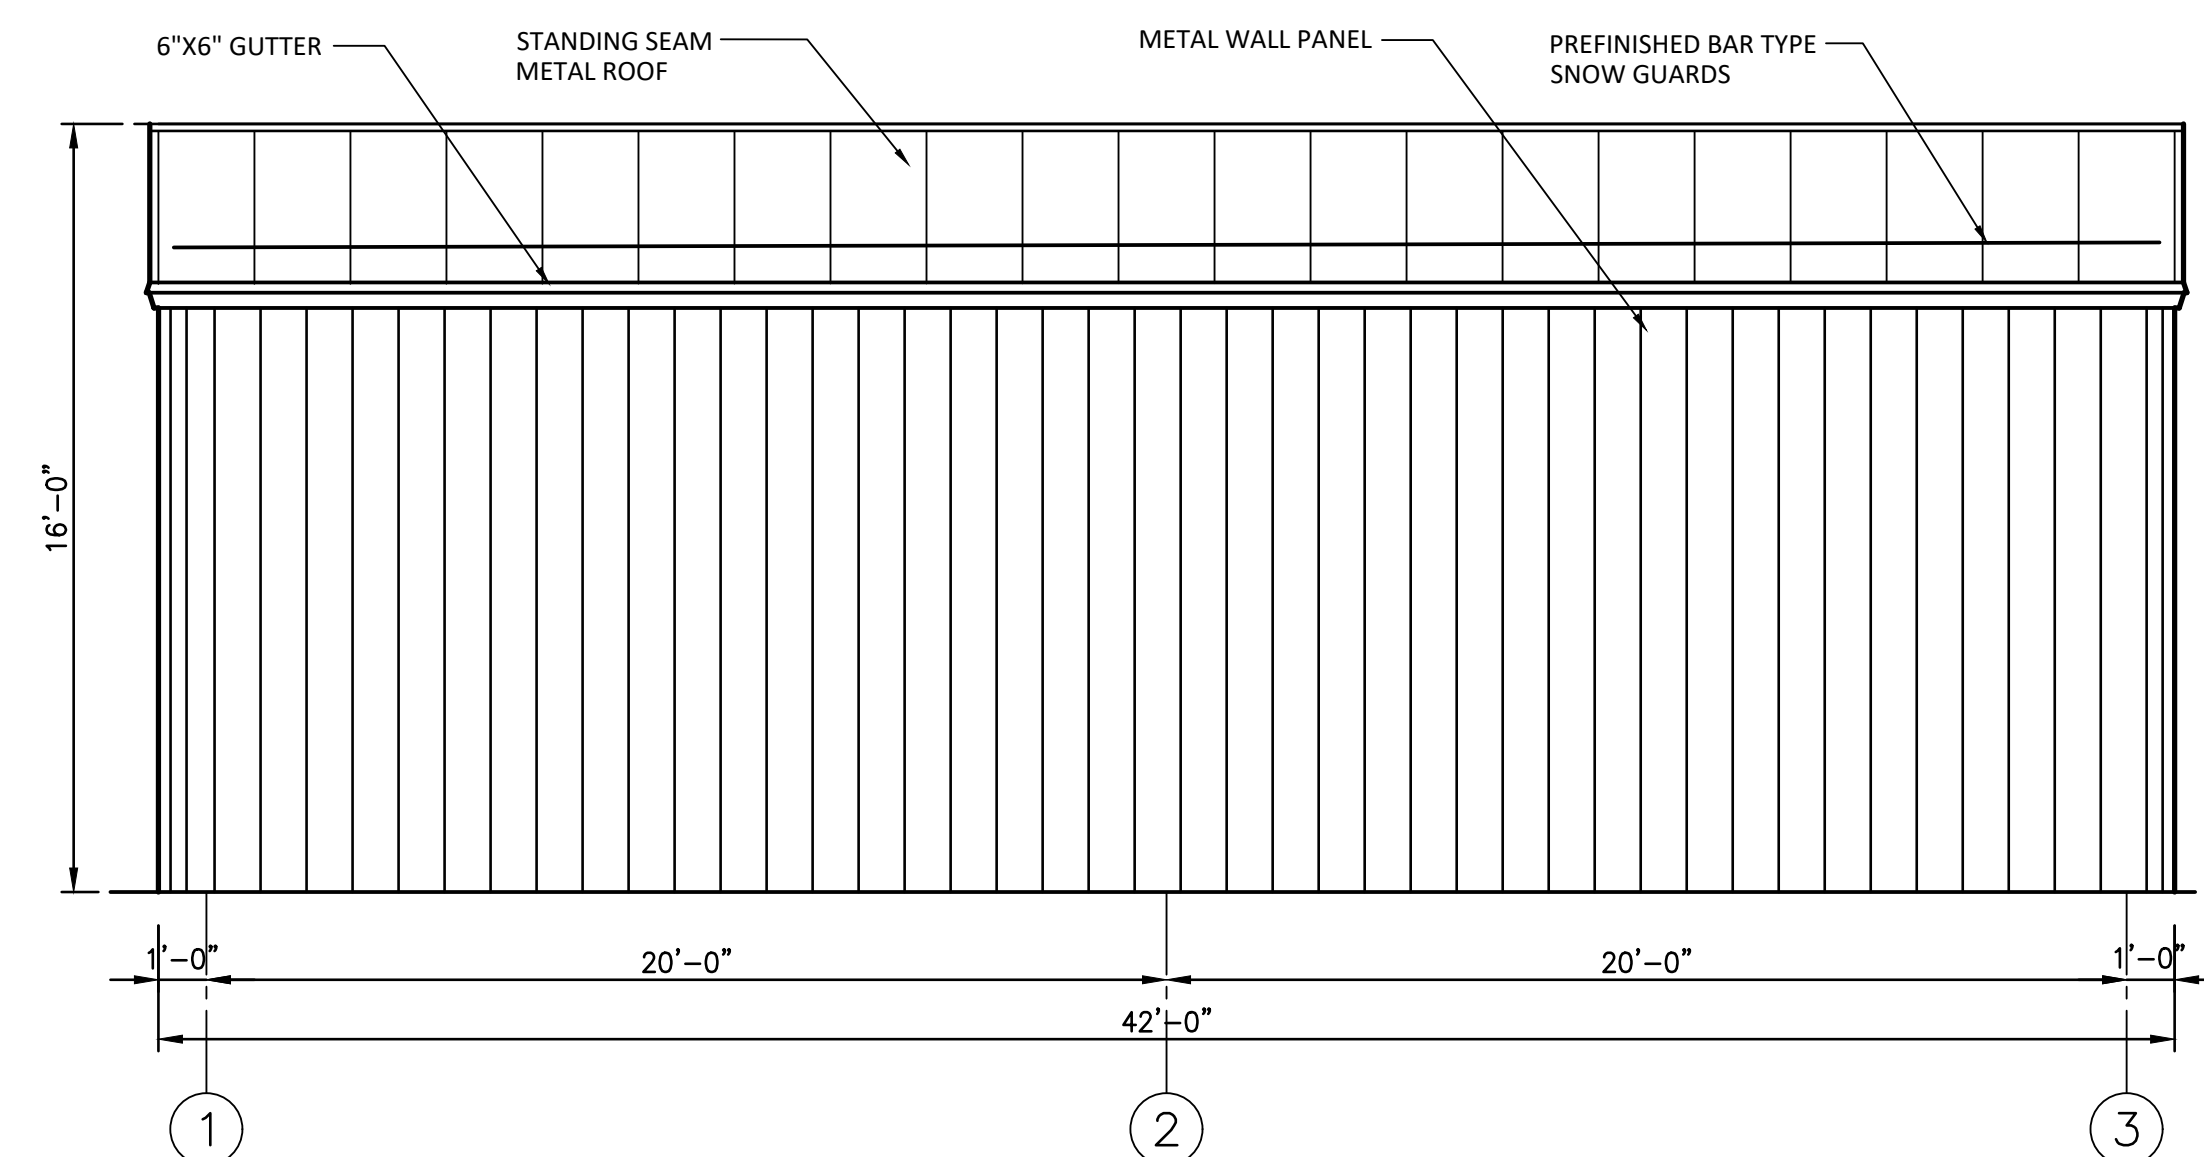

**SOUTH ELEVATION**  
SCALE: 1/4"=1'-0"



1. THE CONTRACTOR SHALL INVESTIGATE ACTUAL LOCATIONS OF UNDERGROUND LINES AND UTILITIES BEFORE EXCAVATING AND ADVISE ENGINEER OF ANY VARIATIONS. ALL EXCAVATIONS NEAR THESE LINES TO BE CARRIED OUT WITH EXTREME CAUTION.
2. THE CONTRACTOR SHALL CONTACT "MISS UTILITY OF VIRGINIA" 72 HOURS BEFORE ANY EXCAVATION WORK IS BEGUN. "MISS UTILITY OF VIRGINIA" MAY BE REACHED AT 1-800-552-7001.
3. THE CONTRACTOR SHALL REFER TO DRAWINGS OF OTHER TRADES AND VENDOR DRAWINGS FOR EMBEDDED ITEMS AND RECESSES NOT SHOWN ON THE STRUCTURAL DRAWINGS.
4. THE CONTRACTOR SHALL VERIFY ALL DIMENSIONS OF EXISTING CONSTRUCTION WHICH AFFECT NEW CONSTRUCTION AND REPORT VARIATIONS TO THE ENGINEER PRIOR TO SUBMISSION OF SHOP DRAWINGS.
5. THE CONTRACTOR SHALL VERIFY ALL SIZES AND LOCATIONS OF ALL MECHANICAL AND ELECTRICAL OPENINGS AND EQUIPMENT PADS WITH THE MECHANICAL AND ELECTRICAL EQUIPMENT DETAILS AND SHOP DRAWINGS. IT SHALL BE THE RESPONSIBILITY OF THE CONTRACTOR TO PROVIDE ALL OPENINGS AND SLEEVES FOR THE PROPER DISTRIBUTION OF ALL UTILITY LINES THROUGHOUT THE BUILDING.
6. SEE ARCHITECTURAL DRAWINGS FOR THE LOCATION OF WINDOW AND DOOR OPENINGS AND FOR OTHER INFORMATION NOT SHOWN.
7. THE CONTRACTOR SHALL PROVIDE ADEQUATE BRACING FOR THE STRUCTURE SO THAT IT WILL BE STABLE DURING ALL STAGES OF CONSTRUCTION. THE STRUCTURE AND FOUNDATIONS ARE DESIGNED FOR A COMPLETED CONDITION ONLY AND, THEREFORE, REQUIRE ADDITIONAL SUPPORT TO MAINTAIN STABILITY BEFORE COMPLETION.

1. THE CONTRACTOR SHALL VERIFY ALL DIMENSIONS, ELEVATIONS, ETC., NECESSARY FOR THE PROPER CONSTRUCTION AND ALIGNMENT OF THE NEW PORTIONS OF THE STRUCTURE TO THE EXISTING STRUCTURE. THE CONTRACTOR SHALL VERIFY ALL MEASUREMENTS NECESSARY FOR PROPER FABRICATION AND ERECTION OF ALL STRUCTURAL MEMBERS.
2. BEFORE PROCEEDING WITH ANY WORK WITHIN OR ADJACENT TO THE EXISTING STRUCTURE, THE CONTRACTOR SHALL BECOME FAMILIAR WITH EXISTING CONDITIONS. DURING THE PROCESS OF CONSTRUCTION, IT SHALL BE THE CONTRACTOR'S RESPONSIBILITY TO MAINTAIN THE INTEGRITY OF THE EXISTING STRUCTURE WHERE THE EXISTING STRUCTURE IS MODIFIED TO ACCOMMODATE NEW CONSTRUCTION AND TO PROTECT FROM DAMAGE THOSE PORTIONS OF THE EXISTING STRUCTURE, WHICH ARE TO REMAIN.
3. THE CONTRACTOR SHALL NOTIFY THE OWNER'S REPRESENTATIVE OF ANY EXISTING CONDITIONS THAT DIFFER FROM THOSE INDICATED ON THE DRAWINGS.


1. THE PRE-ENGINEERED BUILDING SHALL BE DESIGNED TO CONFORM TO THE DESIGN CRITERIA, LAYOUT AND DIMENSIONS SHOWN ON THE ARCHITECTURAL AND STRUCTURAL DRAWINGS AND IN THE SPECIFICATIONS. THE DESIGN SHALL BE PERFORMED AND SEALED BY A PROFESSIONAL ENGINEER LICENSED IN THE COMMONWEALTH OF VIRGINIA. LATERAL BRACING IN THE FORM OF PORTAL FRAMES AND X-BRACING SHALL BE LOCATED ONLY WHERE SHOWN ON THE STRUCTURAL DRAWINGS.
2. COLUMN BASE PLATES AND GIRT LINE DIMENSIONS SHALL BE DETAILED TO PROPERLY FIT ON THE CONCRETE PIERS SHOWN ON THE STRUCTURAL DRAWINGS. THE EDGE DISTANCE FROM THE EDGE OF THE BASE PLATE TO THE EDGE OF THE CONCRETE PIER SHALL BE 2" MINIMUM.

1. ALL STRUCTURAL STEEL, UNLESS OTHERWISE NOTED, SHALL CONFORM TO THE REQUIREMENTS OF ASTM A992 WIDE FLANGED SHAPES, AND ASTM A500 FOR HOLLOW STRUCTURAL SHAPES. ANGLES, PLATES, AND OTHER MISCELLANEOUS MEMBERS SHALL CONFORM TO THE REQUIREMENTS OF ASTM A36.
2. ALL DETAILING, FABRICATION AND ERECTION OF STRUCTURAL STEEL, UNLESS OTHERWISE NOTED, SHALL CONFORM TO THE REQUIREMENTS OF THE AISC SPECIFICATIONS FOR BUILDINGS, ASD DESIGN, 14TH EDITION.
3. UNLESS OTHERWISE NOTED, ALL SHOP CONNECTIONS SHALL BE MADE BY WELDING OR HIGH STRENGTH BOLTING (3/4" DIA. ASTM F3125 GRADE A325 BOLTS).
4. UNLESS OTHERWISE NOTED, WELDS SHALL BE MADE WITH E-70 ELECTRODES.
5. UNLESS OTHERWISE NOTED, ALL FIELD CONNECTIONS SHALL BE MADE WITH 3/4" DIA. HIGH STRENGTH BOLTS (ASTM F3125 GRADE A325). CONNECTIONS SHALL BE DESIGNED AS BEARING TYPE WITH THREADS IN THE SHEAR PLANE.
6. UNLESS OTHERWISE SHOWN, ALL BEAM CONNECTIONS SHALL BE STANDARD FRAMED, SEATED SINGLE-PLATE SHEAR CONNECTIONS AS SHOWN IN PART 4 OF THE AISC MANUAL OF STEEL CONSTRUCTION. SINGLE PLATE SHEAR CONNECTIONS MAY UTILIZE PLATES OR ANGLES. UNLESS REACTIONS ARE INDICATED ON THE PLANS, CONNECTIONS SHALL DEVELOP AT LEAST ONE-HALF OF THE TOTAL UNIFORM LOAD CAPACITY TABULATED IN THE TABLES OF THE MANUAL FOR THE GIVEN SHAPE AND SPAN OF THE BEAM IN QUESTION. HOWEVER, IN NO CASE SHALL THE LENGTH OF THE FRAMED CONNECTIONS BE LESS THAN ONE-HALF OF THE "T" DIMENSION OF THE BEAM WEB. ALSO, A 2-BOLT MINIMUM CONNECTION SHALL BE USED.
7. GUSSET PLATES SHALL BE 3/8" THICK MINIMUM.
8. ALL COLUMN ANCHOR BOLT HOLES SHALL BE OVERSIZED IN ACCORDANCE WITH THE RECOMMENDATIONS OF "AISC" MANUAL FOR "DETAILING FOR STEEL CONSTRUCTION".

MAPPED SPECTRAL RESPONSE ACCELERATION (SHORT PERIOD), $S_s$	.....	0.266	
MAPPED SPECTRAL RESPONSE ACCELERATION (1-SEC), $S_1$	.....	0.093	
DESIGN SPECTRAL RESPONSE ACCELERATION (SHORT PERIOD), $S_{D1}$	.....	0.281	
DESIGN SPECTRAL RESPONSE ACCELERATION (1-SEC), $S_{D1}$	.....	0.148	
SOIL SITE CLASSIFICATION	.....	D	
RISK CATEGORY	.....	III	
SEISMIC IMPORTANCE FACTOR	.....	1.25	
SEISMIC DESIGN CATEGORY	.....	C	
BUILDING SYSTEM	.....	TO BE DETERMINED BY	PEMB DESIGNER
SEISMIC-FORCE-RESISTING SYSTEMS	.....	TO BE DETERMINED BY	PEMB DESIGNER
RESPONSE MODIFICATION FACTOR	.....	TO BE DETERMINED BY	PEMB DESIGNER
SYSTEM OVER-STRENGTH FACTOR	.....	TO BE DETERMINED BY	PEMB DESIGNER
DEFLECTION AMPLIFICATION FACTOR	.....	TO BE DETERMINED BY	PEMB DESIGNER
SEISMIC RESPONSE COEFFICIENT ( $C_s$ )	.....	TO BE DETERMINED BY	PEMB DESIGNER
PROCEDURE USED	.....	TO BE DETERMINED BY	PEMB DESIGNER






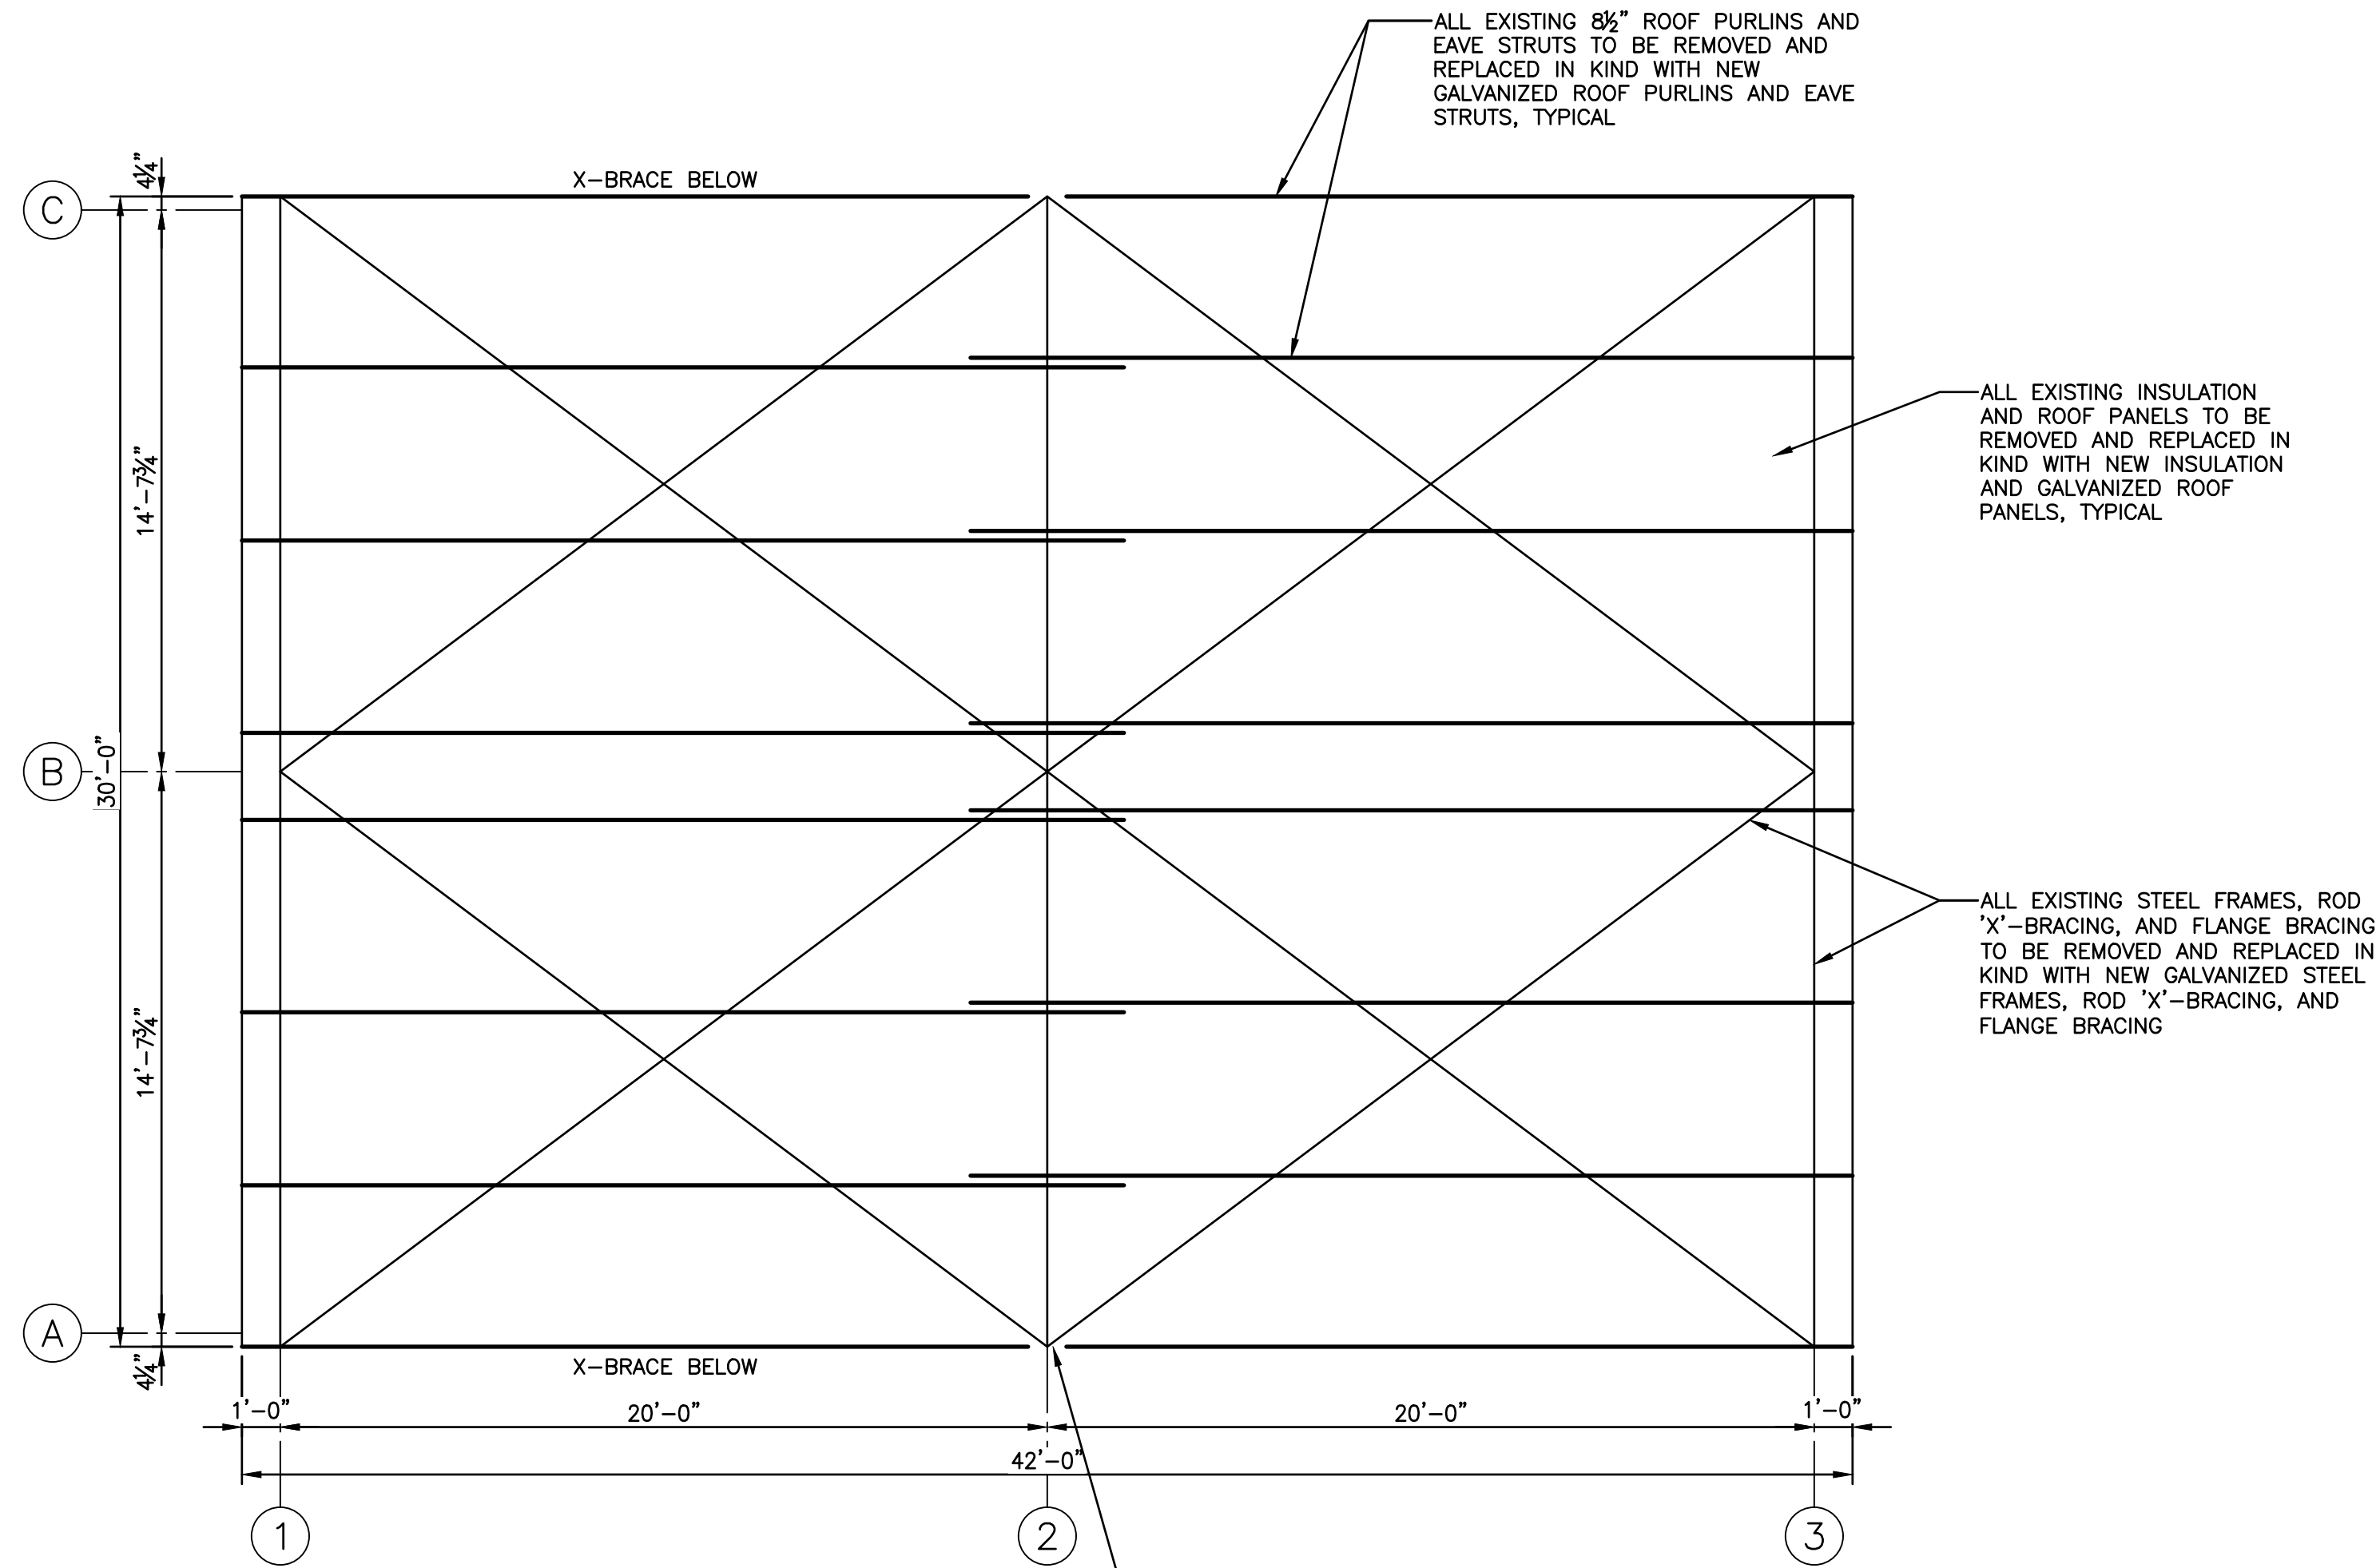

## ROOF FRAMING PLAN


SCALE:  $\frac{1}{4}$ "=1'-0"

PLAN NORTH

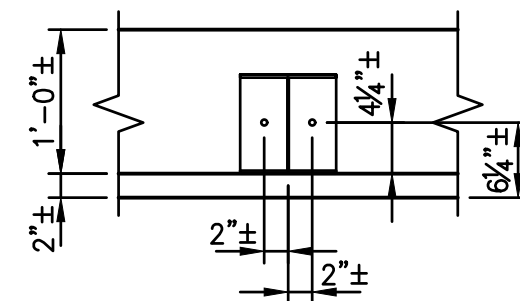

TYPICAL DETAIL-EXISTING PEMB  
ANCHOR BOLT LAYOUT


NOT TO SCALE

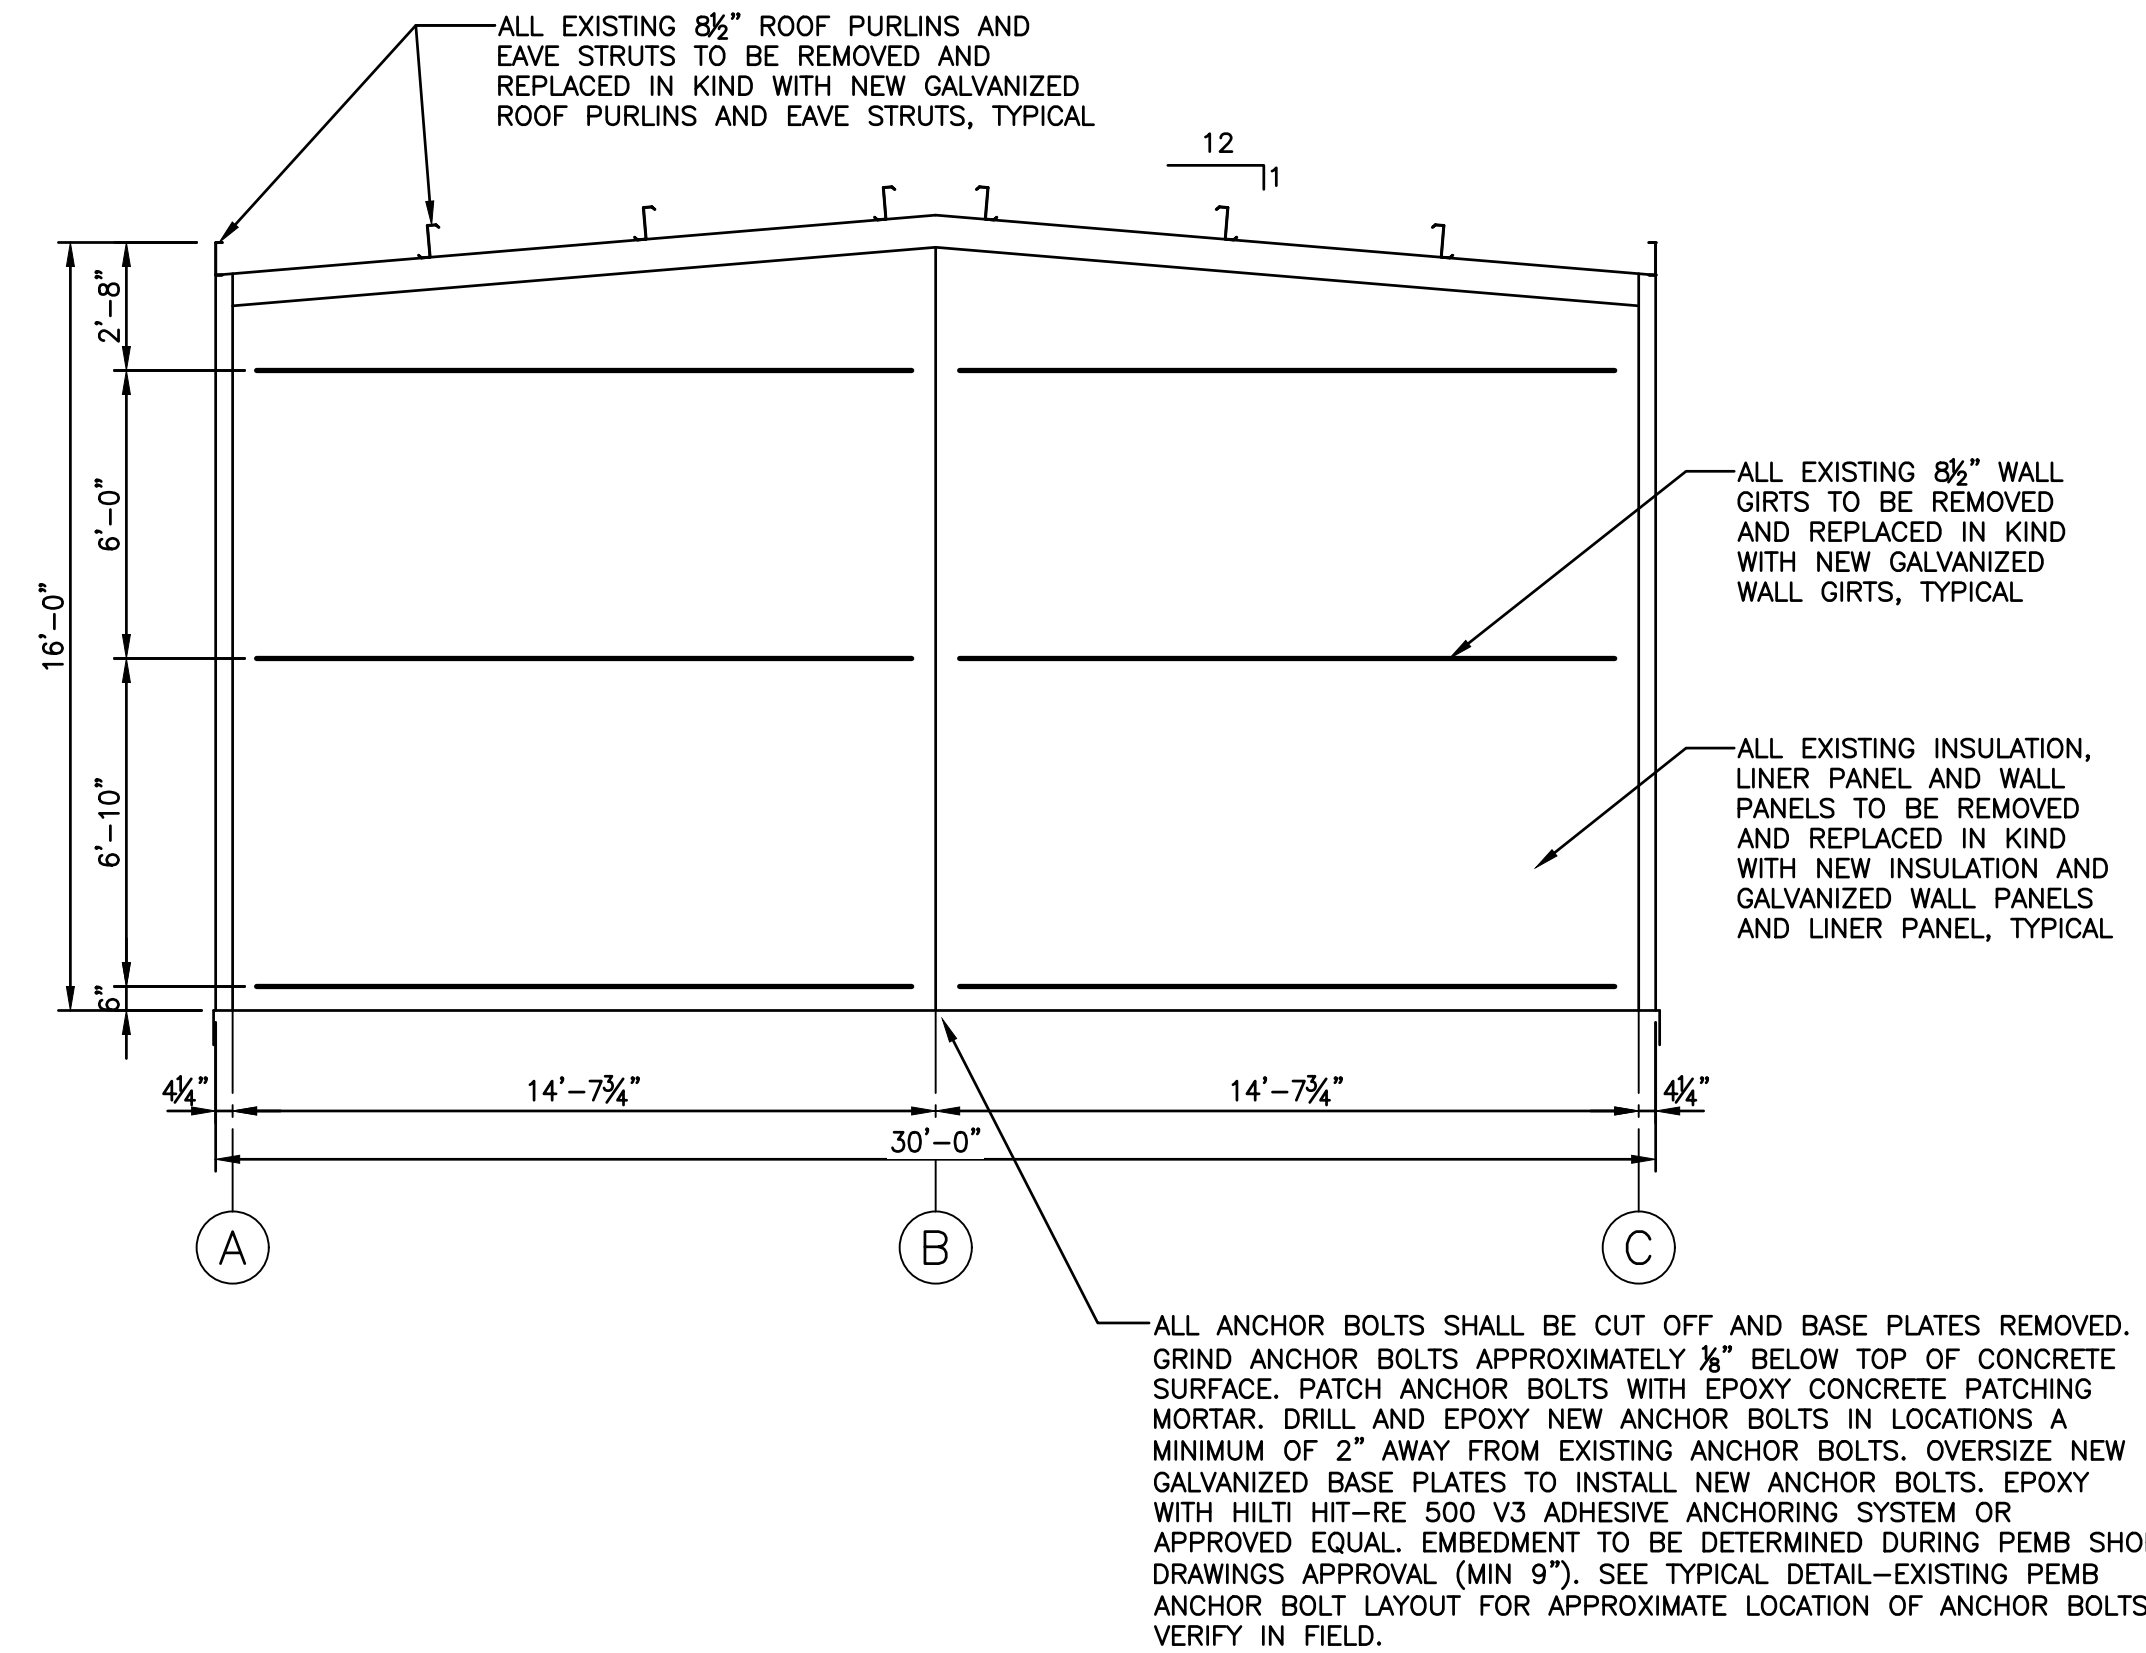

## END ELEVATION

SCALE:  $\frac{1}{4}$ "=1'-0"


PLAN NORTH

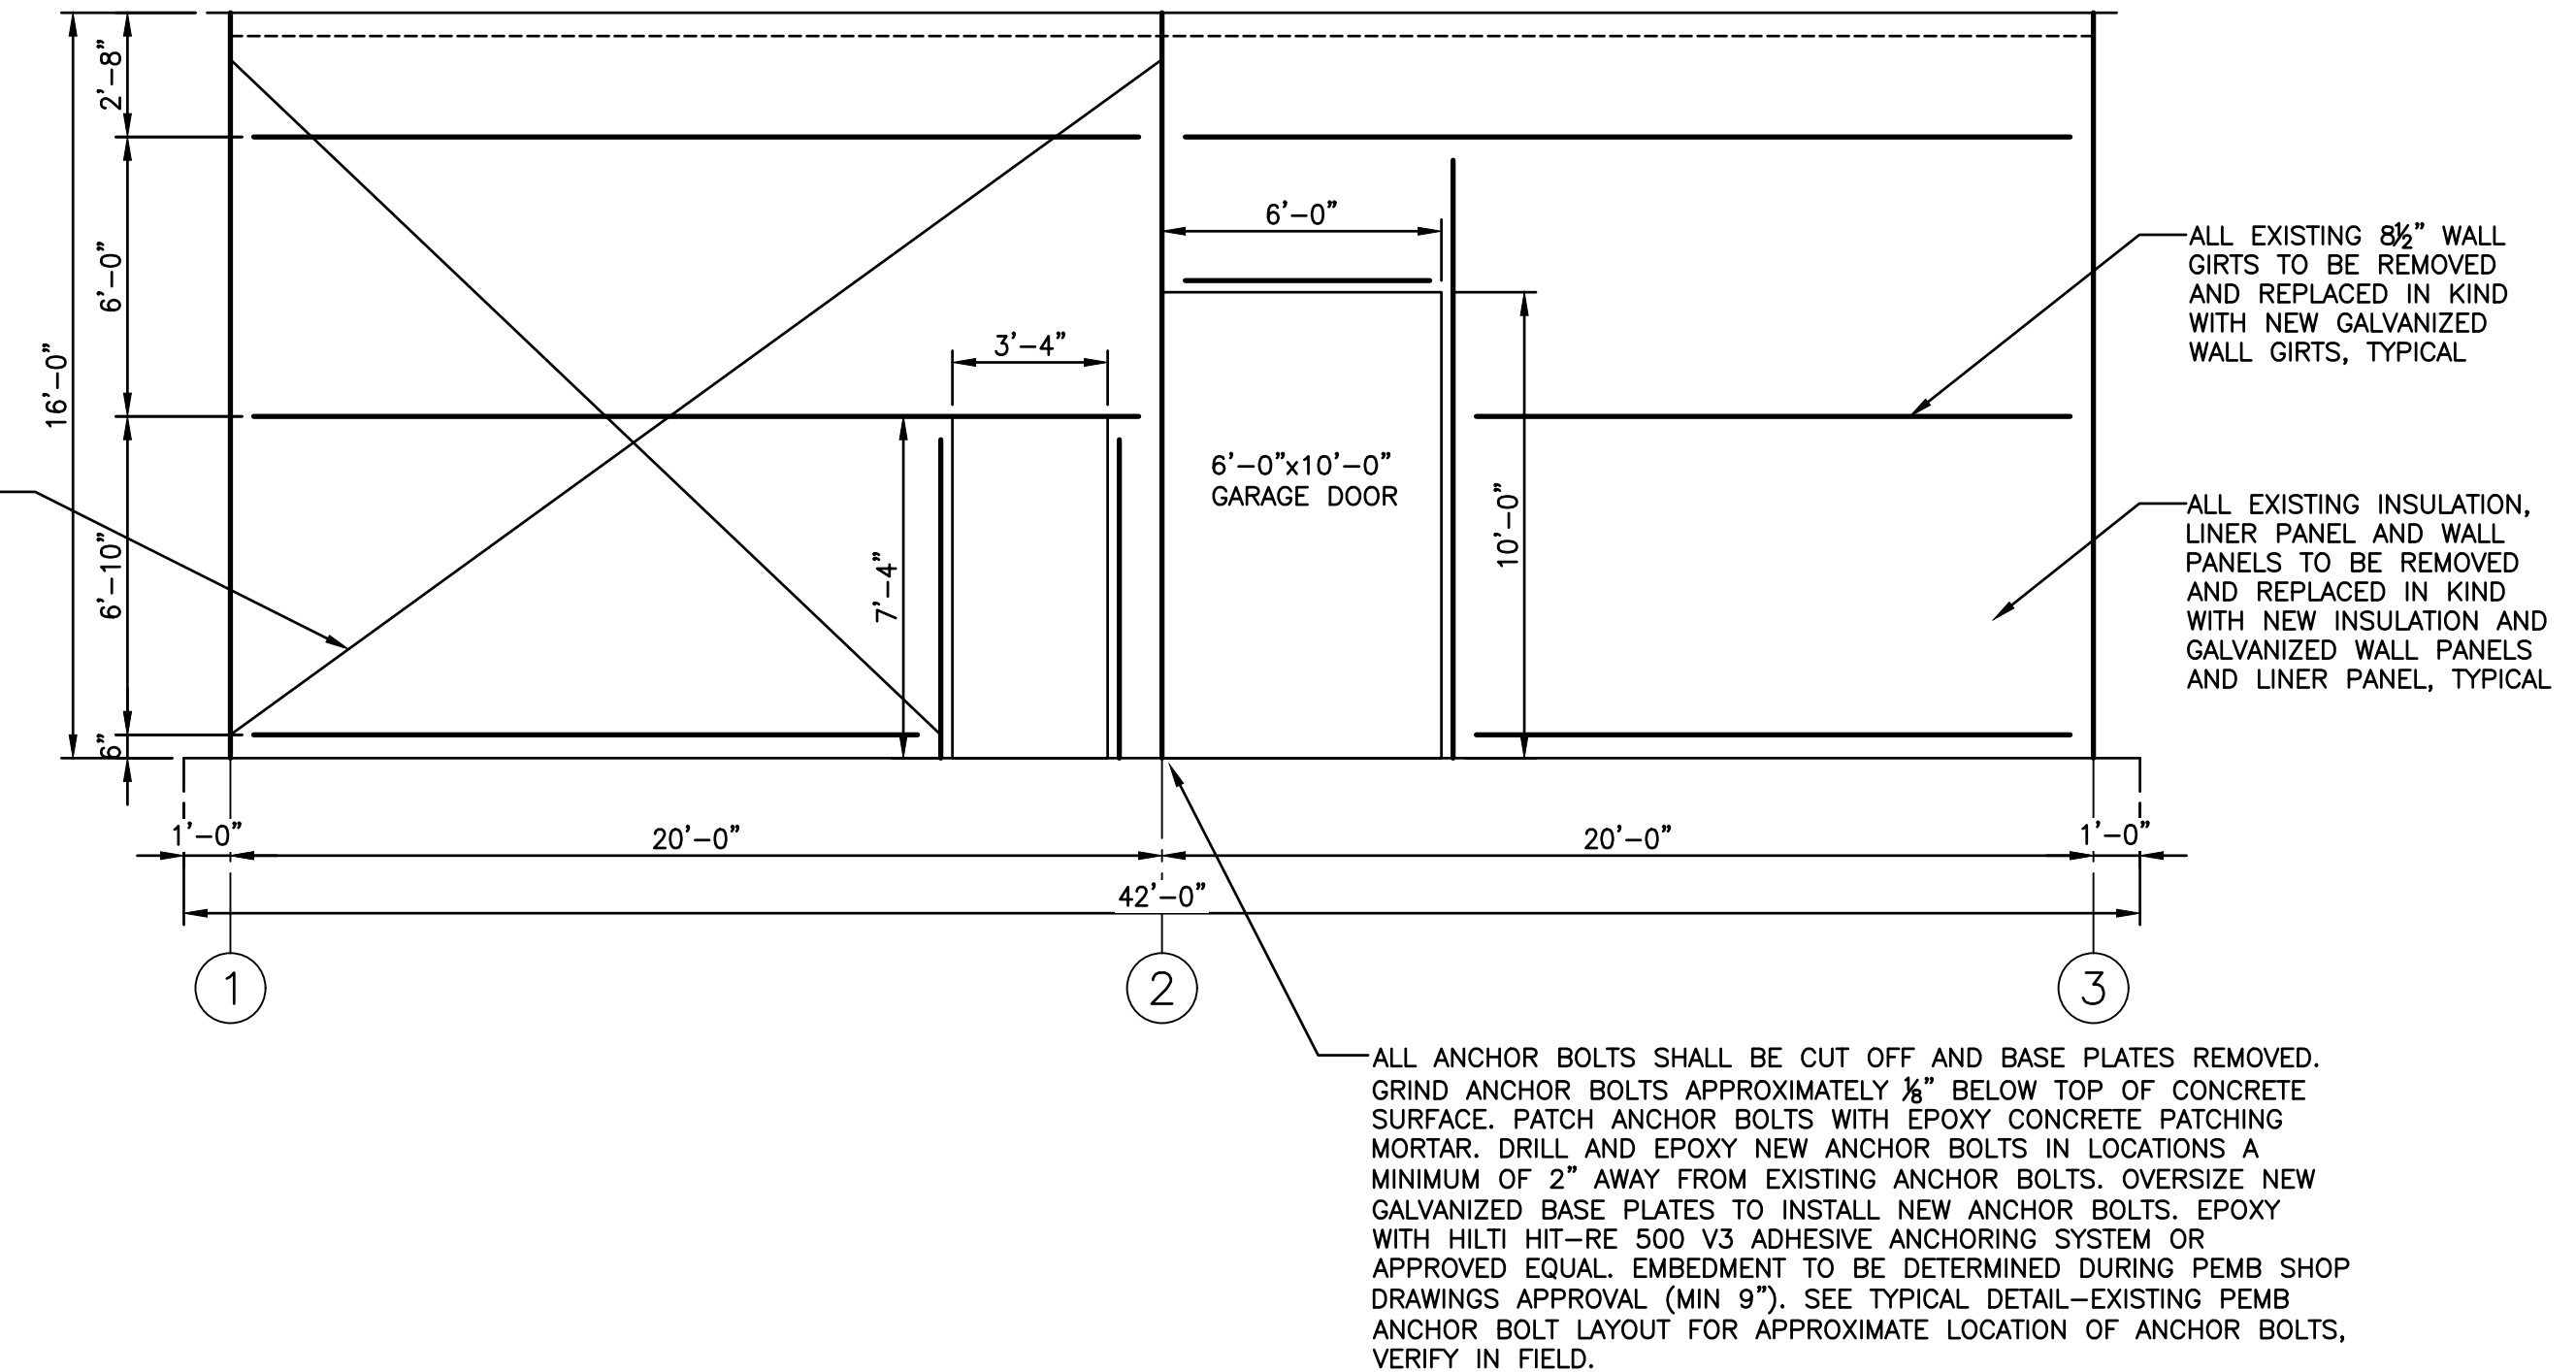

## SIDE ELEVATION

SCALE:  $\frac{1}{4}$ "=1'-0"

PLAN NORTH

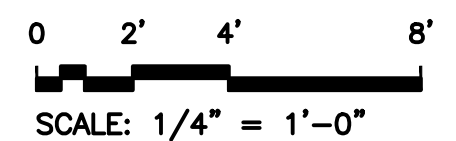

TOWN OF RICHLANDS - 4.0 MGD WWTP  
UPGRADES AND IMPROVEMENTS

## EXISTING PRELIMINARY TREATMENT BUILDING PLAN

No.	Date	Purpose of Document Issue
	10-21-20	ISSUED FOR 60% REVIEW
	02-26-21	ISSUED FOR 100% REVIEW
	08-27-21	ISSUED FOR BID

Designed	RHT
Drawn	MLT
Checked	KAA
Date	08-27-2021


Project No.  
14249-00



Sheet No.

S102



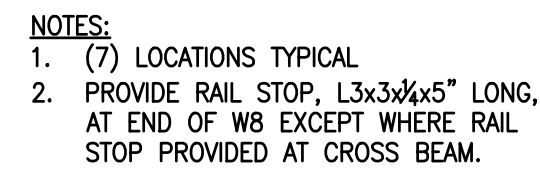

1'-9"

EXISTING W12  
T.O.S. = 14'-8 1/2"  
FIELD VERIFY

ELEV. = 14'-4 1/2"

W6x26 BEAM

ELEV. = 14'-0"

W8x21 BEAM;  
SEE NOTE

EXIST. C8 - CUT OFF  
AND CONNECT TO W12  
T.O.S. = 13'-11"  
FIELD VERIFY

NOTE:  
PROVIDE RAIL STOP, L3x3x $\frac{1}{4}$ x5" LONG,  
AT EACH END OF W8

6" TYP.

EXISTING W12 BEAM

FIELD VERIFY ELEV.=13'-8" A.F.F.

EL=13'-2" A.F.F.

HSS4x4x $\frac{1}{4}$ "

W8x21 BEAM

RAIL STOP:  
L3x3x $\frac{3}{4}$ x5" LONG

3"

1.5-TON HOIST SEE  
SPECIFICATIONS

$\frac{3}{16}$ "

W8x21 BEAM WITH  
 HORZ. SLOTTED HOLES  
 3/4" A325 BOLTS  
 TYPICAL  
 PL 1/2"x12x12  
 1" DIA. THRU-BOLTS  
 USE 1/2" PLATE WASHERS  
 ON BACK SIDE OF CMU  
 WALL, TYPICAL

**NOTES:**

1. (3) LOCATIONS TYPICAL.
2. VERIFY CELLS WITH THRU-BOLTS ARE FILLED OR BLOCK IS SOLID. NOTIFY ENGINEER IF BLOCK IS NOT SOLID OR FILLED

EXISTING CONCRETE CEILING  
ELEV. = 11'-9" A.F.F.

EXISTING CONCRETE BEAM

12x6x $\frac{3}{8}$ " PL. WITH (2)  $\frac{3}{4}$ " DIA. BOLTS EPOXY-GROUT WITH HILTI HY-200 EMBEDMENT = 4"

ELEV. = 10'-0" A.F.F.  
FIELD VERIFY

3" STANDARD PIPE POST

EXISTING CONCRETE CURB

VERTICAL LONG-SLOTTED HOLES IN BEAM WEB

ELEV. = 11'-3" A.F.F.

W8x21

$\frac{3}{16}$ "

6x4x $\frac{5}{8}$ " CAP PL.

9x4x $\frac{5}{8}$ " BASE PL. (2)  $\frac{3}{4}$ " DIA. BOLTS EPOXY-GROUT WITH HILTI HY-200 EMBEDMENT = 4"

EXIST CONG SLAB

2 $\frac{1}{2}$ "

2"

10"

EXISTING CONCRETE CEILING

1" GALV THRU-BOLTS  
TYPICAL - (4) AT EACH  
END AND STAGGER AT  
1'-0" O.C. BETWEEN

ELEV. = 11'-9" A.F.F.

ELEV. = 11'-5" A.F.F.

C15x33.9 EA SIDE

W8x21 BEAM WITH  
HORZ. SLOTTED HOLES

ELEV. = 9'-4" A.F.F.

EXISTING DOOR  
OPENING

1'-6"±

5'-4"±

1'-4"±



The diagram illustrates the process of repairing a handrail. It shows a cross-section of a concrete wall and a concrete slab. An existing handrail is shown being removed, with a note indicating to 'REMOVE EXISTING GUARDRAIL'. A new handrail is shown being installed, with a note indicating to 'CUT EXISTING HANDRAIL FLUSH WITH TOP OF CONC CURB WELD 3/8" CAP PL. ON END'. The new handrail is shown being welded to an 'EXST CONC BEAM' and an 'EXST CONC SLAB'. A note indicates to 'REMOVE PAINT BEFORE WELDING'. The new handrail is shown being welded to an 'L3x3x1/2x9" LONG, PAINTED BLUE W/ 2-3/8" EXPANSION ANCHOR W/ 4" EMBEDMENT'.

NOTE:  
TOUCH UP PAINT AFTER  
WELD HANDRAIL TO ANGLE

Technical drawing of a bridge deck cross-section showing the placement of fiberglass grating and saddle clips. The drawing includes the following labels and dimensions:

- FIBERGLASS 12x2x1/4 SADDLE CLIPPED TO GRATING**: Points to the saddle clips.
- 3'-0"**: Dimension for the total width of the grating area.
- FIBERGLASS GRATING, MS-1-4010 DURAGRID OR APPROVED EQUAL, 2 PCS 2'-6" WIDE, 1 PCS 2'-0" WIDE**: Points to the fiberglass grating.
- EXST CONC WALL**: Points to the existing concrete wall.
- EXST CONC BEAM**: Points to the existing concrete beam.
- EXST CONC SLAB**: Points to the existing concrete slab.
- 2'-1 1/2" ±**: Dimension for the width of the grating area.
- 2'-2" ±**: Dimension for the width of the grating area.

NOT TO SCALE

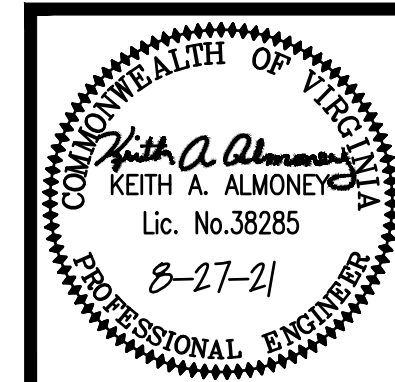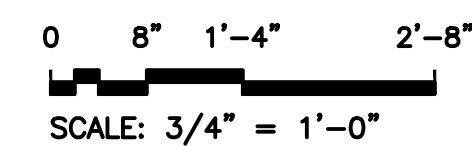TOWN OF RICHLANDS - 4.0 MGD WWTP  
UPGRADES AND IMPROVEMENTS

## SECTIONS AND DETAILS

[illegible]

Designed	RHT
Drawn	MLT
Checked	KAA
Date	08-27-2021

Project No.  
14249-00



THOMPSON  
& LITTON

Sheet No.

# S300



EXHAUST FAN SCHEDULE													
MARK	MANUFACTURER AND MODEL NO.	CFM	SP. WG	MOTOR		TYPE	SONES	FAN RPM	T.S.	LOCATION	CONTROL	WEIGHT (LBS.)	NOTES
				HP	VOLTS Ø								
F-11	GREENHECK CUBE-141	2,300	0.3	1/2	115/1	UPBLAST	13.6	1383	5,295	PUMP STATION-DRY WELL	TSTAT/HUMIDISTAT	100	2,4,5,9,16
F-10	GREENHECK USF-15-B3	1,600	0.5	1/2	115/1	UTILITY	62 dBA	1094	4,295	PUMP STATION-WET WELL	CONTINUOUS	150	6,7,12,13,14,15,16,17,18
F-16	GREENHECK USF-15-B3	1,600	0.5	1/2	115/1	UTILITY	62 dBA	1094	4,295	PUMP STATION-WET WELL	CONTINUOUS	150	6,7,12,13,14,15,16,17,18
F-17	GREENHECK USF-15-B3	1,600	0.5	1/2	115/1	UTILITY	62 dBA	1094	4,295	PUMP STATION-WET WELL	CONTINUOUS	150	6,7,12,13,14,15,16,17,18
F-12	GREENHECK CUBE-141	1,450	0.3	1/4	115/1	UPBLAST	8.6	1726	3,753	PUMP STATION-LIME WELL	TSTAT/HUMIDISTAT	100	2,4,5,9,16
F-3	GREENHECK AER-E30C-310-VG	3500	0.25	3/4	115/1	PROPELLER	16.6	977	7,707	PRETREATMENT (GRIT) BUILDING	TSTAT/HUMIDISTAT	150	1,2,3,4,6,7,8
F-4	GREENHECK SQ-160-B	2600	0.3	1/2	115/1	INLINE	9.7	1022	NA	PRETREATMENT (GRIT) BUILDING	TSTAT/HUMIDISTAT	175	1,2,4,10,11,16

- NOTES:
1. PROVIDE REMOTE SPEED CONTROLLER
  2. PROVIDE DISCONNECT SWITCH
  3. PROVIDE OSHA MOTOR GUARD, WALL HOUSING, GRAVITY DAMPER, WEATHERHOOD WITH BIRDSCREEN – WEATHERHOOD, HOUSING, AND GRAVITY DAMPER SHALL HAVE HI PRO POLYESTER COATING
  4. PROVIDE COMBINATION HUMIDISTAT/THERMOSTAT EQUAL TO ILIVING MODEL ILG-001TH
  5. PROVIDE INSULATED ROOF CURB WITH CURB SEAL
  6. FAN TO HAVE TEAO OR TEFC MOTOR
  7. FAN TO HAVE HI PRO POLYPROYLENE COATING
  8. FAN SHALL HAVE CORROSION RESISTANT FASTENERS
  9. PROVIDE BIRDSCREEN AND GRAVITY DAMPER, INTERLOCK FAN WITH MOTORIZED DAMPER ON CORRESPONDING GRAVITY VENTILATOR
  10. PROVIDE HANGING NEOPRENE ISOLATORS
  11. PROVIDE BACKDRAFT DAMPER
  12. FAN SHALL BE TYPE A SPARK RESISTANT CONSTRUCTION WITH EXPLOSION PROOF MOTOR AND SHALL BE UL LISTED
  13. PROVIDE NEMA-7 AND 9 CLASS 1 & DIVISION 1 DISCONNECT SWITCH, EXTENDED LUBE LINES, 1" DRAIN CONNECTION – PIPE THREADED IN LOWEST POINT OF FAN HOUSING, INLET FLANGE, OUTLET FLANGE, STEEL WEATHERHOOD, HIGH TEMPERATURE SHAFT SEAL, DIRECT MOUNT ISOLATORS – SPRING RESTRAINED-1", BEARINGS WITH L(10) LIFE OF 80K HOURS, WELDED SCROLL HOUSING, BACKWARD INCLINED WHEEL, UL LISTED, BOLTED ACCESS DOORS, EQUIPMENT SUPPORTS, CLASS 1 CONSTRUCTION
  14. COAT ALUMINUM DUCT FLANGES WITH MASTIC WHERE STAINLESS STEEL DUCTWORK CONNECTS TO FAN.
  15. USE WELL NUTS TO CONNECT STAINLESS STEEL TO FAN DUCT FLANGES, WELL NUTS CONSIST OF EPDM FASTENER WITH A HIDDEN BRASS NUT NEAR THE END
  16. PROVIDE FLEXIBLE DUCT CONNECTIONS
  - 17 FAN SHALL NOT HAVE A BACKDRAFT DAMPER
  - 18 FAN SHALL RUN CONTINUOUSLY

ELECTRIC HEATER SCHEDULE									
MARK	STANDARD OF PERFORMANCE	LOCATION	AIRFLOW CFM	TYPE	ELECTRICAL				
					VOLTAGE/PHASE	KW	AMPS	NOTES	
UH-6	MARKEL P3PUH07CA1	PUMP STATION – UPSTAIRS	575	UNIT HEATER	480/3	7.5	9.1	1,2,3,4	
UH-7	MARKEL P3PUH07CA1	PUMP STATION – ELECTRICAL	575	UNIT HEATER	480/3	7.5	9.1	1,2,3,4	
UH-8	MARKEL P3PUH07CA1	PUMP STATION – DRY WELL	575	UNIT HEATER	480/3	7.5	9.1	1,2,3,4	
UH-9	MARKEL P3PUH07CA1	PUMP STATION – WET WELL	575	UNIT HEATER	480/3	7.5	9.1	1,2,3,4	
UH-1	MARKEL P3PUH20CA1	PRETREATMENT (GRIT) BUILDING	1350	UNIT HEATER	480/3	20	24.1	1,2,3,4	
UH-2	MARKEL P3PUH20CA1	PRETREATMENT (GRIT) BUILDING	1350	UNIT HEATER	480/3	20	24.1	1,2,3,4	
UH-3	MARKEL P3PUH03CA1	PRETREATMENT (GRIT) BUILDING	400	UNIT HEATER	480/3	3.3	4	1,2,3,4	


- NOTES:
1. PROVIDE UNIT MOUNTED THERMOSTAT
  2. PROVIDE DISCONNECT SWITCH
  3. PROVIDE WALL BRACKET
  4. PROVIDE SUMMER FAN SWITCH

GRAVITY VENTILATOR SCHEDULE									
MARK	STANDARD OF PERFORMANCE	LOCATION	AIRFLOW CFM	ESP (IN WG)	INTAKE	EXHAUST	THROAT VELOCITY FPM	THROAT AREA FT^2	
GV-1	GREENHECK WIH 24X24	PUMP STATION-DRY WELL	2,300	0.07	Y	–	375	4.0	
GV-2	GREENHECK WIH 36X36	PUMP STATION-WET WELL	4,800	0.052	Y	–	550	9.0	
GV-3	GREENHECK WIH 28X28	PUMP STATION-LIME WELL	1,450	0.1	Y	–	450	5.44	
GV-4	GREENHECK GRSR-24	PRETREATMENT (GRIT) BUILDING	2,600	0.08	–	Y	802	3.24	
GV-5	GREENHECK WIH 24X24	PRETREATMENT (GRIT) BUILDING	2,600	0.072	Y	–	650	4.0	

- NOTES:
1. PROVIDE ROOF CURB ADAPTER FOR INSTALLATION OF INTAKE HOODS ON EXISTING CURB FOR MAIN PUMP STATION
  2. PROVIDE INSULATED ROOF CURB WITH CURB SEAL
  3. DO NOT PROVIDE A INSECT SCREEN OR BACKDRAFT DAMPER FOR GV-2
  4. ACCEPTABLE MANUFACTURERS: GREENHECK, COOK.
  5. INTERLOCK GV-1 WITH F-11
  6. INTERLOCK GV-2 WITH F-10, F-16, AND F-17
  7. INTERLOCK GV-3 WITH F-12
  8. INTERLOCK GV-5 WITH F-4



LOUVER SCHEDULE													
MARK	MANUFACTURER AND MODEL NO.	LOCATION	CFM	APD	FA FT2	VEL	INTAKE	EXHAUST	SIZE			ACCESSORIES	MAT'L
									W	H	D		
L-1	GREENHECK ESD-635	GRIT BUILDING	3500	0.1	4.32	810	Y	–	36	36	6	1,2,3,5,8	ALUM

- ACCESSORIES:
1. LOUVER SHALL HAVE DRAINABLE BLADES
  2. LOUVER SHALL HAVE INSECT SCREEN
  3. 120V MOTORIZED BACKDRAFT DAMPER
  4. LOUVER SHALL HAVE 2-COAT 70% KYNAR COATING FOR HYDROGEN SULFIDE, METHANE AND CARBON MONOXIDE ENVIRONMENT
  5. INTERLOCK F-3 WITH L-1

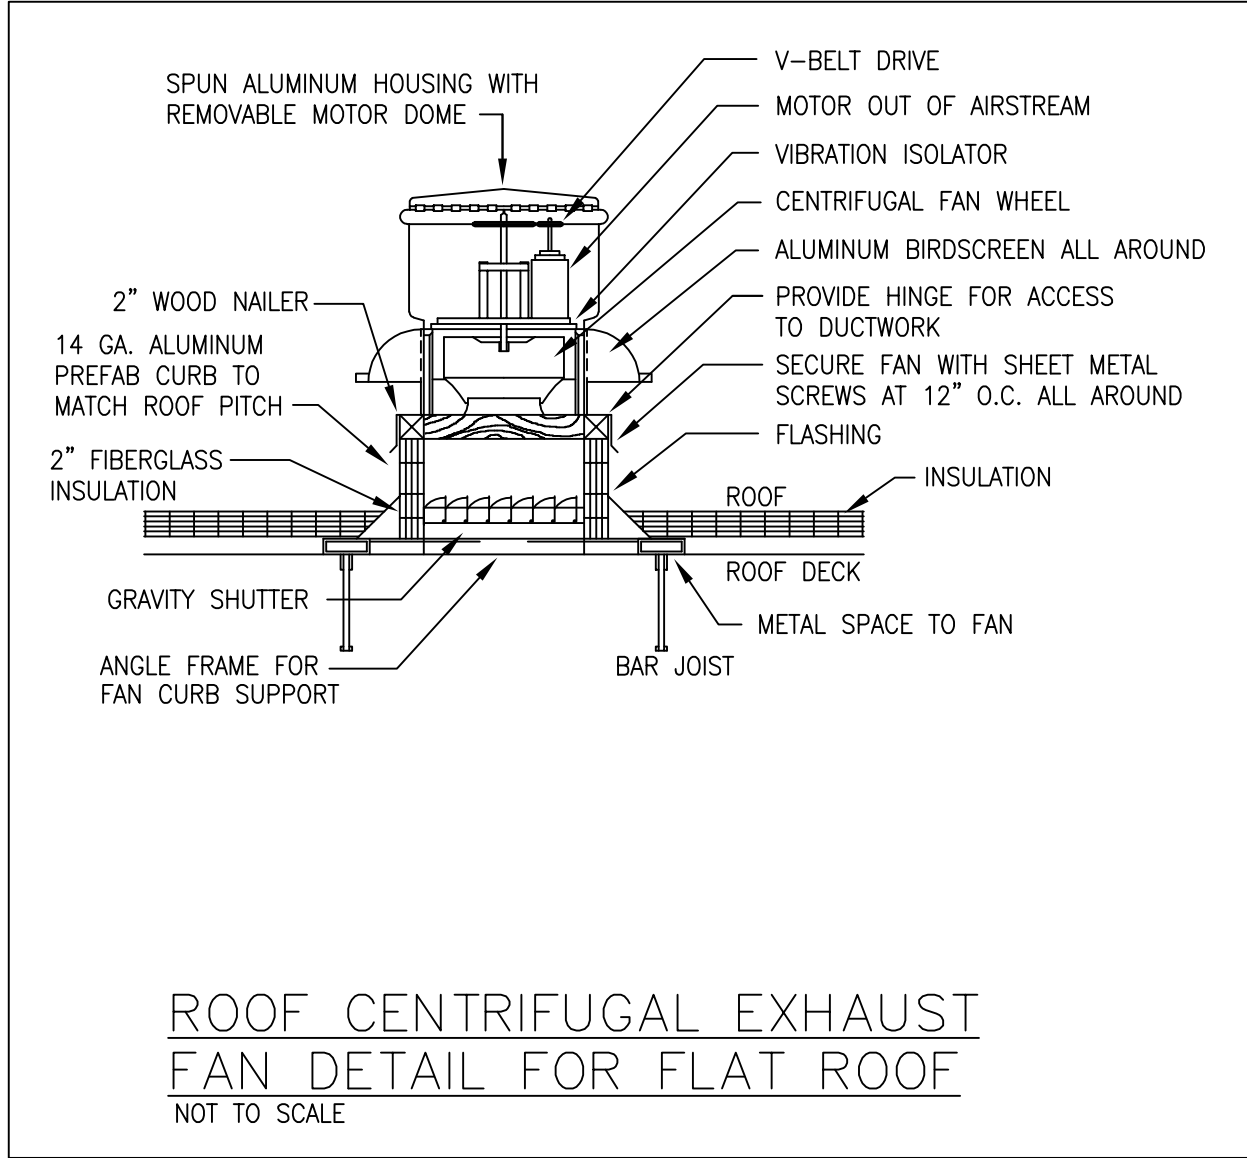

H.V.A.C. LEGEND AND SYMBOLS		
	12x8	SUPPLY, EXHAUST, RETURN DUCT
	12x8	BRANCH TAKE-OFF
	12x8	TAKE-OFF WITH SPIN-IN FITTING
		SPIN-IN TAKE-OFF IN BOTTOM OF DUCT
		SQUARE TURN WITH DOUBLE THICKNESS TURNING VANES
		FULL RADIUS ELBOW
		VERTICAL RISE OR DROP IN SUPPLY DUCT
		VERTICAL RISE OR DROP IN RETURN/EXHAUST DUCT
		MANUAL BALANCING DAMPER
		MOTORIZED DAMPER
		LOUVER WITH BIRD SCREEN

- GENERAL MECHANICAL NOTES
1. FRESH AIR INTAKES SHALL NOT BE LOCATED CLOSER THAN 10 FEET FROM ANY EXHAUST OR OUTLET VENT.
  2. COORDINATE GRILLE, REGISTER AND DIFFUSER LOCATIONS WITH LIGHTING AND CEILING GRID LAYOUT.
  3. CONTRACTOR SHALL FIELD VERIFY ALL EXISTING CONDITIONS PRIOR TO SUBMITTING A BID.
  4. WORKMANSHIP: MECHANICAL EQUIPMENT AND ACCESSORIES SHALL BE INSTALLED IN A NEAT WORKMANLIKE MANNER. UNSIGHTLY INSTALLATIONS SHALL BE REMOVED OR REWORKED AT NO EXPENSE TO THE OWNER.
  5. ALL EXPOSED DUCTWORK AND ACCESSORIES SHALL BE FURNISHED WITH A PAINTABLE FINISH.
  6. COORDINATE MOUNTING HEIGHT OF EXPOSED DUCTWORK WITH LIGHTING.
  7. WHERE DUCTWORK CAN BE SEEN THRU GRILLES; PAINT DUCT WITH FLAT BLACK ENAMEL PAINT.
  8. DUCTWORK DIMENSIONS GIVEN ARE INSIDE CLEAR. SEE SPECIFICATIONS FOR INSULATION REQUIREMENTS.
  9. REFER TO ELECTRICAL AND PLUMBING DRAWINGS FOR ADDITIONAL COORDINATION WITH THESE DRAWINGS.
  10. CONTRACTOR SHALL VERIFY ELECTRICAL VOLTAGE, LOADS ETC. WITH ELECTRICAL TRADE, OR EXISTING CONDITIONS, PRIOR TO ORDERING EQUIPMENT.
  11. SEAL ALL WALL, ROOF AND FLOOR PENETRATIONS BY MECHANICAL AND ELECTRICAL SERVICE AIRTIGHT.
  12. EQUIPMENT SIZES AND SERVICE SPACE REQUIREMENTS MAY VARY BETWEEN DIFFERENT MANUFACTURERS. CONSULT APPROVED MANUFACTURER AS SUBMITTED, AND COORDINATE WITH THESE DRAWINGS.
  13. COORDINATE ALL PENETRATIONS OF FLOOR SLABS, ROOF AND WALLS WITH STRUCTURAL DRAWINGS.
  14. PROVIDE COMPANION OPPOSED BLADE VOLUME DAMPERS WITH ALL DIFFUSERS MOUNTED IN DRYWALL.
  15. CONTRACTOR SHALL VERIFY CLEARANCE REQUIREMENTS AND INDICATED ROUTING OF DUCTWORK PRIOR TO FABRICATION AS RISES AND DROPS MAY BE NECESSARY DUE TO THE TRUSS FRAMING SYSTEM.
  16. CONTRACTOR SHALL REMOVE EXISTING HVAC EQUIPMENT, ALL ASSOCIATED ACCESSORIES AND MATERIALS AS SHOWN AND TURN OVER TO OWNER OR REMOVE FROM THE SITE LEGALLY IF SO DIRECTED BY THE OWNER.
  17. IT SHALL BE THE CONTRACTOR'S RESPONSIBILITY TO VERIFY EXISTING CONDITIONS BEFORE DEMOLITION WORK BEGINS. REPORT ANY DISCREPANCIES BETWEEN THE PLANS AND ACTUAL FIELD CONDITIONS TO THE ARCHITECT / ENGINEER PRIOR TO THE COMMENCEMENT OF DEMOLITION WORK.
  18. DEMOLITION WORK SHALL BE PHASED TO ACCOMPLISH REPLACEMENT WITH MINIMUM AMOUNT OF DOWNTIME. SCHEDULE NEW AND DEMOLITION WORK IN ADVANCE WITH THE OWNER.
  19. CONTRACTOR SHALL PROVIDE CERTIFIED AIR SYSTEM BALANCE. BALANCING CONTRACTOR SHALL BE AABC OR NEBB CERTIFIED. PROVIDE REPORT TO ENGINEER/ARCHITECT.
  20. VARIATION OF DUCT CONFIGURATION OR SIZES OTHER THAN THOSE OF EQUIVALENT OR LOWER LOSS COEFFICIENT IS NOT PERMITTED EXCEPT BY WRITTEN PERMISSION. SIZE ROUND DUCTS INSTALLED IN PLACE OF RECTANGULAR DUCTS IN ACCORDANCE WITH ASHRAE TABLE OF EQUIVALENT RECTANGULAR AND ROUND DUCTS.
  21. EQUIPMENT AND MATERIALS SUBMITTED "AS EQUAL" TO THE SPECIFIED DATA MUST BE CLEARLY MARKED AS TO THE DIFFERENCES IN SUBMITTED VERSUS SPECIFIED. FAILURE TO CLEARLY MARK THE SUBMITTALS AS SUCH IS GROUNDS FOR REJECTION. SUBMITTALS NOT CLEARLY MARKED WITH DIFFERENCES TO THE SPECIFIED DATA CAN BE ASSUMED TO MEET ALL SPECIFIED REQUIREMENTS AND CONTRACTOR IS RESPONSIBLE TO PROVIDE AS SUCH.
  22. DUCT MOUNTED REGISTERS SHALL BE MOUNTED IN A COLLAR WITH SUFFICIENT LENGTH TO PREVENT DAMPERS FROM OBSTRUCTING AIR FLOW. COLLARS TO BE OVERSIZED FOR REVERSE FLANGE REGISTER MOUNTING.
  23. ALL DUCTWORK SHALL BE INSTALLED AND LABELLED ACCORDING TO SEISMIC DESIGN CATEGORY C.

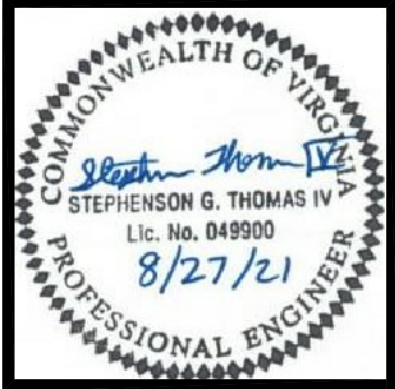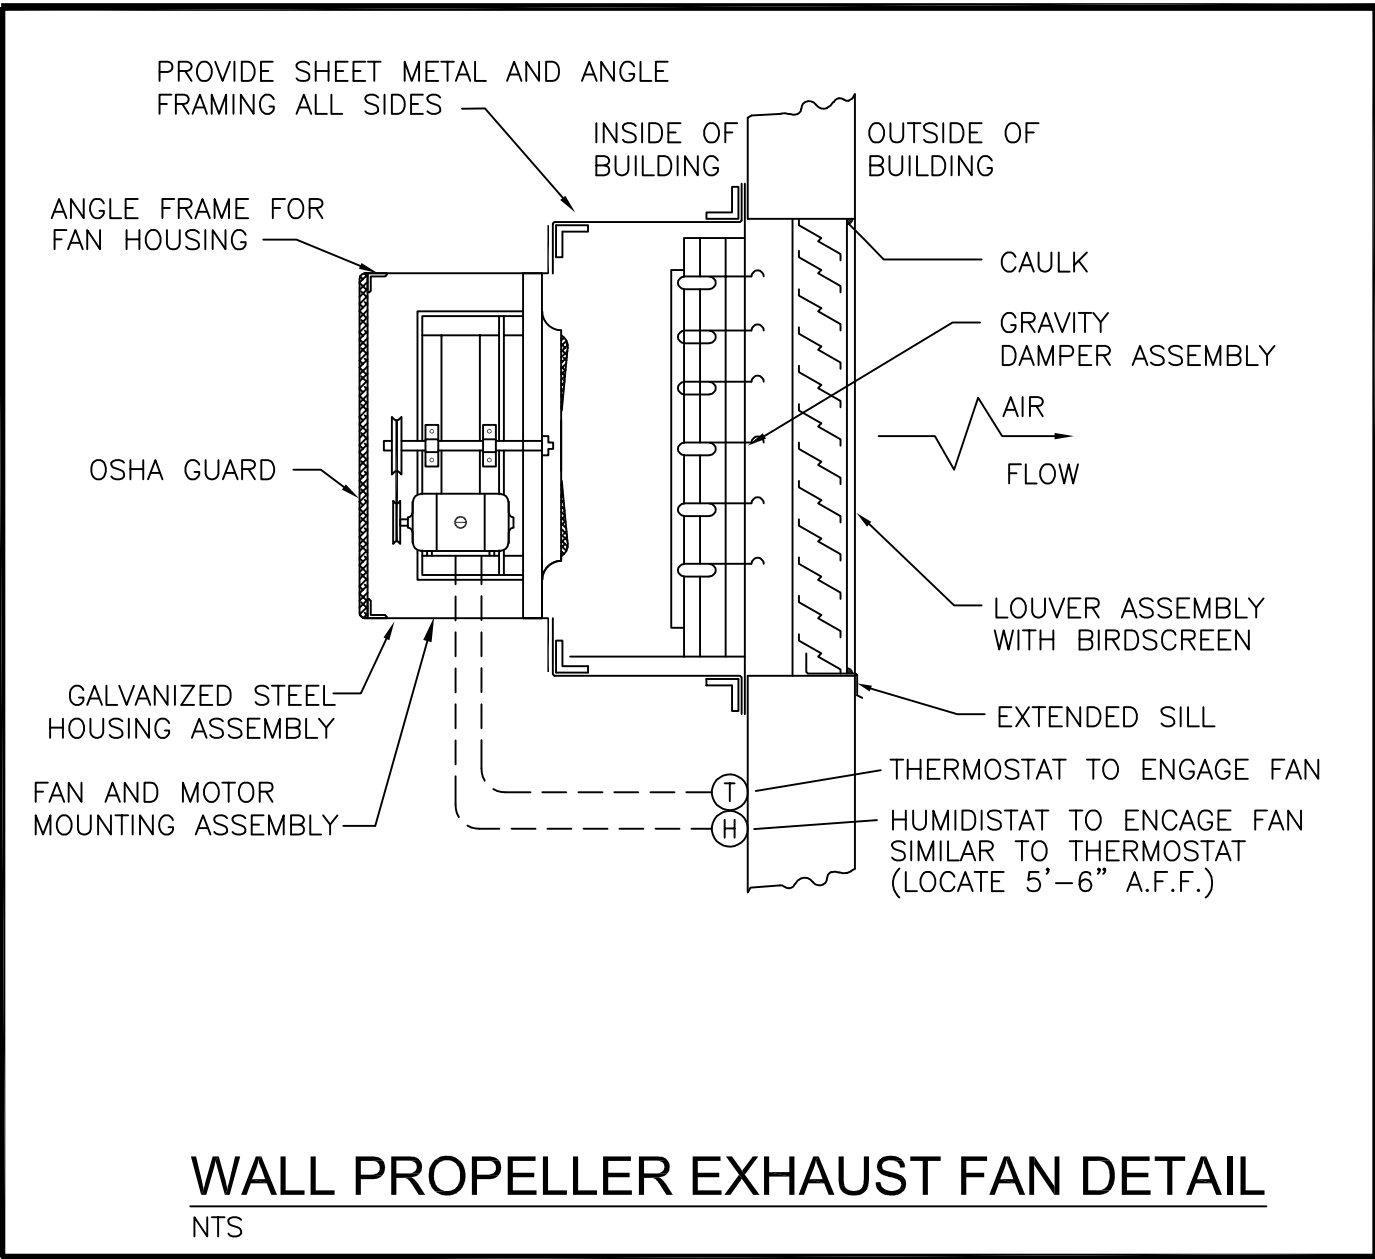

TOWN OF RICHLANDS - 4.0 MGD WWTP  
UPGRADES AND IMPROVEMENTS

MECHANICAL LEGEND, ABBREVIATIONS,  
AND GENERAL NOTES

Purpose of Document Issue									
ISSUED FOR BIDS									
Date	01-07-22								
No.									

Designed	SGT
Drawn	SGT
Checked	SRF
Date	FEBRUARY 2021



Project No.	14249-00
-------------	----------




Sheet No.

M001





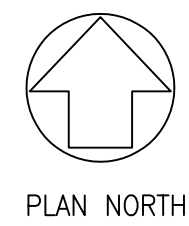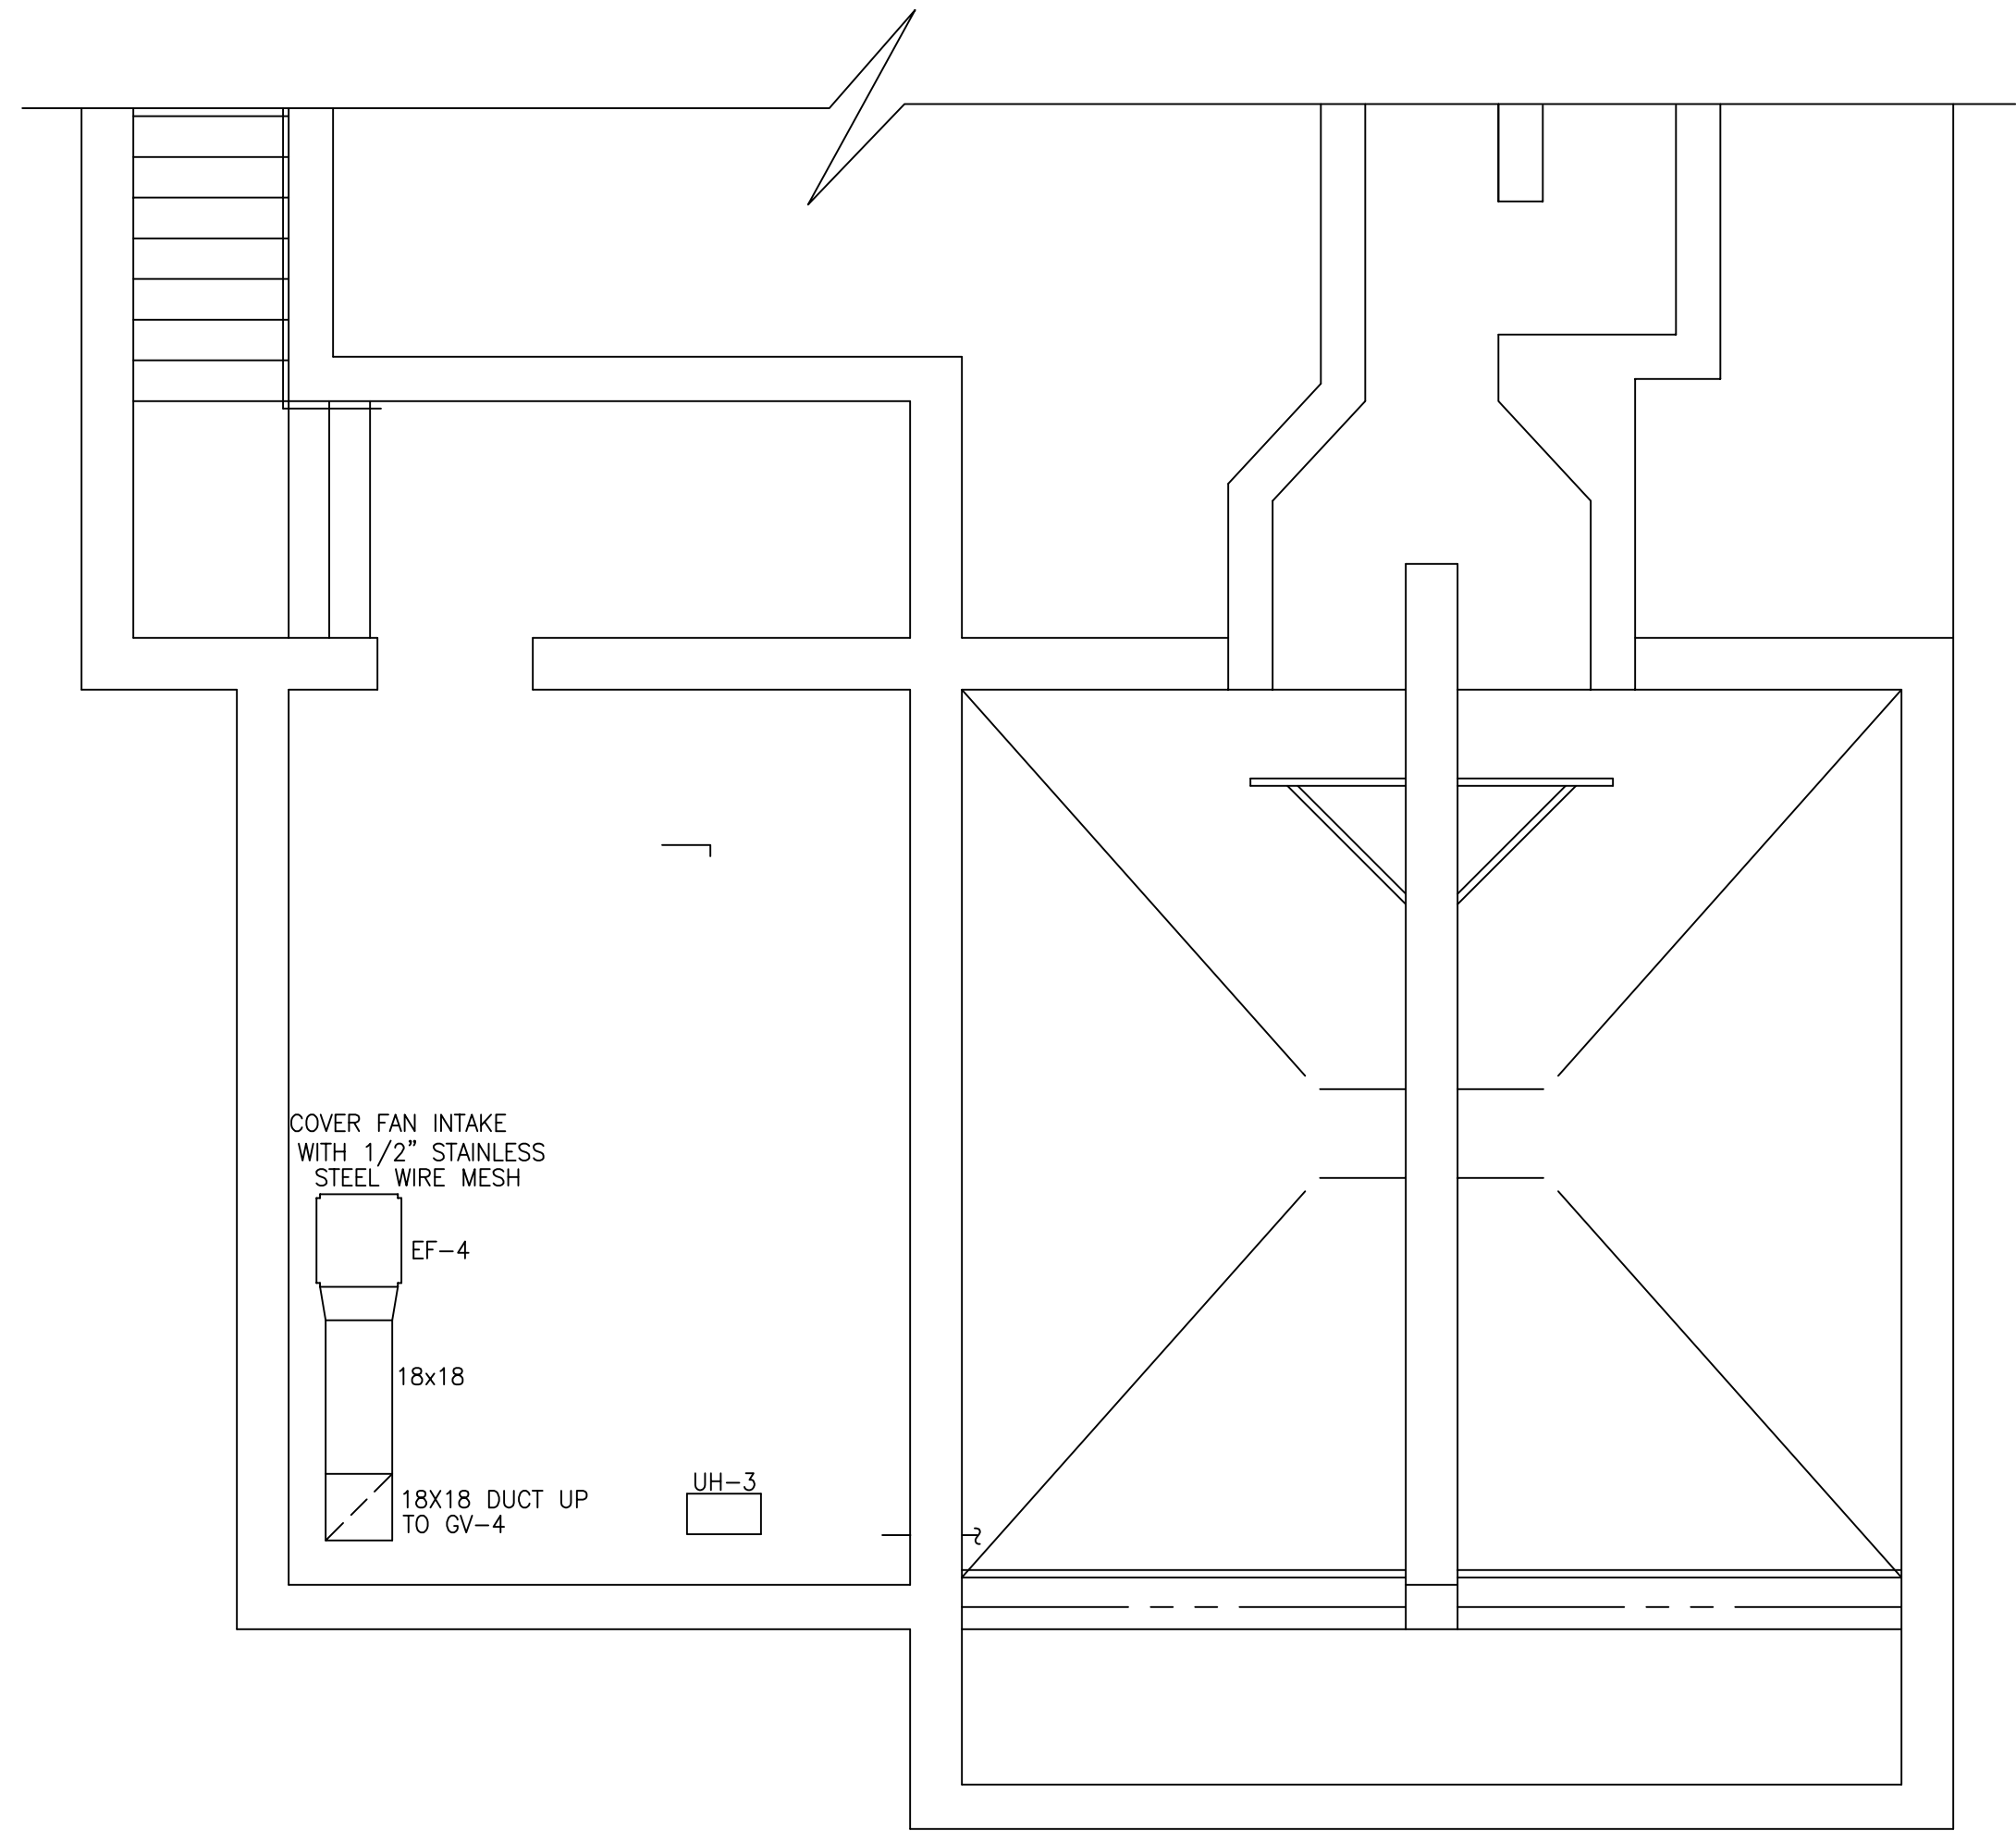

LOWER FLOOR HVAC PLAN - PRELIMINARY TREATMENT BUILDING  
SCALE: 1/4" = 1'-0"

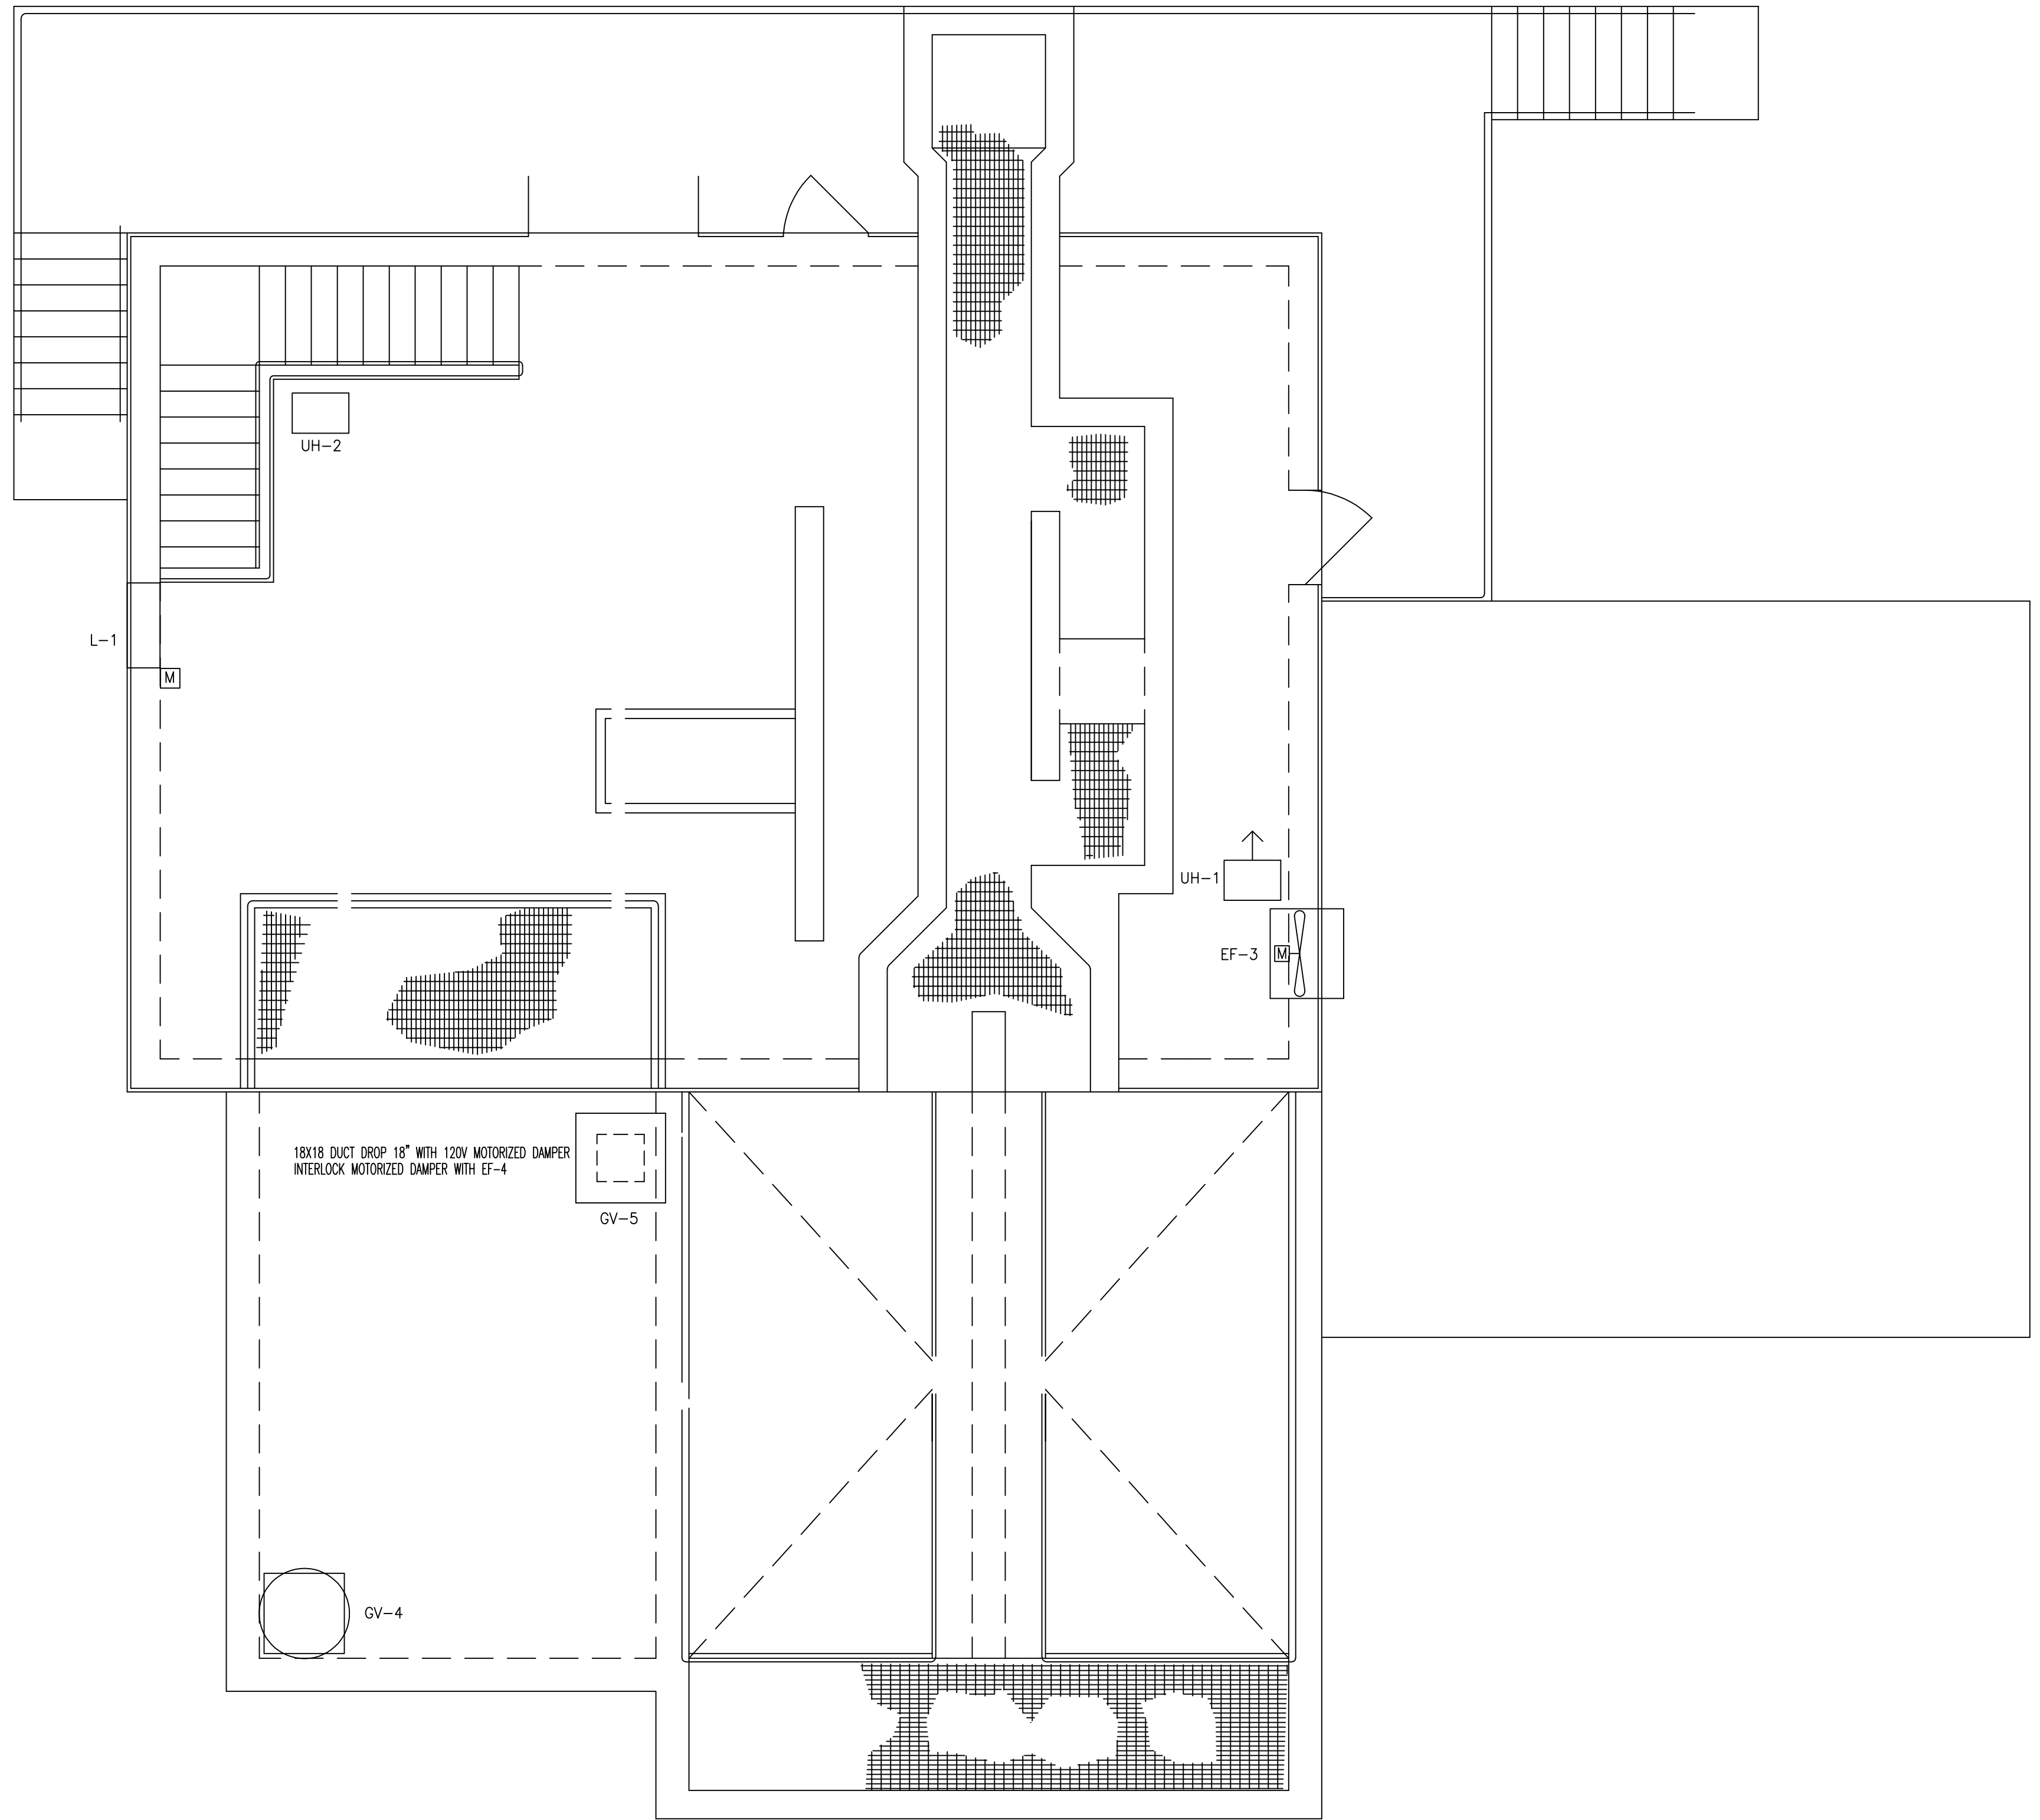

UPPER FLOOR HVAC PLAN - PRELIMINARY TREATMENT BUILDING  
SCALE: 1/4" = 1'-0"

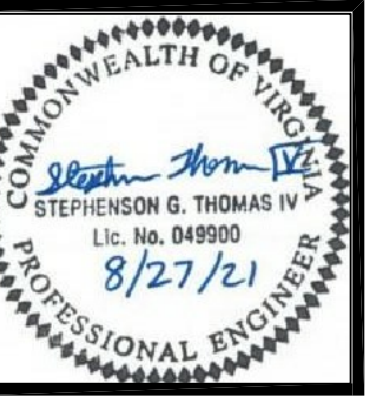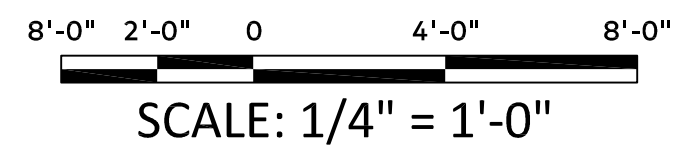

TOWN OF RICHLANDS - 4.0 MGD WWTP  
UPGRADES AND IMPROVEMENTS

LOWER AND UPPER HVAC PLAN -  
PRETREATMENT BUILDING

Purpose of Document Issue  
ISSUED FOR BIDS

Date  
01-07-22

No.

Designed	SGT
Drawn	SGT
Checked	SRF
Date	FEBRUARY 2021

Project No.  
14249-00



Sheet No.

M103



GENERAL ELECTRICAL NOTES				
1. ALL NOTES, SYMBOLS AND ABBREVIATIONS MAY NOT BE APPLICABLE TO THIS PROJECT. 2. COMPLY WITH THE FOLLOWING CODES PERTAINING TO THIS PROJECT: 2.1. NATIONAL ELECTRIC CODE/ NFPA 70: NEC, 2014 2.2. VIRGINIA ENERGY CODE: VECC 2015 2.3. VIRGINIA UNIFORM STATEWIDE BUILDING CODE: VUSBC, 2015 3. CONTRACTORS SHALL VISIT SITE TO FAMILIARIZE THEMSELVES WITH CONDITIONS TO BE MET IN THE EXECUTION OF THE WORK UNDER THIS CONTRACT. NO ADDITIONAL COMPENSATION WILL BE ALLOWED FOR ANY CHANGES THAT MAY BE REQUIRED DUE TO SITE CONDITIONS. 4. COORDINATE EXACT LOCATIONS OF ANY NEW OR RELOCATED PANELS AND ELECTRICAL EQUIPMENT WITH PLUMBING AND MECHANICAL SYSTEMS TO ENSURE NEC REQUIRED CLEAR WORKING SPACE AND DEDICATED EQUIPMENT SPACE PER NEC 110. 5. PROVIDE INCREASED CONDUCTOR SIZES FOR 120/208 BRANCH CIRCUITS AS FOLLOWS UNO:				
CIRCUIT BREAKER SIZE	0-100 FT. LENGTH	100-200 FT. LENGTH	200-300 FT. LENGTH	OVER 300 FT. LENGTH
20 AMP	12 AWG	10 AWG	6 AWG	4 AWG
30 AMP	10 AWG	8 AWG	4 AWG	3 AWG
6. ALL EMPTY CONDUIT RUNS IN EXCESS OF 10 FEET SHALL BE PROVIDED WITH A PULLWIRE. 7. DO NOT SHARE NEUTRALS. 8. RECESSED DEVICES MAY BE ADJUSTED TO MATCH MASONRY COURSES IF APPLICABLE. MOUNT ALL BOXES TRUE AND PLUMB. ADJUSTED MOUNTING HEIGHTS SHALL REMAIN WITHIN ADA REQUIREMENTS. 9. MOUNT RECEPTACLES AT 20" AFF TO TOP, UNLESS OTHERWISE NOTED. ADJUST TO MATCH MASONRY COURSES IF APPLICABLE WITHIN CODE REQUIREMENTS. MOUNT ALL BOXES TRUE AND PLUMB. 10. RECEPTACLES, SWITCHES, THERMOSTATS, AND OTHER SIMILAR ITEMS SHALL ALIGN VERTICALLY OR HORIZONTALLY WITH EACH OTHER, WITH THE STRUCTURE AND OTHER FEATURES THEREOF WHEN IT APPEARS OBVIOUS AND LOGICAL THAT THEY SHOULD. THE ELECTRICAL CONTRACTOR SHALL CONSULT WITH THE GENERAL CONSTRUCTION SUPERINTENDENT REGARDING THIS REQUIREMENT AND ALSO FOR THE LOCATION OF EQUIPMENT, DOOR SWINGS, BLOCK COURSING, ALIGNMENT OF THIS AND OTHER SIMILAR FEATURES BEFORE ROUGHING-IN FOR THESE COMPONENTS. 11. THE MANUFACTURER AND MODEL NUMBER SHOWN ON THE LIGHT FIXTURE SCHEDULE INDICATES THE TYPE, CONSTRUCTION, STYLE, QUALITY AND STANDARD OF PERFORMANCE REQUIRED. OTHER MANUFACTURERS WITH EQUAL PRODUCTS ARE ACCEPTABLE UPON PRIOR APPROVAL. 12. CONTRACTOR SHALL VERIFY THAT ALL DOOR SWINGS ARE CORRECT BEFORE ROUGHING IN LIGHT SWITCH OUTLETS. LIGHT SWITCHES SHALL NOT BE LESS THAN 3 NOR MORE THAN 12 INCHES FROM DOOR TRIM. 13. FIXTURES MUST BE INDEPENDENTLY SUPPORTED BY BUILDING STRUCTURE. CONTRACTOR SHALL COORDINATE MOUNTING OF LIGHT FIXTURES WITH EXISTING AND NEW CONDITIONS AND EQUIPMENT TO MAXIMIZE COVERAGE. 14. ALL DEMOLITION AND CONSTRUCTION DESIGN IS BASED ON ORIGINAL CONSTRUCTION DOCUMENTS AND ON A SET OF RENOVATION DRAWINGS. THE CONTRACTOR SHALL VERIFY ALL ASPECTS IN THE FIELD BEFORE STARTING WORK. 15. LOCATIONS OF LINES AND EQUIPMENT MUST BE DETERMINED FROM ACTUAL FIELD CONDITIONS. THE OUTLINES OF THE CONSTRUCTION SHOWN ON THE ELECTRICAL DRAWINGS ARE INTENDED ONLY AS A GUIDE TO INDICATE RELATIVE LOCATIONS OF THE WORK. REFER TO THE APPLICABLE DRAWINGS OF OTHER TRADES AND THE EQUIPMENT SUPPLIER'S INSTALLATION DRAWINGS FOR EXACT LOCATIONS AND ARRANGEMENTS. 16. THE ELECTRICAL CONTRACTOR SHALL BE RESPONSIBLE FOR THE COORDINATION AND PROPER RELATION OF HIS WORK TO THE FACILITY STRUCTURES AND TO THE WORK OF OTHER TRADES. NO ADDITIONAL COMPENSATION NOR EXTENSION OF COMPLETION TIME WILL BE GRANTED FOR EXTRA WORK CAUSED BY THE LACK OF COORDINATION. 17. COORDINATE WITH MECHANICAL ON EXACT LOCATION AND ELECTRICAL CONNECTION REQUIREMENTS FOR HVAC EQUIPMENT PROVIDED. 18. ELECTRICAL REQUIREMENTS FOR HVAC EQUIPMENT ARE FOR HVAC EQUIPMENT SPECIFIED. IF SUBSTITUTE HVAC EQUIPMENT IS SUPPLIED, CONTRACTOR IS RESPONSIBLE FOR MODIFICATIONS AND/OR ADDITIONS TO ELECTRICAL REQUIREMENTS OF HVAC EQUIPMENT SUPPLIED. 19. DUE TO DIFFERENCES IN VARIOUS MANUFACTURER'S EQUIPMENT CONNECTIONS AND MOTOR CURRENTS, THE ELECTRICAL CONTRACTOR SHALL COORDINATE HIS INSTALLATION WITH THAT EQUIPMENT ACTUALLY FURNISHED AND SHALL VERIFY THE CORRECT SIZES AND DETAILS OF INSTALLATION BEFORE ROUGHING IN. 20. THE CORRECT NUMBER OF WIRES MAY NOT BE INDICATED FOR ALL CIRCUITS, ONLY THOSE WHERE CLARIFICATION IS NECESSARY. THE ELECTRICAL CONTRACTOR SHALL PROVIDE ALL WIRES NECESSARY FOR THE PROPER FUNCTION OF THE SYSTEM WHETHER INDICATED ON DRAWINGS OR NOT. 21. ALL CONDUITS WITH WIRING ENTERING UNDERGROUND STRUCTURES WHERE WATER MIGHT ENTER THE CONDUIT AND DRAIN INTO THE STRUCTURE, SHALL BE FITTED WITH WATERTIGHT BUSHINGS WITH SEALING COMPOUND SUCH AS OZ/GEDNEY STYLE CSB. 22. SOME UNDERGROUND UTILITIES, AS FAR AS THEIR LOCATIONS ARE KNOWN, ARE SHOWN ON THE DRAWINGS. HOWEVER, THIS DOES NOT GUARANTEE THAT THESE UTILITIES ARE IN THE LOCATIONS SHOWN, OR THAT THERE ARE NOT ADDITIONAL UTILITIES IN THE AREA OF WORK. CONTACT MISS UTILITY AT 811, 1800-552-7001, OR HTTP://WWW.MISSUTILITYOFVIRGINIA.COM NO LESS THAN 72 HOURS PRIOR TO EXCAVATION FOR LOCATING OF PUBLIC UTILITIES. DO NOT DISTURB THE SOIL UNTIL A DIG TICKET HAS BEEN PROCESSED. CONTRACTOR IS RESPONSIBLE FOR LOCATING ALL PRIVATE UTILITIES. 23. THE ELECTRICAL CONTRACTOR SHALL BE RESPONSIBLE FOR TRENCHING, DUCT BANK EXCAVATION AND BACKFILL FOR ALL ON SITE POWER AND LOW VOLTAGE CONNECTIONS BETWEEN BUILDINGS AS INDICATED ON ES-1, AND AS NECESSARY, INCLUDING RACEWAY AS REQUIRED. SEE ONE-LINE DIAGRAMS FOR CONDUCTOR REQUIREMENTS. 24. LABEL SWITCHBOARDS AND PANELS WITH SOURCE OF POWER IN ACCORDANCE WITH NEC ARTICLE 408.4(B).				

LEGEND	
	SURFACE MOUNTED LIGHT FIXTURE, TYPE AS INDICATED. SEE LIGHT FIXTURE SCHEDULE.
EM	WALL MOUNTED LIGHT FIXTURE, TYPE AS INDICATED. SEE LIGHT FIXTURE SCHEDULE. 'EM' DENOTES FIXTURE WITH EMERGENCY BATTERY.
	CAN LIGHT, TYPE AS INDICATED. SEE LIGHT FIXTURE SCHEDULE.
	SHADING OR EM DENOTES FIXTURE WITH EMERGENCY BATTERY FOR EMERGENCY EGRESS LIGHTING. BATTERY WHERE USED SHALL BE POWERED AT ALL TIMES. WHERE FIXTURES INDICATED TO BE SWITCHED, PROVIDE EMERGENCY SHUNT RELAY TO TURN FIXTURE ON WITH THE LOSS OF POWER REGARDLESS OF SWITCH POSITION. WHERE INTEGRAL BATTERY IS NOT AVAILABLE FOR FIXTURE SPECIFIED, PROVIDE A REMOTE BATTERY IN AN ACCESSIBLE LOCATION. SEE LIGHT FIXTURE SCHEDULE.
	CEILING MOUNTED EXIT SIGN. SHADING INDICATES FACE AND ARROWS INDICATE DIRECTIONAL ARROWS WHERE SHOWN. 'XP' INDICATES CLASS 1 DIVISION 1 RATED EXIT SIGN. SEE LIGHT FIXTURE SCHEDULE.
	WALL MOUNTED EXIT SIGN. SHADING INDICATES FACE AND ARROWS INDICATE DIRECTIONAL ARROWS WHERE SHOWN. 'XP' INDICATES CLASS 1 DIVISION 1 RATED EXIT SIGN. SEE LIGHT FIXTURE SCHEDULE.
\$	LIGHT SWITCH, SINGLE POLE DEVICE, 20 AMP, 120/277 VOLT, FLUSH MOUNT 48" AFF TO TOP OF BOX. "K" INDICATES KEY OPERATED. "D" INDICATES DIMMER SWITCH. "P" INDICATES PILOT LIGHT.
\$ <sub>3</sub>	LIGHT SWITCH, THREE WAY DEVICE, 20 AMP, 120/277 VOLT, FLUSH MOUNT 48" AFF, TO TOP OF BOX.
\$ <sub>4</sub>	LIGHT SWITCH, FOUR WAY DEVICE, 20 AMP, 120/277 VOLT, FLUSH MOUNT 48" AFF TO TOP OF BOX.
\$ <sub>M</sub>	MOTOR RATED SWITCH, FLUSH MOUNT 48" AFF, TO TOP OF BOX
	LIGHT SWITCH, SINGLE POLE DEVICE, 20 AMP, 120/277 VOLT, SURFACE MOUNT 48" AFF TO TOP OF BOX.
	120 V, 20 AMP, DUPLEX CONVENIENCE RECEPTACLE, FLUSH MOUNT 20" AFF TO TOP OF BOX, NEMA 5-20R.
	120 V, 20 AMP, DUPLEX CONVENIENCE RECEPTACLE, FLUSH MOUNT 48" AFF TO TOP OF BOX, OR 6" ABOVE COUNTERTOP OR BACKSPLASH AS APPLICABLE TO TOP OF BOX
	120 V, 20 AMP, DUPLEX CONVENIENCE RECEPTACLE, SURFACE MOUNT BOX 20" AFF TO TOP OF BOX, NEMA 5-20R.
	120 V, 20 AMP, DOUBLE DUPLEX RECEPTACLE, NEMA 5-20R FLUSH MOUNT 20" AFF TO TOP OF BOX. SINGLE COVER PLATE.
	SPECIAL PURPOSE RECEPTACLE, TYPE AS INDICATED.
A-1	CIRCUIT HOME RUN AND CONNECTION TO DEVICE (PANEL A, CIRCUIT #1), HASH MARKS INDICATE NUMBER OF CONDUCTORS EXCEPT GROUNDS WHERE SHOWN. ARROW HEADS INDICATE NUMBER OF CIRCUITS. PANEL DESIGNATION AS INDICATED. BRANCH CONDUCTORS ARE #12 AWG COPPER IN 3/4" MINIMUM RACEWAY, UNO. DASHED LINE DENOTES UNDERGROUND OR UNDER FLOOR CIRCUITS.
J J JB JB	JUNCTION BOX / PULL BOX
	ELECTRIC MOTOR, HP/KW, VOLTAGE, AND PHASE AS INDICATED
	MAGNETIC MOTOR STARTER WITH OVERLOADS & DISCONNECT SWITCH
■	MANUAL MOTOR STARTER WITH OVERLOAD PROTECTION, SURFACE MOUNT, NEMA 1, AS INDICATED.
	SAFETY SWITCH, HEAVY DUTY, FUSIBLE OR NON-FUSIBLE, POLES AS REQUIRED, "F" INDICATES FUSIBLE.
C1	CONTACTOR NUMBER AS INDICATED
	PANEL BOARD, EXISTING
	PANEL BOARD, NEW
PP ○	POWER SERVICE POLE
	UTILITY METER
	GENERATOR
	TRANSFORMER, NAME AS INDICATED

## GENERAL NOTES

1. CONTRACTOR SHALL COORDINATE ALL ITEMS TO BE SALVAGED WITH THE OWNER AND RETURN TO OWNER AFTER DISCONNECTION. IF OWNER DEEMS MATERIALS UNSALVAGEABLE, CONTRACTOR IS RESPONSIBLE FOR REMOVING FROM PROJECT SITE ALONG WITH ALL OTHER DEMOLISHED MATERIAL AND DISPOSING OF PROPERLY IN ACCORDANCE WITH LOCAL, STATE AND FEDERAL LAWS.
2. EXISTING FACILITY IS TO REMAIN POWERED DURING CONSTRUCTION, CONTRACTOR SHALL MINIMIZE ALL POWER OUTAGES. CONTRACTOR SHALL COORDINATE ALL POWER OUTAGES WITH OWNER WITH PRIOR APPROVAL.
3. THE CONTRACTOR SHALL REMOVE EXISTING WORK AS CALLED FOR ON THE DRAWINGS OR AS REQUIRED TO CLEAR THE AREAS FOR NEW CONSTRUCTION.
4. THE CONTRACTOR SHALL REMOVE DEVICES AND ASSOCIATED CIRCUITRY FROM WALLS AND CEILINGS THAT ARE REMOVED OR MODIFIED UNDER THIS CONTRACT.
5. IF EXISTING EQUIPMENT IS TO BE RELOCATED, CARE SHALL BE TAKEN TO PREVENT DAMAGE DURING THE REMOVAL AND REINSTALLATION. WHERE DAMAGE OCCURS, THE EQUIPMENT SHALL BE REPLACED OR REPAIRED AT NO ADDITIONAL COST TO THE OWNER.
6. REMOVE EACH ITEM OF EQUIPMENT, DEVICE, AND FIXTURE INDICATED TO BE DEMOLISHED AND ASSOCIATED CIRCUITRY BACK TO THE PROTECTIVE DEVICE IN THE PANEL, SWITCHBOARD, OR CONTROLLER, EXCEPT AS OTHERWISE NOTED.
  - a. ASSOCIATED CIRCUITRY SHALL BE DEFINED TO INCLUDE ALL RACEWAYS, CONDUCTORS, ENCLOSURES, JUNCTION BOXES, WIRING DEVICES, COVERPLATES, LAMPS, FIXTURES, SWITCHES, STARTERS, ETC. WHICH ARE ASSOCIATED WITH THE ITEM TO BE REMOVED.
  - b. THE PROTECTIVE DEVICE SHALL REMAIN AS AN INTEGRAL PART OF THE EXISTING PANEL OR SWITCHBOARD. LABEL AS "SPARE" OR USE FOR NEW CIRCUITS AS INDICATED.
  - c. CONTROLLERS IN EXISTING MOTOR CONTROL CENTERS SHALL REMAIN. LABEL AS "SPARE" OR USE FOR NEW CIRCUITS AS INDICATED.
  - d. WHERE CONDUIT ASSOCIATED WITH AN ITEM TO BE REMOVED IS IN AN INACCESSIBLE AREA, SUCH AS ENCASED IN CONCRETE, THE INACCESSIBLE CONDUIT ONLY SHALL BE ABANDONED IN PLACE, UNLESS INDICATED TO BE REUSED. ALL CONDUCTORS SHALL BE REMOVED AND CONDUIT SHALL BE CUT OFF FLUSH AND SEAL OR CAPPED.
  - e. WHERE SUCH INACCESSIBLE CONDUIT ENDS OR MUST BE TERMINATED IN FINISHED SPACE, REMOVE THE CONDUIT OR BOX TO BELOW THE FINISHED SURFACE OR WALL, CEILING OR FLOOR, FILL VOID WITH NON-SHRINKING GROUT AND FINISH TO MATCH SURROUNDING SURFACES.
7. WHERE A PORTION OF A CIRCUIT'S LOAD IS SCHEDULED TO BE REMOVED, REMOVE ONLY THAT PORTION ASSOCIATED WITH THE DEMOLISHED DEVICE TO A POINT WHERE THE REMAINING LOAD IS ACTIVE; MAINTAIN REMAINING CIRCUITRY IN A GOOD OPERATING CONDITION. IF EXISTING CIRCUITRY IS DAMAGED DURING CONSTRUCTION, CONTRACTOR SHALL REPLACE, MATCHING EXISTING SIZES AND RATINGS AT NO ADDITIONAL COST TO THE OWNER.
8. WHERE EXTENSION OF AN EXISTING CIRCUIT IS REQUIRED, RUN CONDUIT AND WIRE (CONCEALED WHERE INDICATED) FROM THE CIRCUIT'S EXISTING LOCATION TO ITS NEW LOCATION. CIRCUIT EXTENSION SHALL MATCH EXISTING CIRCUITRY SIZE AND RATING.
9. WHERE AN ITEM OF EQUIPMENT IS INDICATED TO BE REMOVED AND RELOCATED, ANY ASSOCIATED CIRCUITRY, SWITCHES, DEVICES, ETC. SHALL ALSO BE REMOVED WITH THE EQUIPMENT. RELOCATE THE EQUIPMENT TO THE NEW LOCATION AND PROVIDE CONNECTION OF ALL ASSOCIATED ITEMS TO NEW OR EXTENDED CIRCUITRY AS INDICATED.
10. REUSE EXISTING CONDUIT IN PLACE, DISCONNECTED DURING DEMOLITION WHERE APPLICABLE AND IN GOOD CONDITION.
11. WHERE EXISTING ELECTRICAL CONDUIT/DEVICES/EQUIPMENT INTERFERES WITH NEW WORK AND WHERE SUCH EXISTING INSTALLATIONS ARE TO REMAIN IN USE, THE CONDUIT/DEVICES/EQUIPMENT SHALL BE RELOCATED AND RECONNECTED. COORDINATE WITH OWNER ON NEW LOCATION.
12. EXISTING PANELBOARDS/SWITCHBOARDS MODIFIED UNDER THIS CONTRACT SHALL BE PROVIDED WITH REVISED TYPED SCHEDULES.

ABBREVIATIONS	
A, AMP	AMPERE
AFF	ABOVE FINISHED FLOOR
AHU	AIR HANDLING UNIT
ANCH	ANCHOR
ATS	AUTOMATIC TRANSFER SWITCH
AWG	AMERICAN WIRE GAUGE
BKR	BREAKER
C	CONDUIT
CB	CIRCUIT BREAKER
CCTV	CLOSED CIRCUIT TELEVISION
CKT	CIRCUIT
CR	CONTROL RELAY
CT	CURRENT TRANSFORMER
CTB	CABLE TAP BOX
CTR	CURRENT RELAY
CU	COPPER
DDC	DIRECT DIGITAL CONTROL PANEL
DETD	DUAL ELEMENT TIME DELAY
DPS	DOOR POSITION SWITCH
EC	ELECTRICAL CONTRACTOR
ECB	ENCLOSED CIRCUIT BREAKER
EF	EXHAUST FAN
EM	EMERGENCY
EP	ELECTRIC PNEUMATIC
EX	EXISTING TO BE RELOCATED
EUH	ELECTRIC UNIT HEATER
EW	ELECTRIC WATER COOLER
EWI	ELECTRIC WATER HEATER
EX	EXISTING TO REMAIN
FA	FIRE ALARM
FP	FREEZE PROTECTION
FR	FAN RELAY
FT	FEET
GEC	GROUND ELECTRODE CONDUCTOR
GFEP	GROUND FAULT EQUIPMENT PROTECTION
	CIRCUIT INTERRUPTER
GFI	GROUND FAULT INTERRUPTER
GND, G	GROUND
HP-1	HEAT PUMP
HP	HORSEPOWER
HSC	HYDRAULIC SYSTEMS CENTER
HSP	HAUL STARTER WITH PILOT LIGHT
HVAC	HEATING, VENTILATION AND AIR CONDITIONING
LA	LIGHTNING ARRESTOR
IG	ISOLATED GROUND
JB	JUNCTION BOX
KVA	KILOVOLT AMPERE
KW	KILOWATT
MCB	MAIN CIRCUIT BREAKER
MCC	MOTOR CONTROL CENTER
MLO	MAIN LUG ONLY
MM	MILLIMETER
MSBD	MAIN SWITCHBOARD
N	NEUTRAL
NEC	NATIONAL ELECTRIC CODE
NEMA	NATIONAL ELECTRICAL MANUF. ASSOC.
NL	NIGHT LIGHT
OL	OVERLOAD
PB	PUSHBUTTON MOMENTARY CONTACT SWITCH
PDC	POWER DISTRIBUTION CENTER
PE	PHOTOELECTRIC CELL
PNL	PANEL
RAIL	REMOTE ALARM INDICATOR LIGHT
REC	RECESSED
RGS	RIGID GALVANIZED STEEL CONDUIT
RHC	REHEAT COIL
RTU	ROOF TOP UNIT
SCC	SYSTEM CONTROL CENTER
SUR	SURFACE
SV	SOLENOID VALVE
SWBD	SWITCHBOARD
TC	TIME CLOCK
TVSS	TRANSIENT VOLTAGE SURGE SUPPRESSOR
TW	TEST WELL
UH	UNIT HEATER
UL	UNDERWRITERS LABORATORIES
UNO	UNLESS NOTED OTHERWISE
UPS	UNINTERRUPTIBLE POWER SUPPLY
V	VOLT
WG	WIRE GUARD
WP	WEATHERPROOF
XFMR	TRANSFORMER
XP	EXPLOSION PROOF



Designed	JBC
Drawn	JBC,TKR,TLP
Checked	RMA
Date	1/07/2022




THOMPSON  
& LITTON

Sheet No.

**E001**




Virginia State Plane  
Coordinate System  
Grid North - South Zone

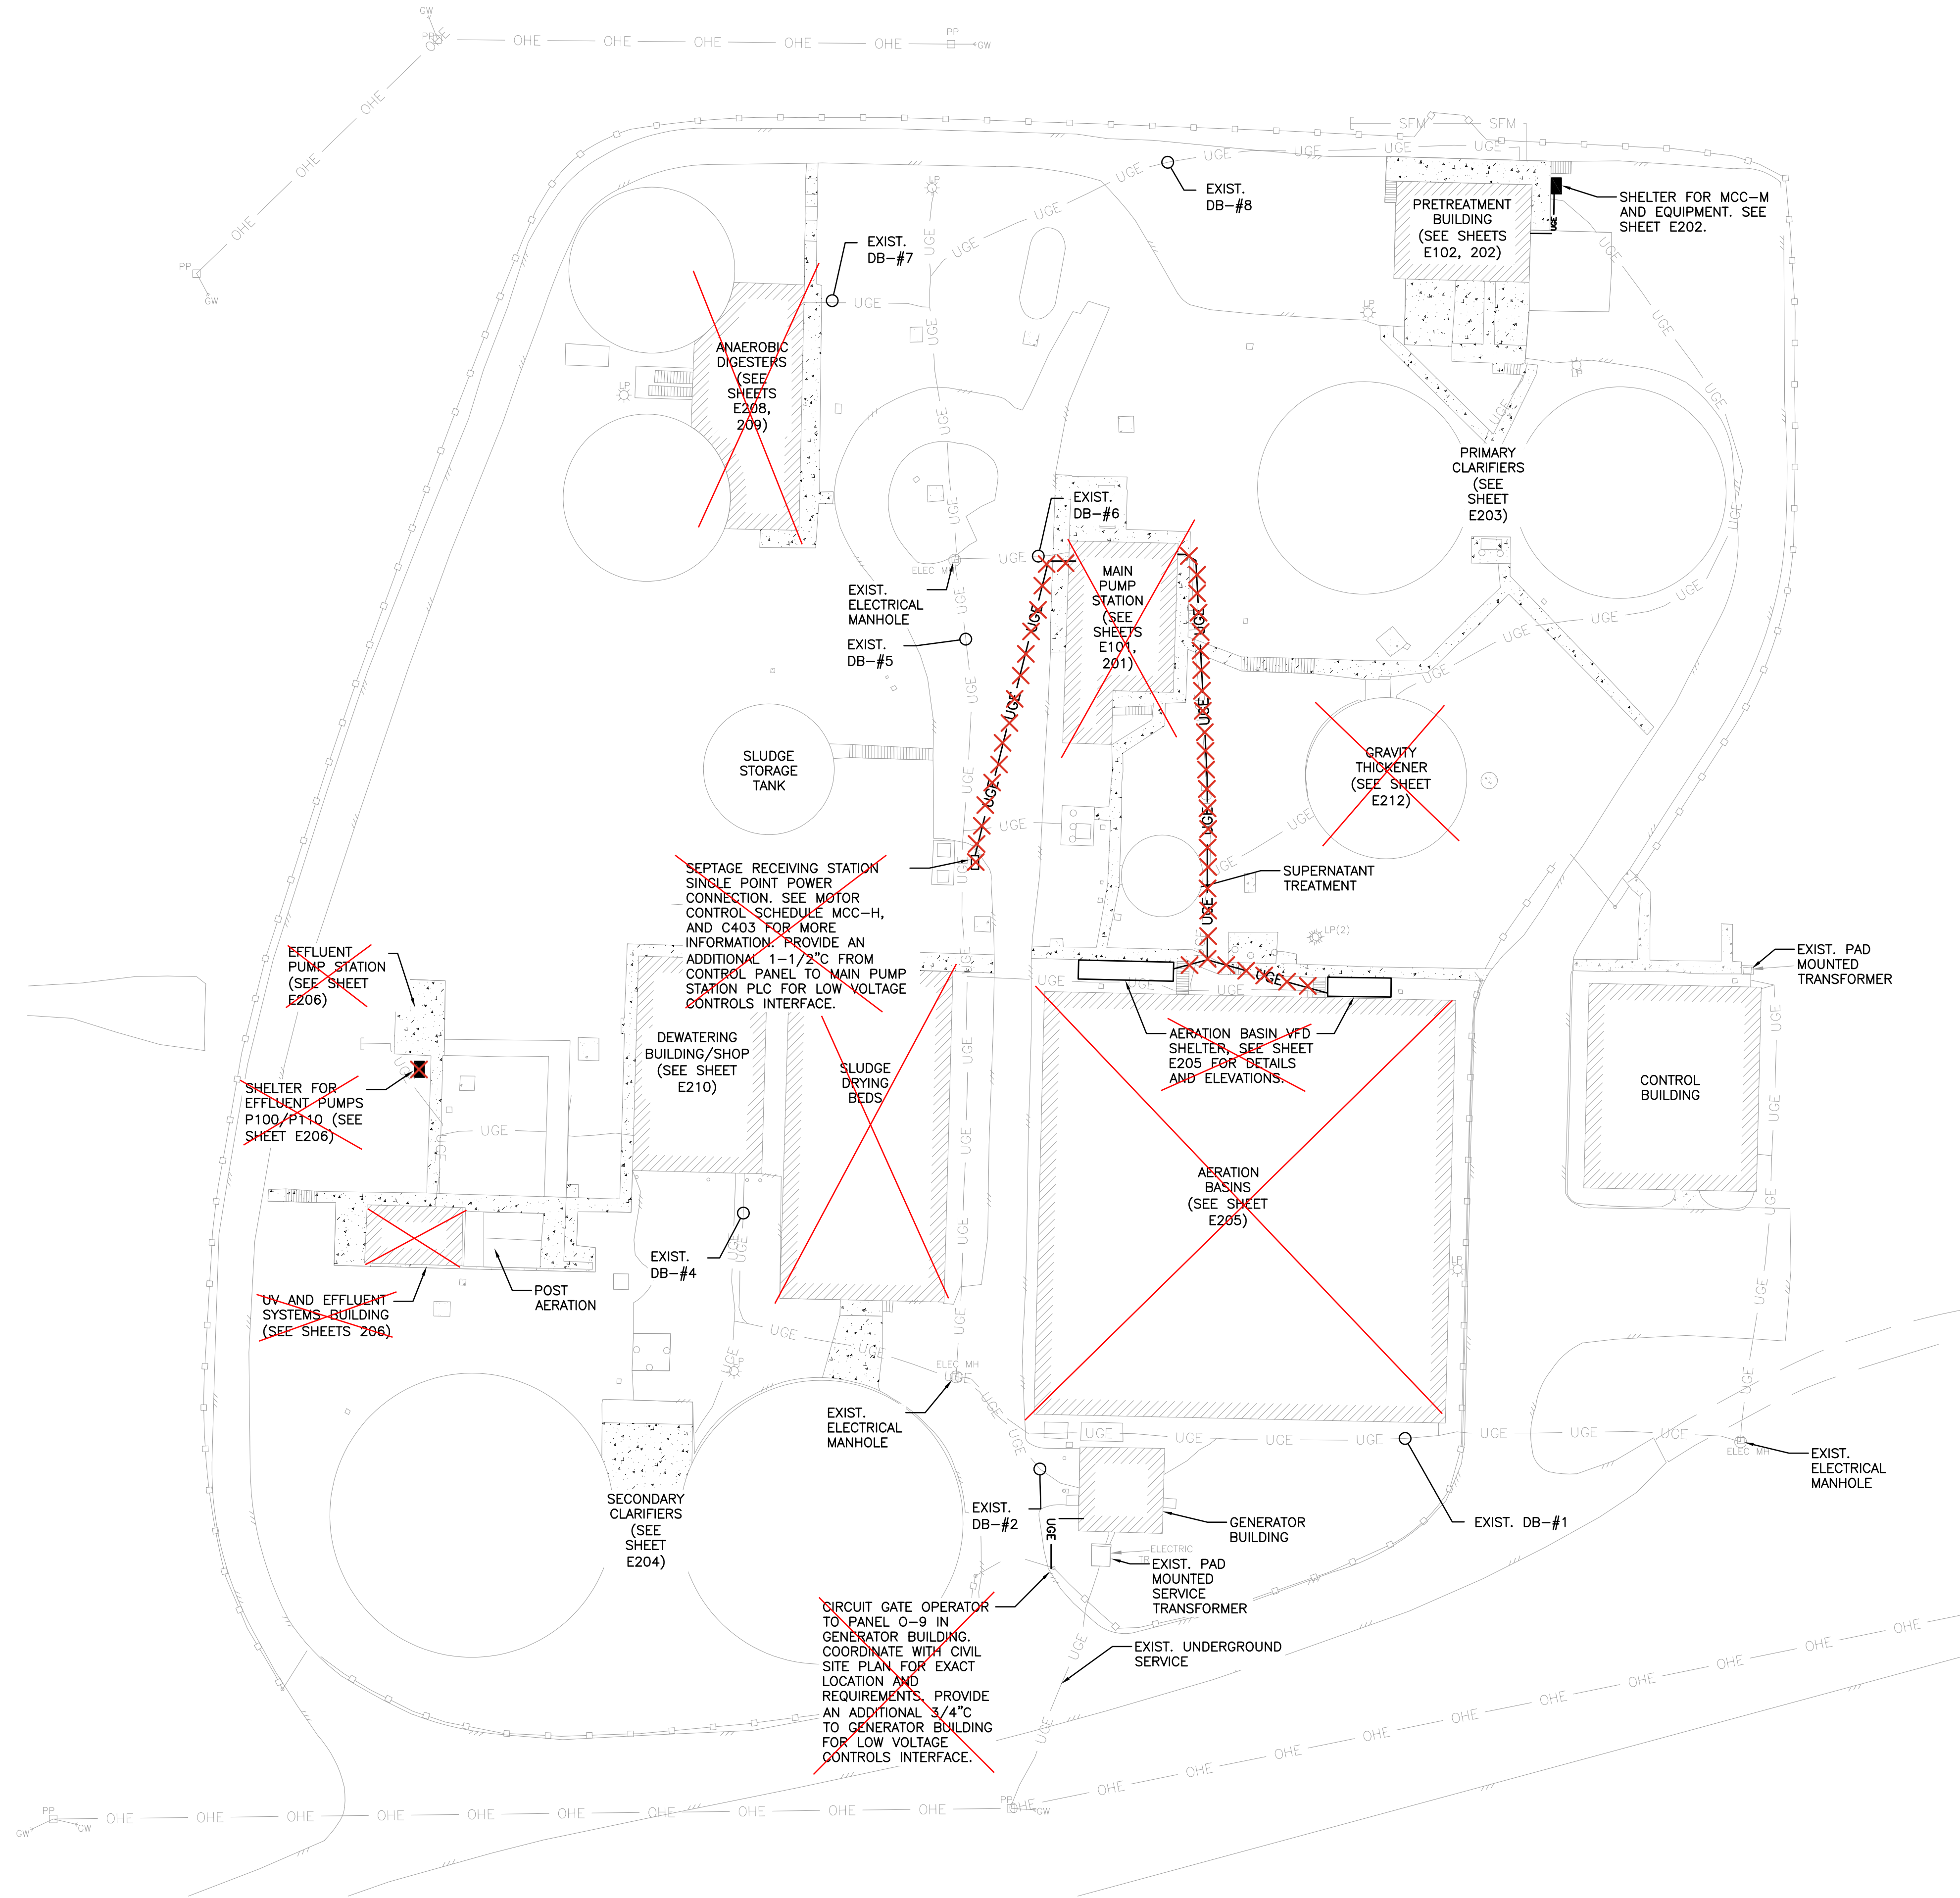

DUCT BANK SCHEDULE				
DB	Power	Telephone	Data Hwy	Spares
EXIST. #1	2 - 3"	1 - 2"	1 - 1 1/4" GRC	2 - 4"
EXIST. #2	9 - 3"	1 - 2"	1 - 1 1/4" GRC	1 - 2", 2 - 4"
EXIST. #4	5 - 3"	1 - 2"	1 - 1 1/4" GRC	2 - 4"
EXIST. #5	3 - 3"	1 - 2"	1 - 1 1/4" GRC	4 - 4"
EXIST. #6	2 - 3"	1 - 2"	1 - 1 1/4" GRC	2 - 4"
EXIST. #7	1 - 3"	1 - 2"	1 - 1 1/4" GRC	2 - 4"
EXIST. #8	1 - 3"	1 - 2"	1 - 1 1/4" GRC	2 - 4"

ELECTRICAL SITE PLAN  
SCALE: 1" = 30'

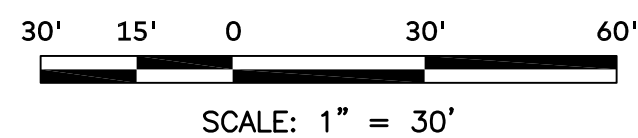

TOWN OF RICHLANDS - 4.0 MGD WWTP  
UPGRADES AND IMPROVEMENTS  
ELECTRICAL SITE PLAN

No.	Date	Purpose of Document Issue
	10-21-20	ISSUED FOR 60% REVIEW
	01-07-22	ISSUED FOR BIDS



Designed	JBC
Drawn	JBC,TKR,TLP
Checked	RMA
Date	1/07/2022

Project No.  
14249-00





Sheet No.  
ES1



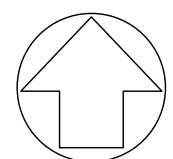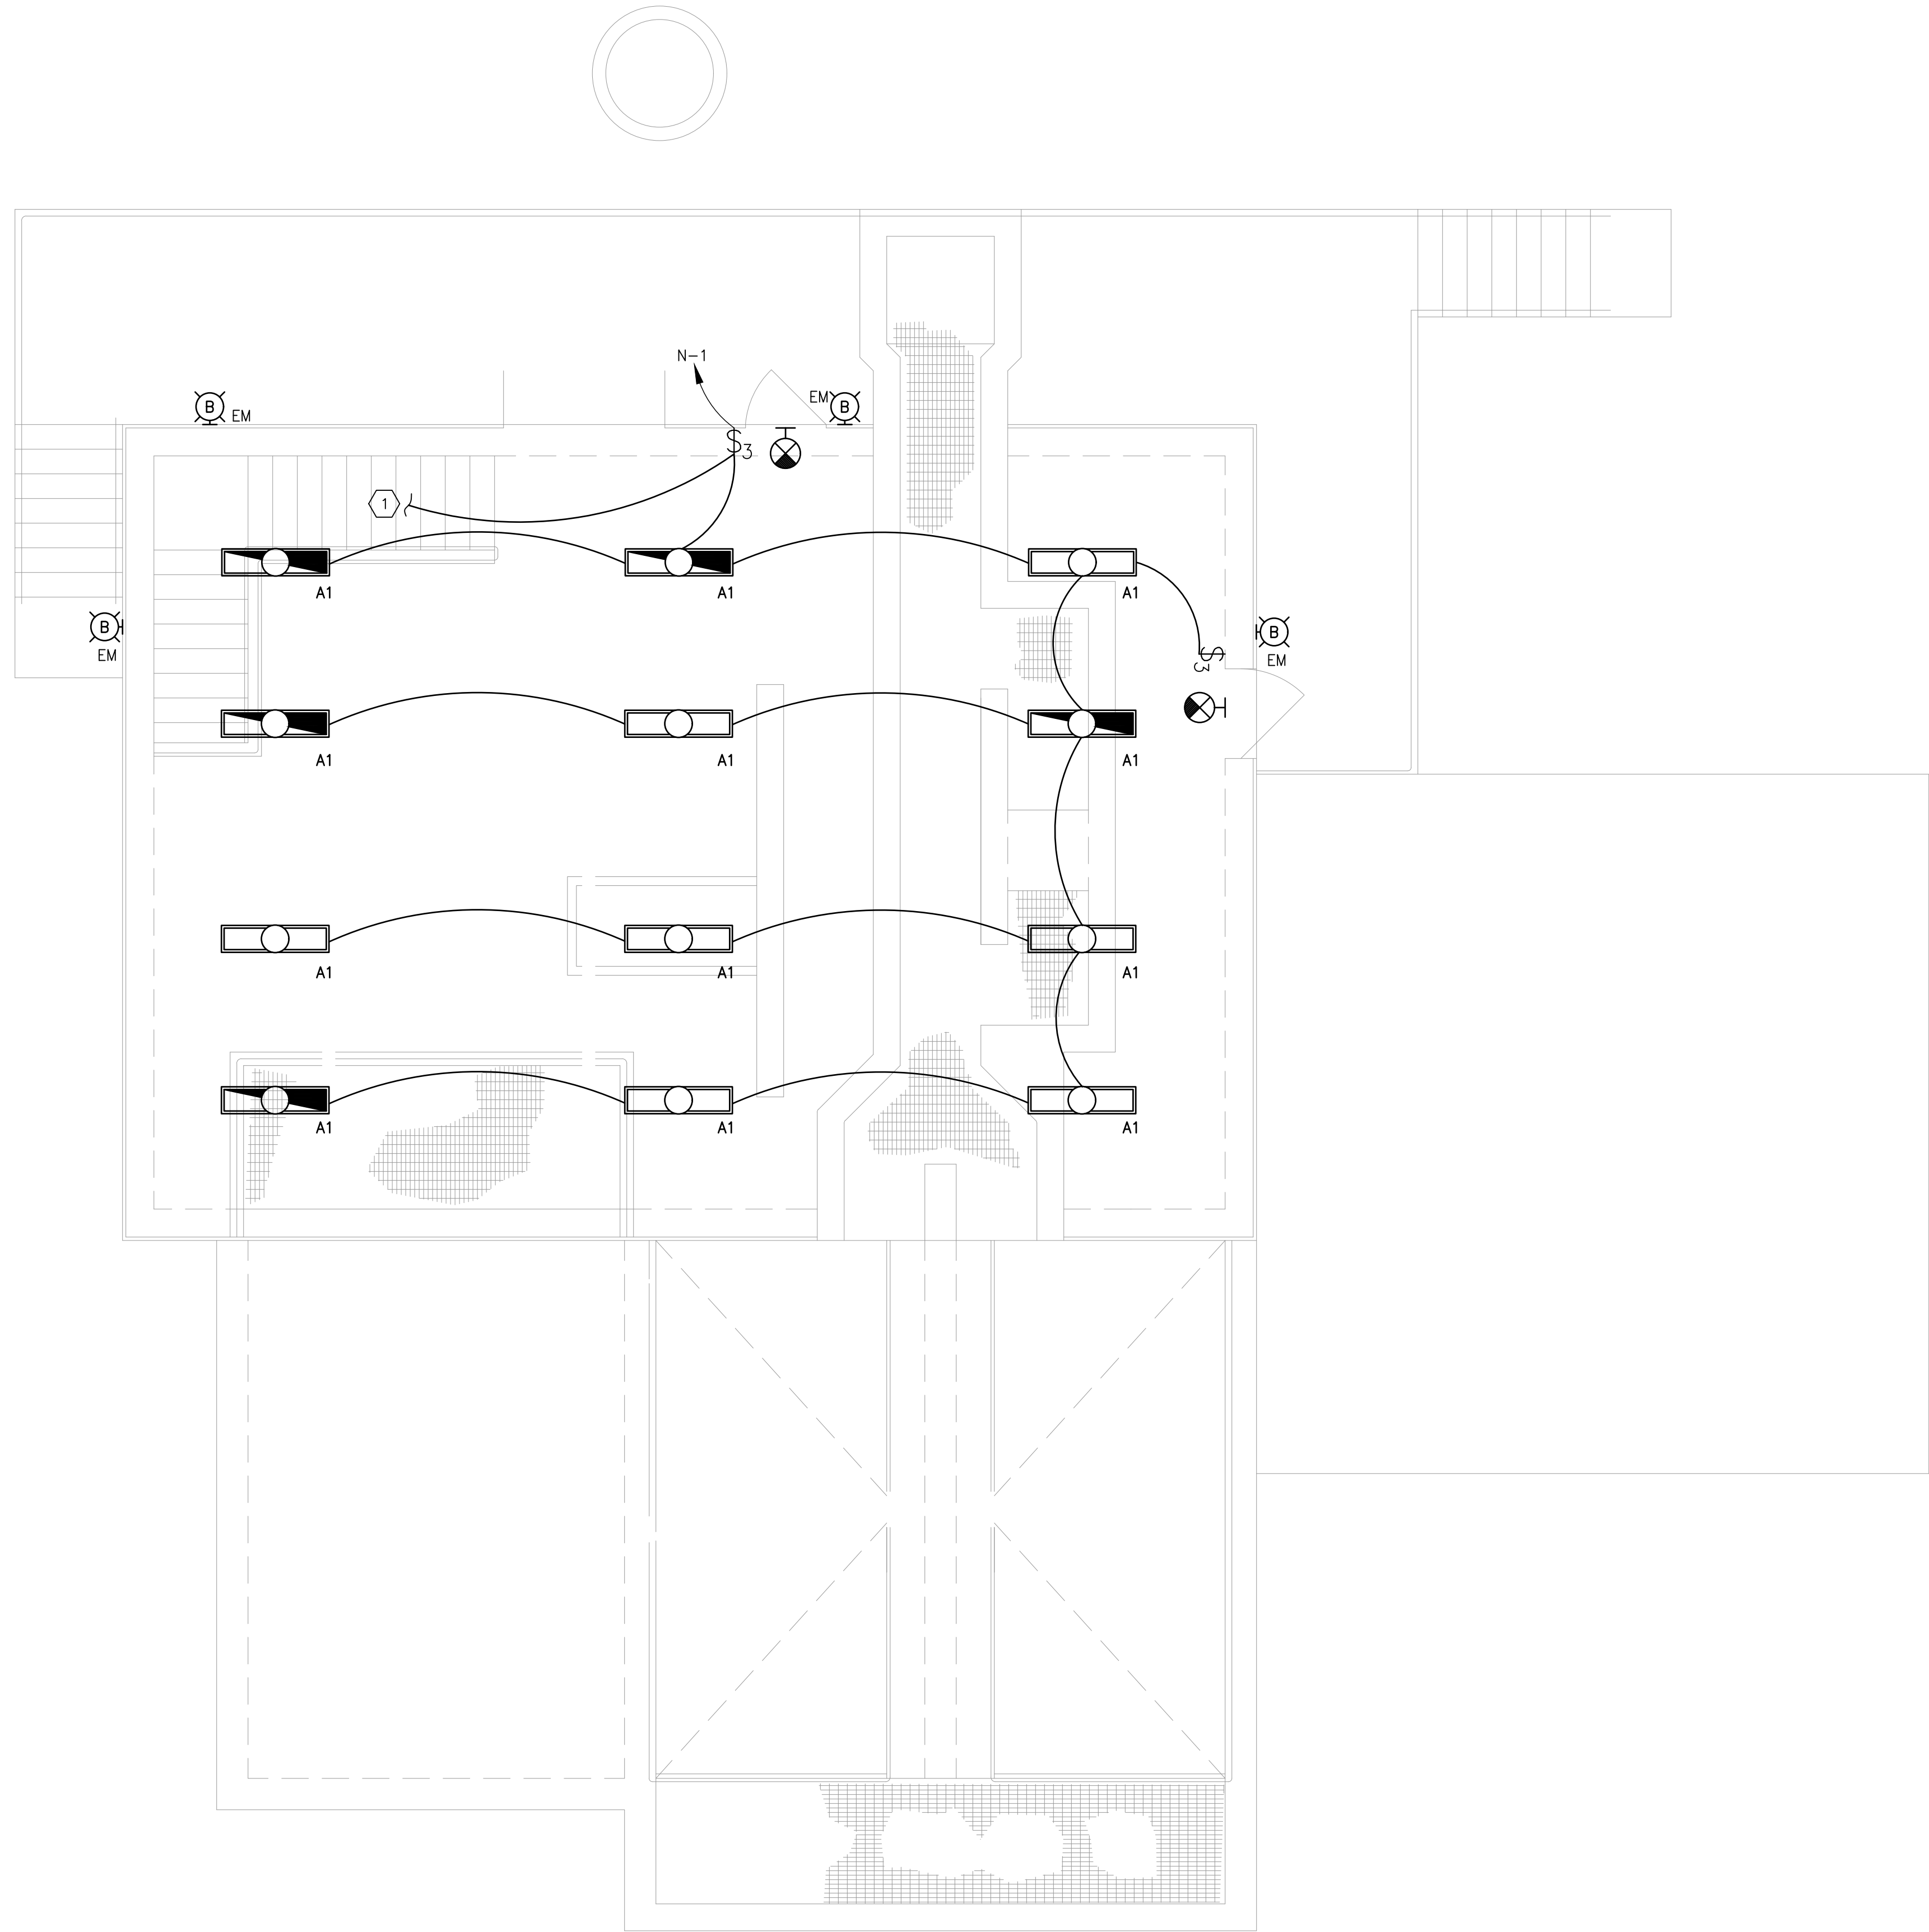

PLAN NORTH

UPPER FLOOR LIGHTING PLAN - PRETREATMENT BUILDING  
SCALE: 1/4" = 1'-0"

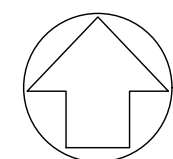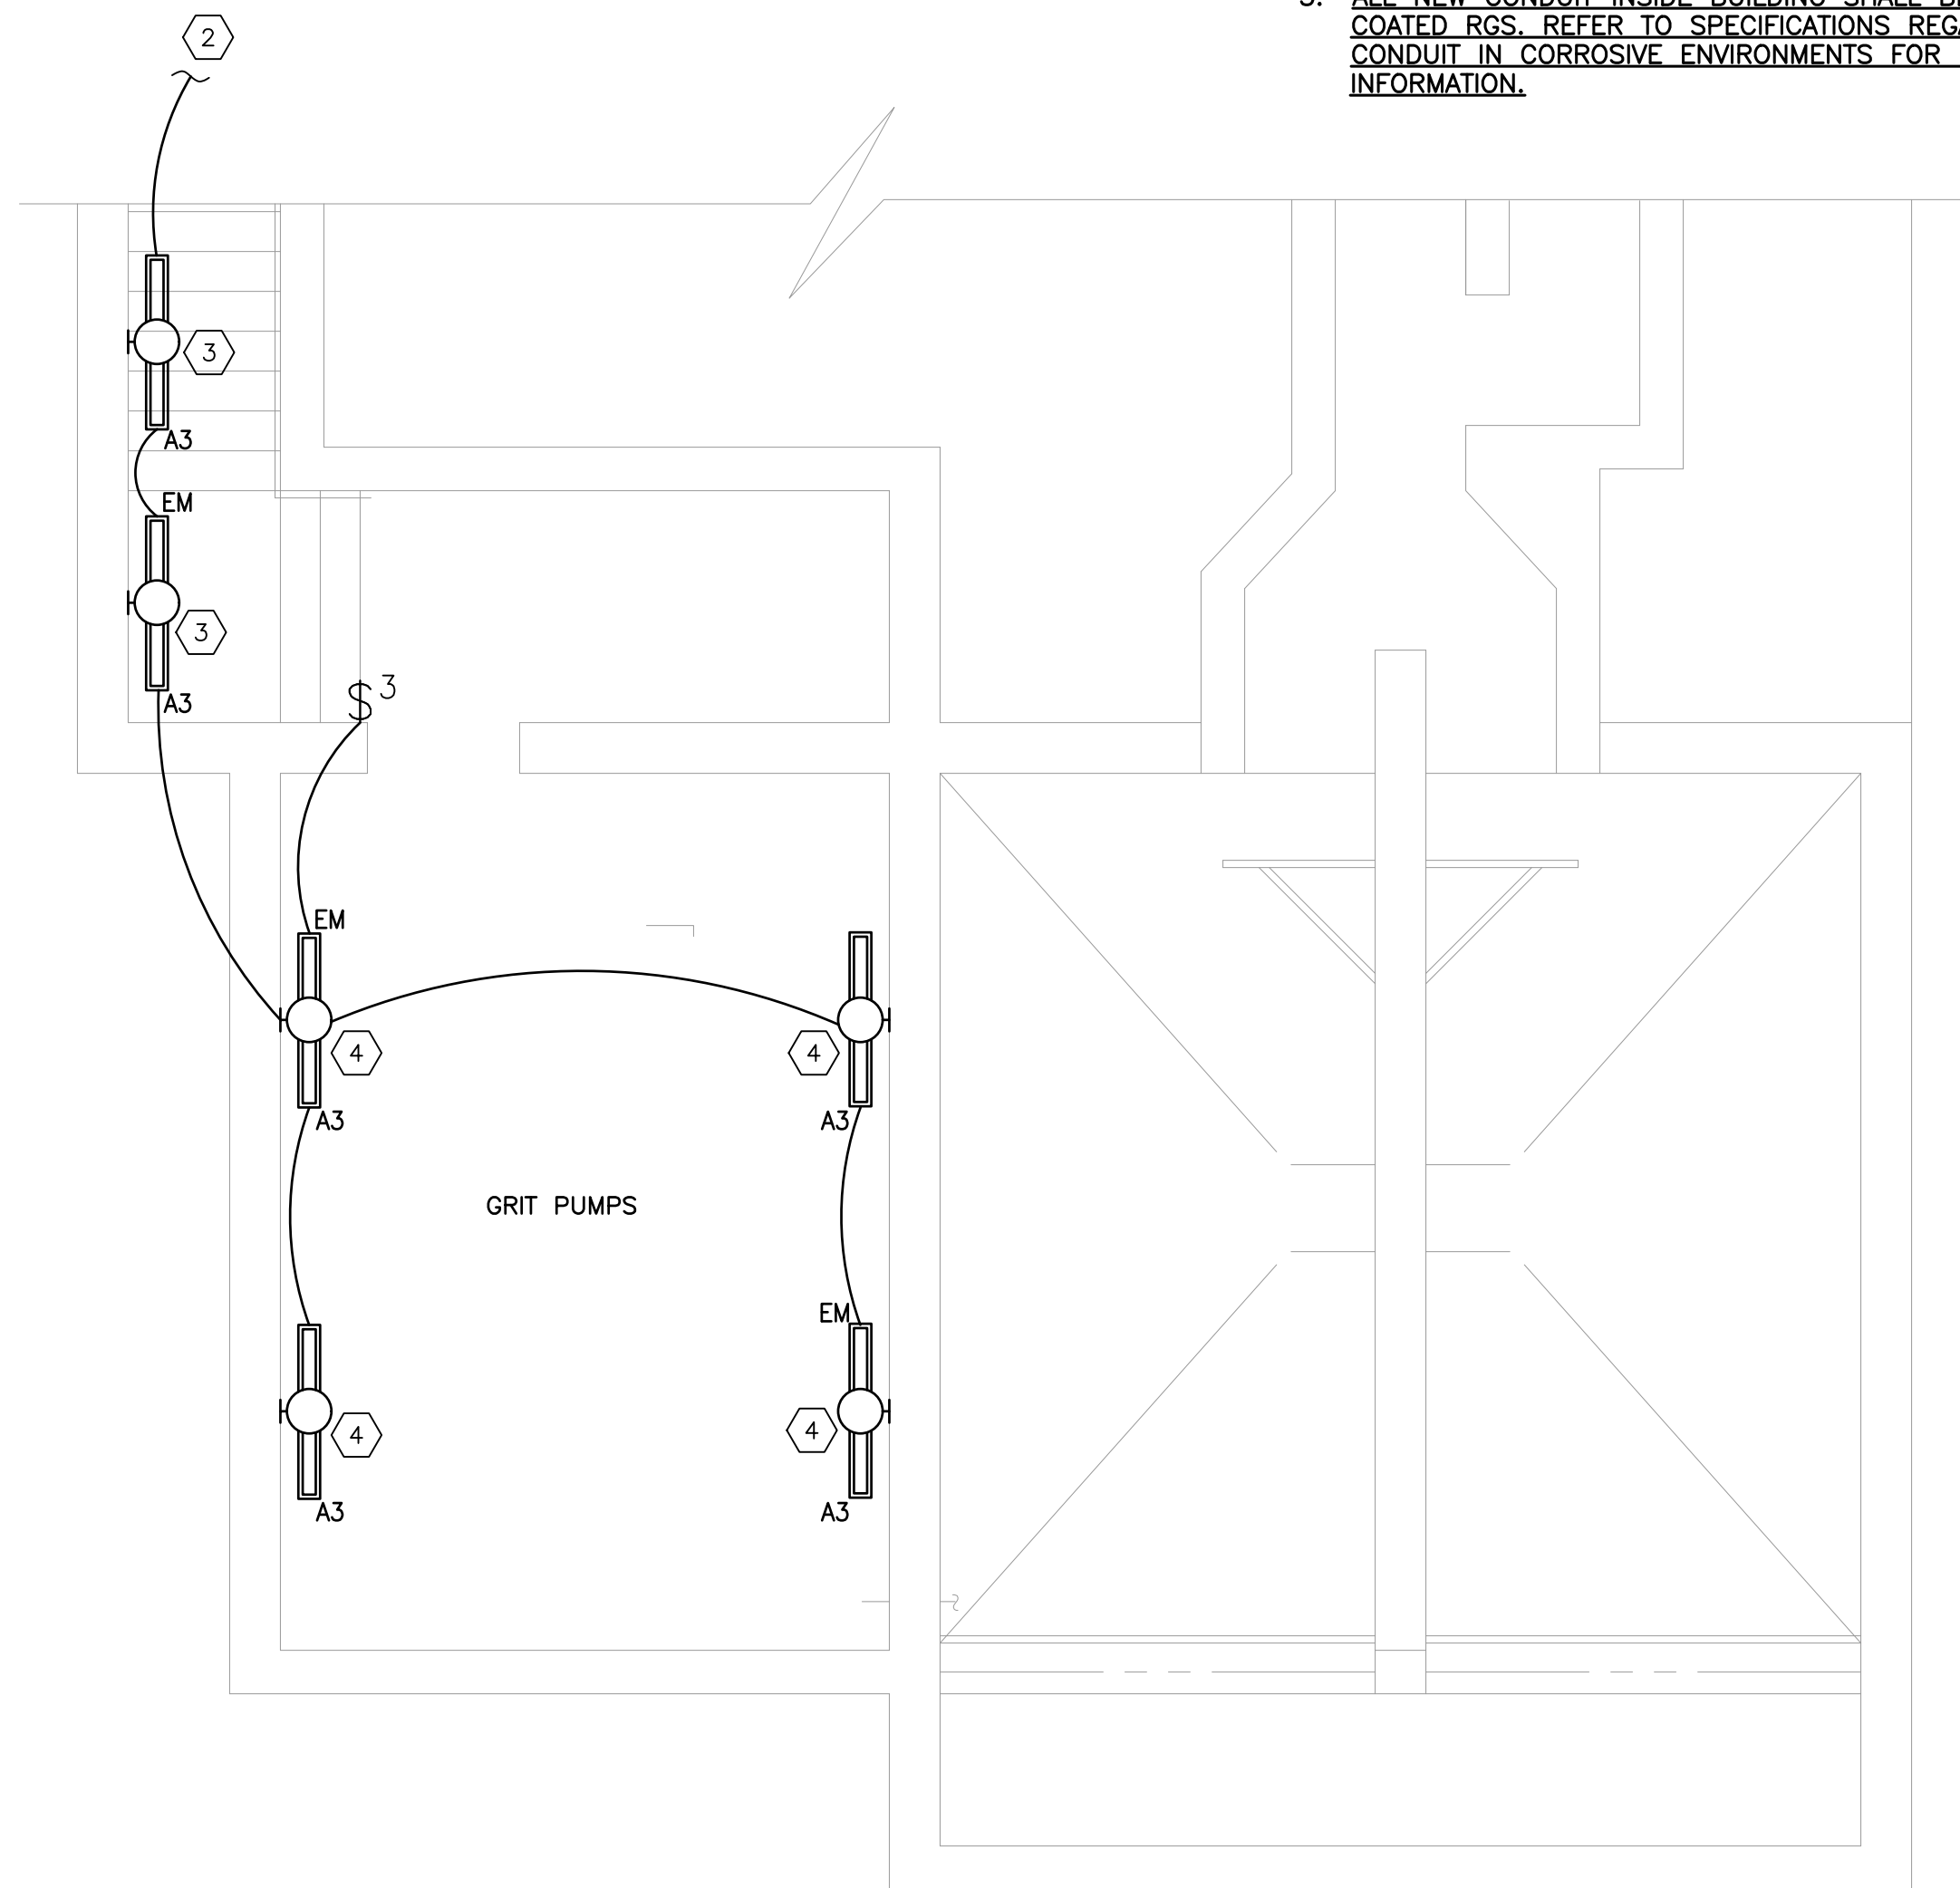

PLAN NORTH


LOWER FLOOR LIGHTING PLAN - PRETREATMENT BUILDING  
SCALE: 1/4" = 1'-0"

8'-0" 2'-0" 0 4'-0" 8'-0"  
SCALE: 1/4" = 1'-0"

SHEET GENERAL DEMOLITION NOTES:  
1. DISCONNECT AND REMOVE ALL LIGHT FIXTURES AND SWITCHES. EXISTING LIGHTS AND SWITCHES NOT SHOWN.

SHEET KEYED NOTES:  
1. SWITCH FOR LIGHTS BELOW.  
2. LIGHTS SWITCHED FROM ABOVE.  
3. MOUNT LIGHT FIXTURE 8' ABOVE LANDING AND STAIR TREADS. COORDINATE EXACT MOUNTING LOCATION OF FIXTURE WITH ACTUAL CONDITIONS FOR MAXIMUM COVERAGE.  
4. MOUNT LIGHT FIXTURES AT 10' AFF. COORDINATE EXACT MOUNTING LOCATION OF FIXTURE WITH ACTUAL CONDITIONS FOR MAXIMUM COVERAGE.

SHEET GENERAL NOTES:  
1. SEE LIGHT FIXTURE SCHEDULE, SHEET E701.  
2. CIRCUIT ALL EXTERIOR LIGHTING TO N-3  
3. CONNECT EXIT SIGNAGE TO UNSWITCHED PORTION OF N-3.  
4. WHERE INTEGRAL BATTERY IS NOT AVAILABLE FOR FIXTURE INDICATED AS 'EM', PROVIDE A REMOVE BATTERY PACK IN AN ACCESSIBLE LOCATION. IF A REMOTE BATTERY IS NECESSARY FOR FIXTURES IN A CLASSIFIED AREA, PROVIDE BATTERY IN AN ACCESSIBLE LOCATION IN AN ADJACENT NON-CLASSIFIED AREA.  
5. REFER TO EQUIPMENT CONDITIONS AND MINIMUM RATINGS SCHEDULE ON SHEET E701.  
6. EXISTING CIRCUITRY MAY BE REUSED IN CLASSIFIED SPACES IF IT IS RATED FOR CLASS 1 DIVISION 1 AND IN GOOD CONDITION. IF CIRCUITRY DOES NOT MEET THIS STANDARD, REPLACE AS NECESSARY.  
4. ENTIRE METAL BUILDING STRUCTURE TO BE DEMOLISHED, AND REPLACED. ALL ELECTRICAL CONDUIT, WIRING, DEVICES, AND FIXTURES ATTACHED OR SUPPORTED BY METAL BUILDING STRUCTURE SHALL BE DEMOLISHED. NEW EQUIPMENT INDICATED ON THIS SHEET AS EXISTING TO BE RECONNECTED AND SERVED BY CONDUIT SUPPORTED BY THE METAL BUILDING STRUCTURE SHALL BE RECIRCUITED USING ALL NEW CONDUIT AND CONDUCTORS.  
5. ALL NEW CONDUIT INSIDE BUILDING SHALL BE PVC COATED RGS. REFER TO SPECIFICATIONS REGARDING CONDUIT IN CORROSIVE ENVIRONMENTS FOR MORE INFORMATION.

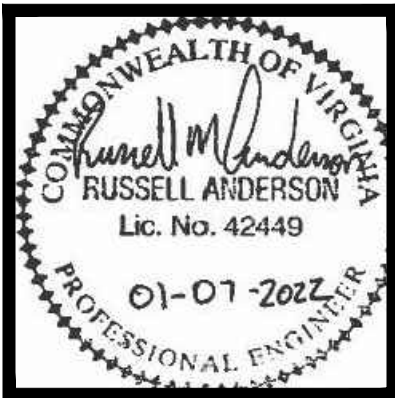

TOWN OF RICHLANDS - 4.0 MGD WWTP  
UPGRADES AND IMPROVEMENTS  
LOWER AND UPPER LIGHTING PLAN -  
PRETREATMENT BUILDING

No.	Date	Purpose of Document Issue
1	10-21-20	ISSUED FOR 60% REVIEW
2	01-07-22	ISSUED FOR BIDS



Designed	JBC
Drawn	JBC,TKR,TLP
Checked	RMA
Date	1/07/2022

Project No.  
14249-00




Sheet No.  
E102



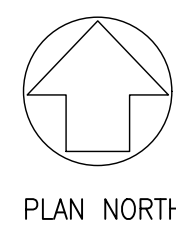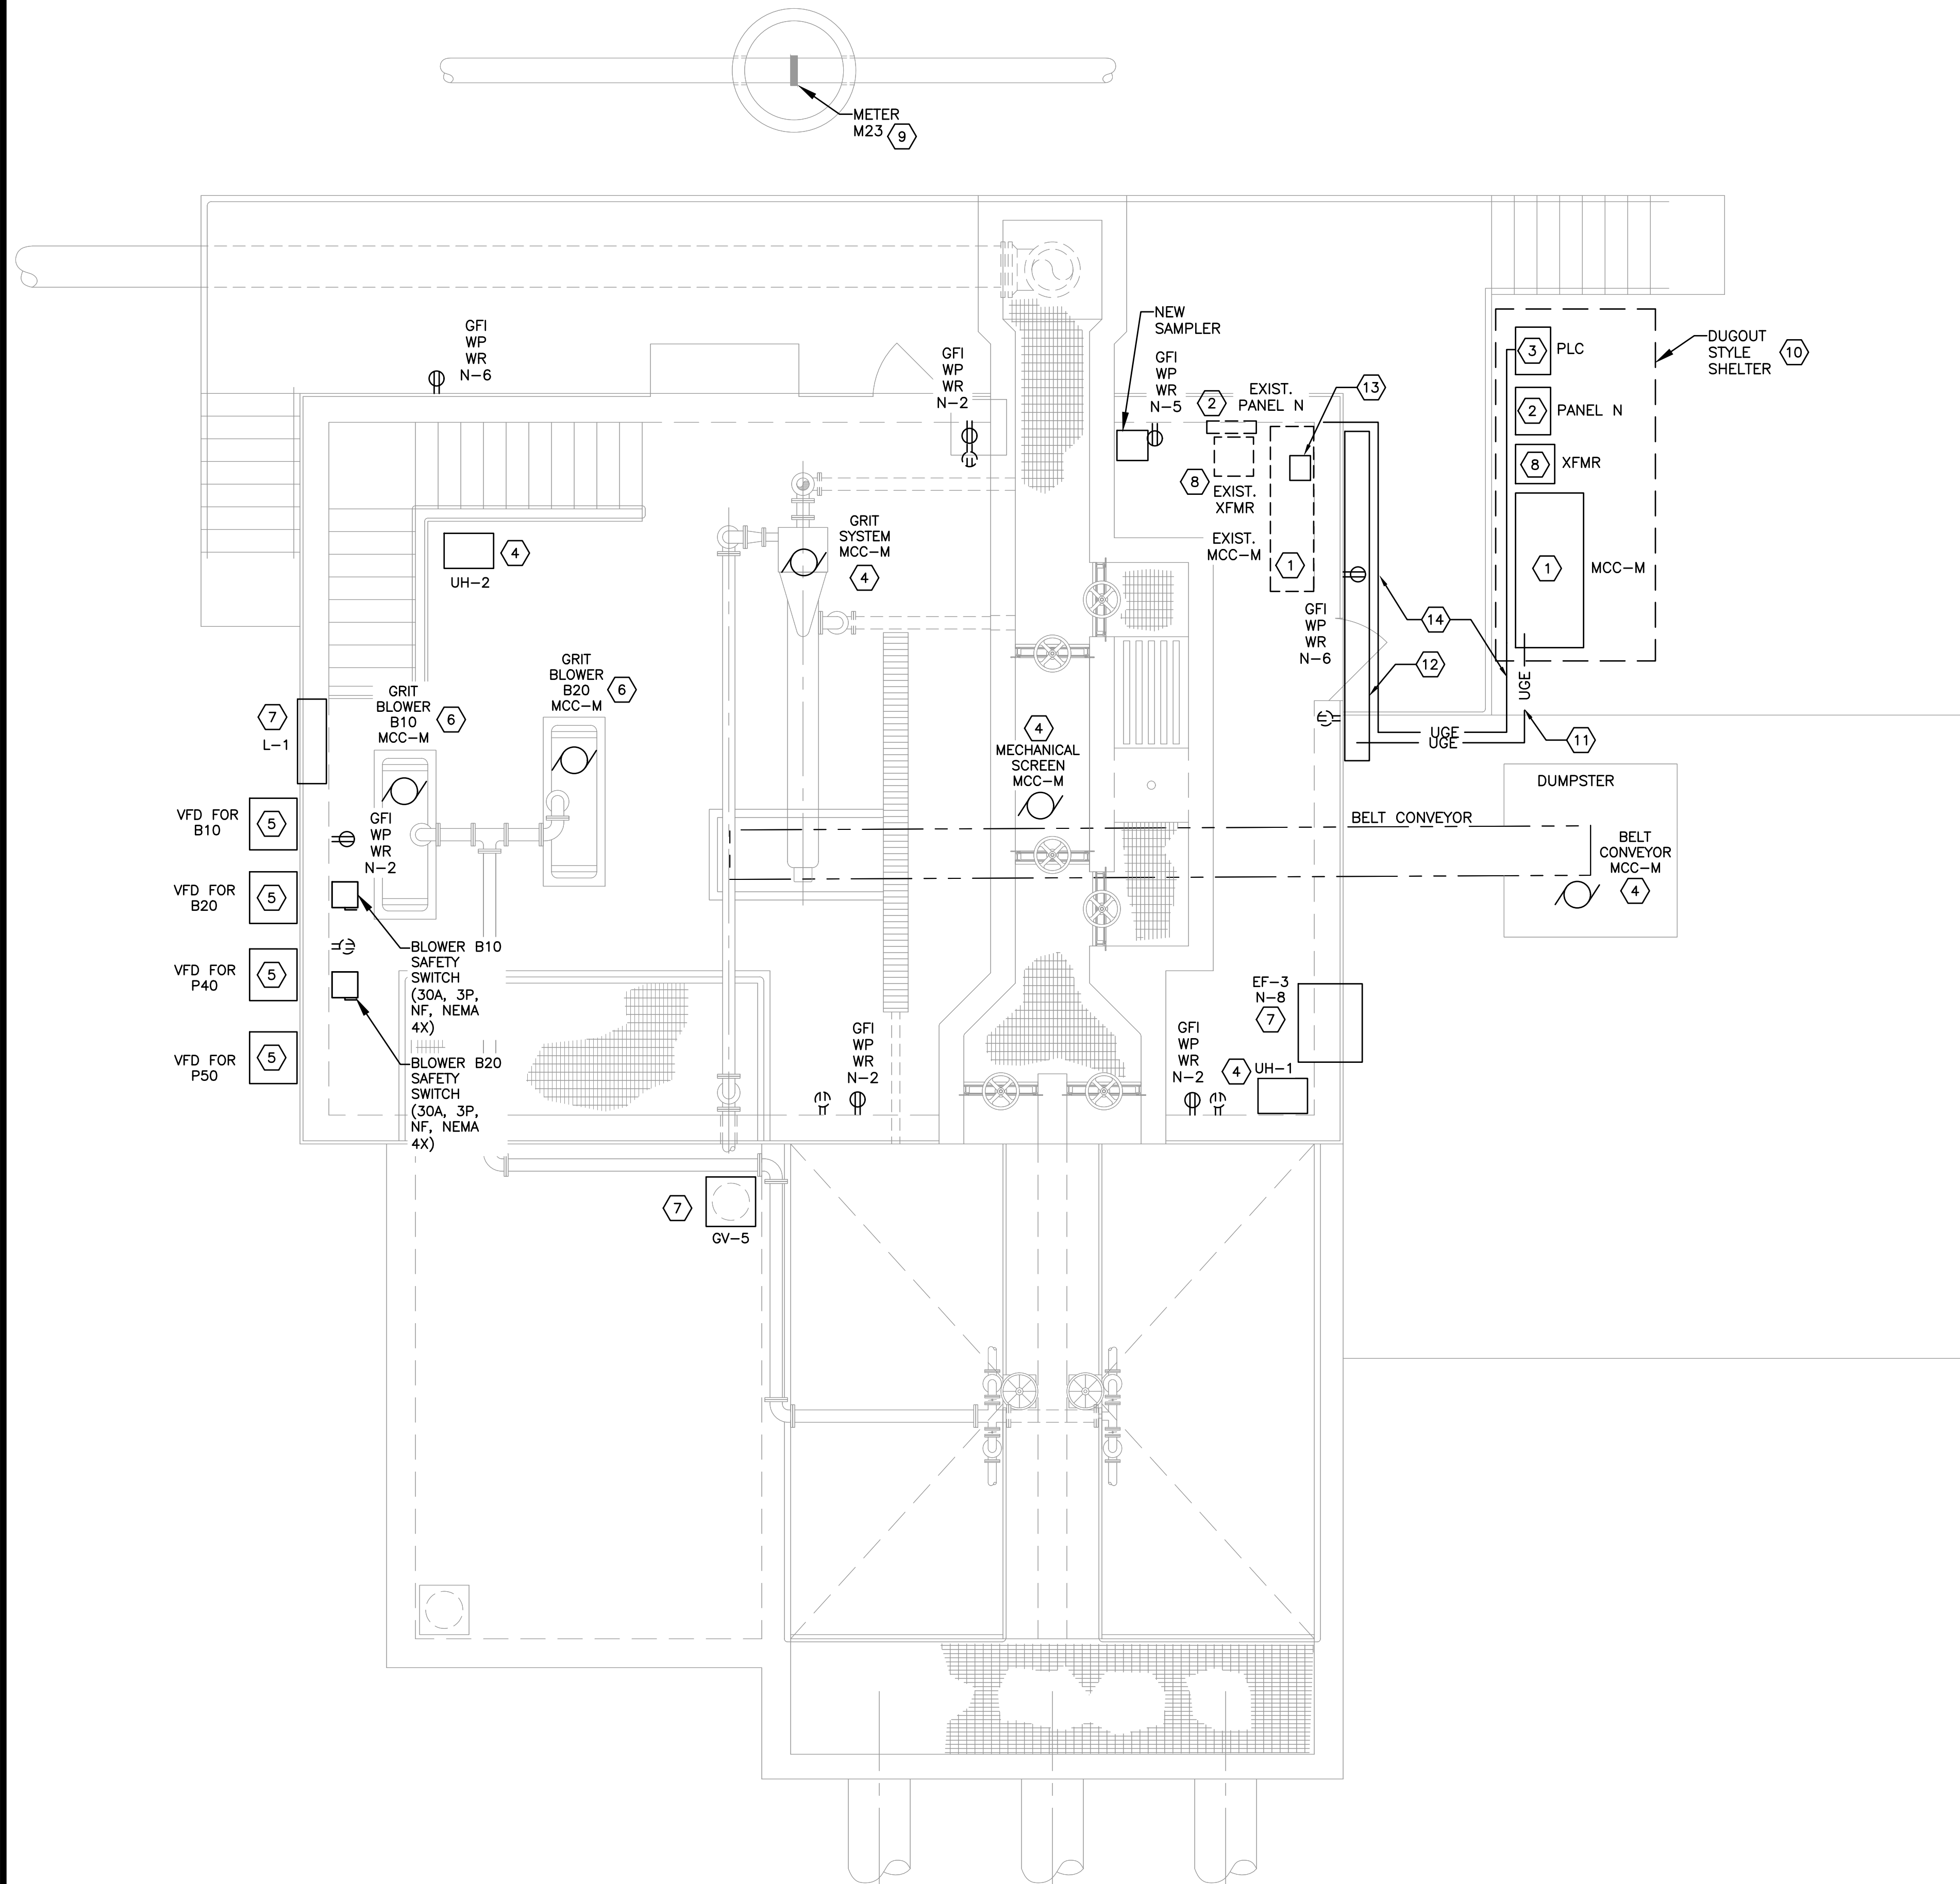

UPPER FLOOR POWER PLAN - PRETREATMENT BUILDING

SCALE: 1/4" = 1'-0"

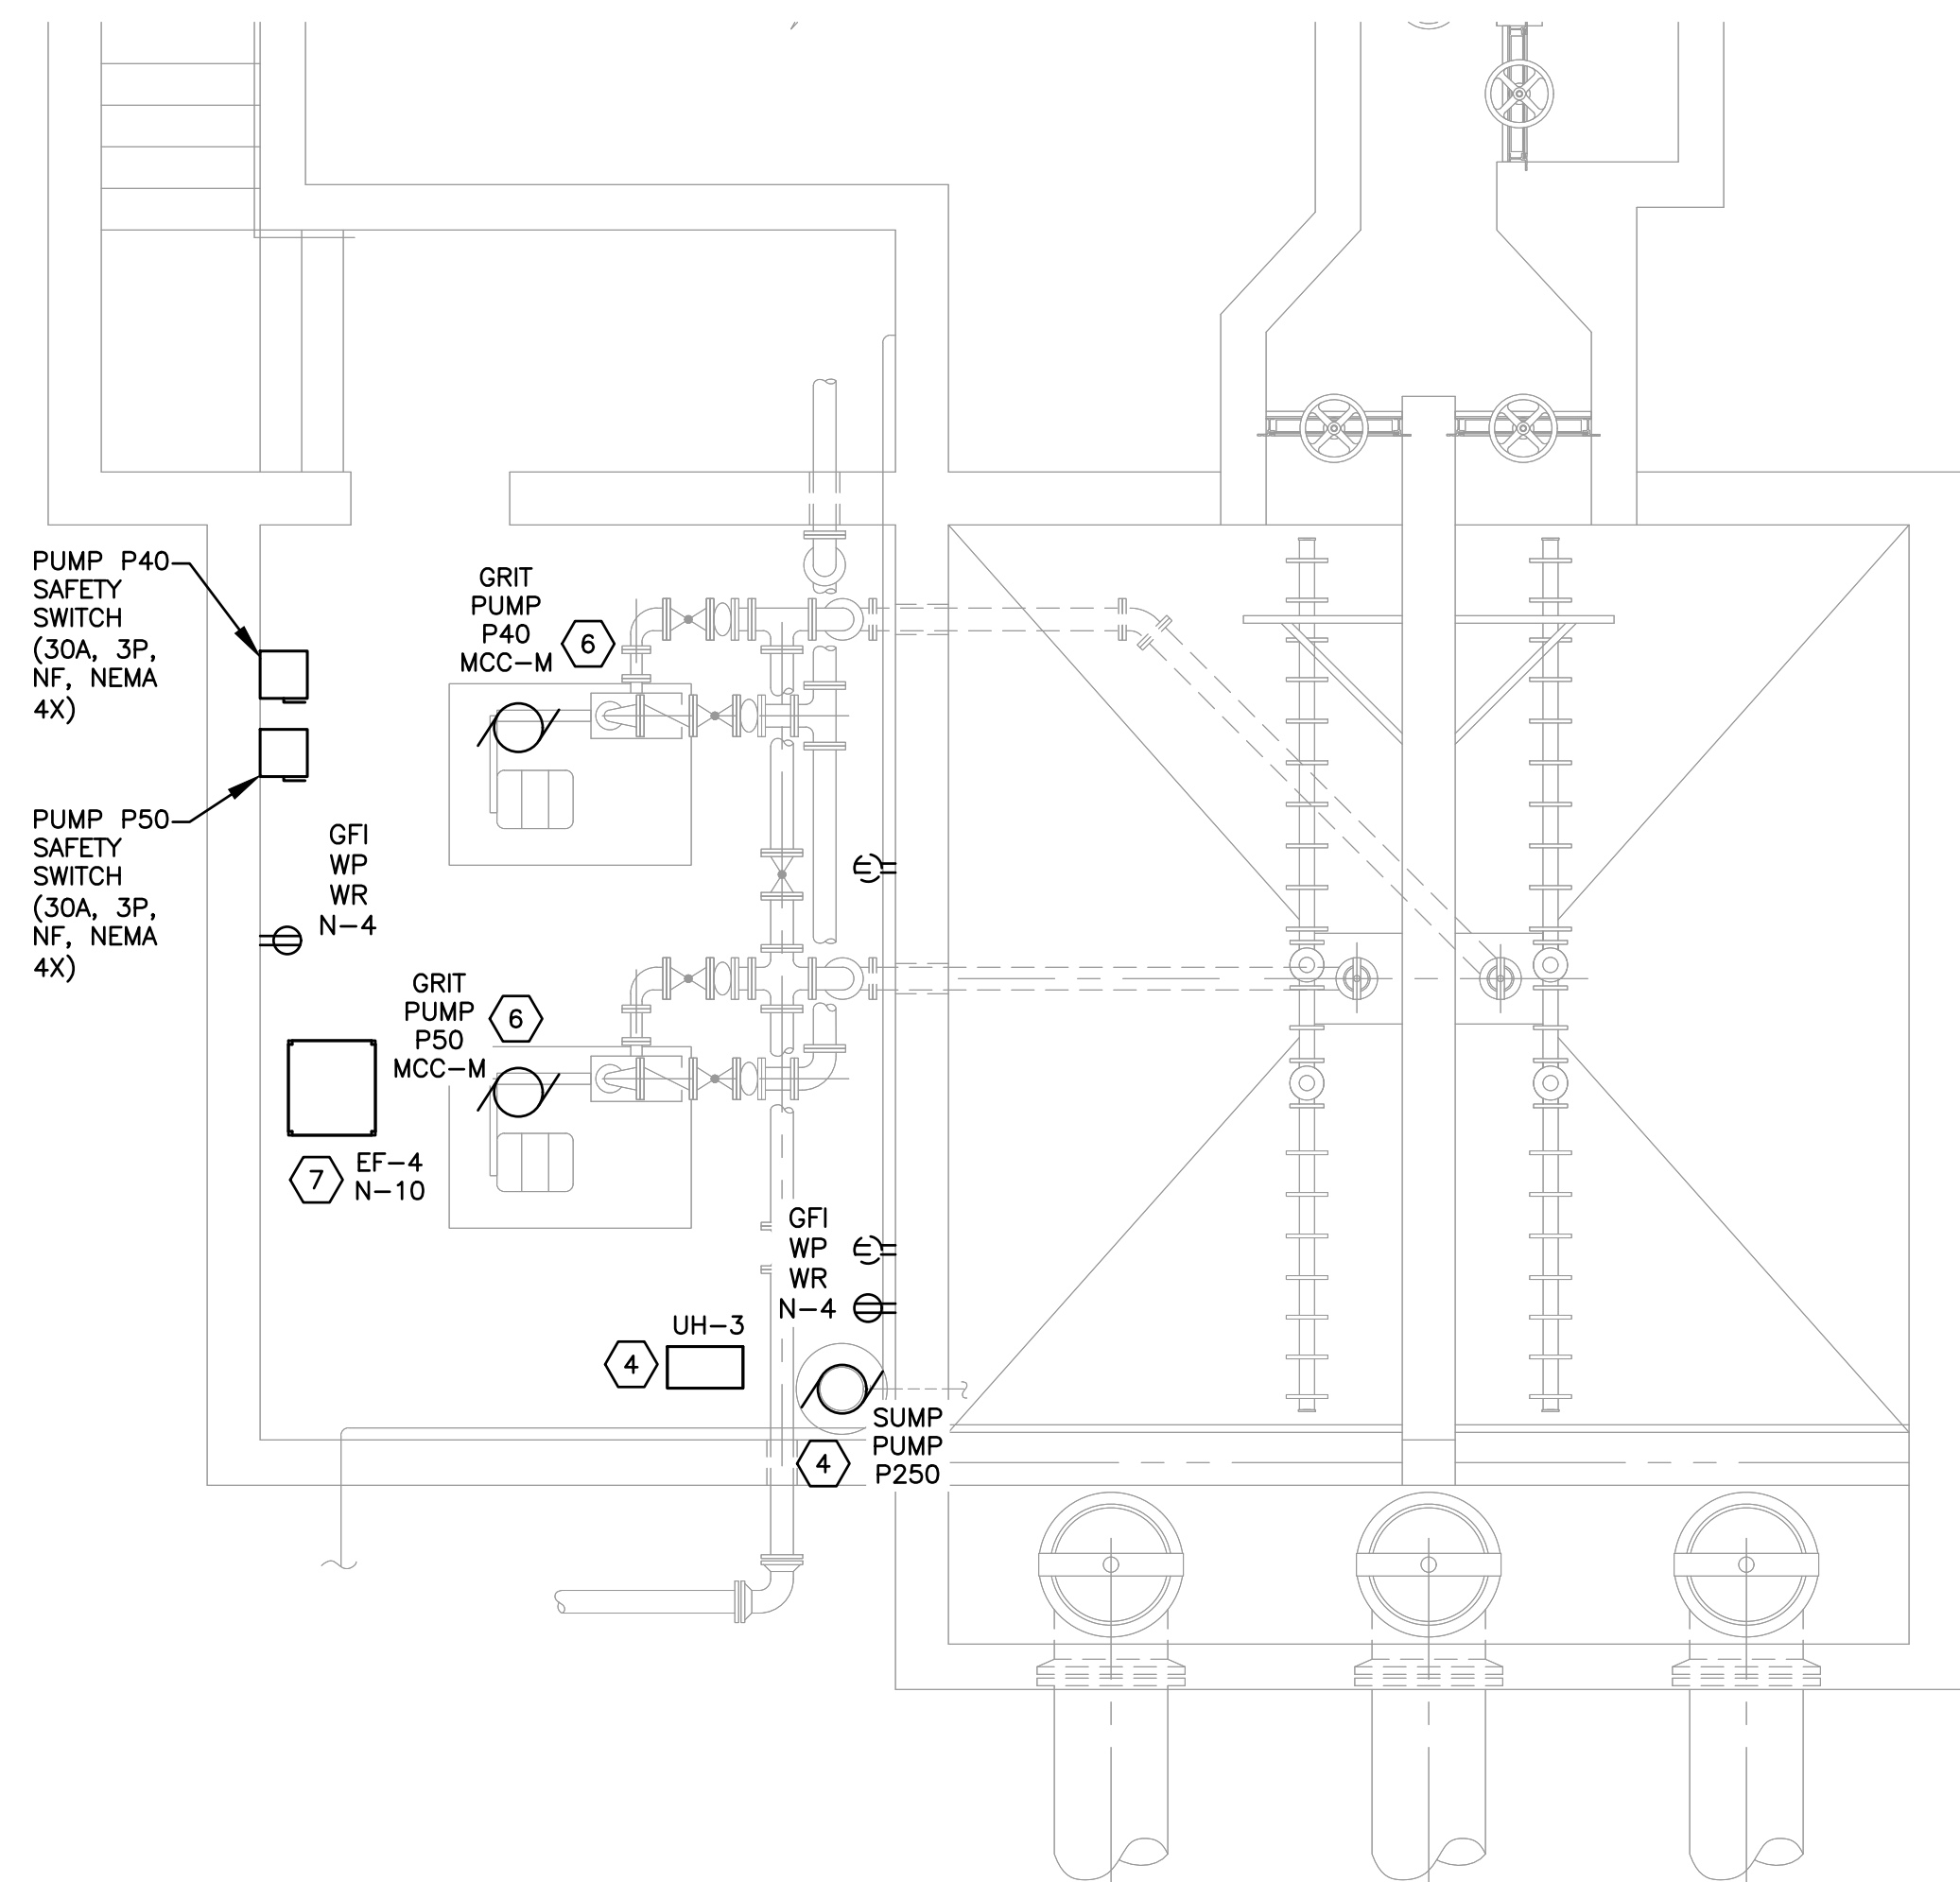

LOWER FLOOR POWER PLAN - PRETREATMENT BUILDING

SCALE: 1/4" = 1'-0"

8'-0" 2'-0" 0 4'-0" 8'-0"  
SCALE: 1/4" = 1'-0"

LEGEND:

EXISTING TO BE REMOVED ---

NEW —

SHEET GENERAL NOTES:

1. REFER TO EQUIPMENT CONDITIONS AND MINIMUM RATINGS SCHEDULE ON SHEET E701.
2. COORDINATE EXACT LOCATION OF ALL EQUIPMENT WITH ACTUAL FIELD CONDITIONS. ENSURE NEC REQUIRED CLEARANCES.
3. PROVIDE SEALING FITTINGS FOR ALL ELECTRICAL CONDUITS PENETRATING THE BUILDING ABOVE AND BELOW GRADE.
4. ENTIRE METAL BUILDING STRUCTURE TO BE DEMOLISHED, AND REPLACED. ALL ELECTRICAL CONDUIT, WIRING, DEVICES, AND FIXTURES ATTACHED OR SUPPORTED BY METAL BUILDING STRUCTURE SHALL BE DEMOLISHED. NEW EQUIPMENT INDICATED ON THIS SHEET AS EXISTING TO BE RECONNECTED AND SERVED BY CONDUIT SUPPORTED BY THE METAL BUILDING STRUCTURE SHALL BE RE-CIRCUITED USING ALL NEW CONDUIT AND CONDUCTORS.
5. ALL NEW CONDUIT INSIDE BUILDING SHALL BE PVC COATED RGS. REFER TO SPECIFICATIONS REGARDING CONDUIT AND EQUIPMENT IN CORROSIVE ENVIRONMENTS FOR MORE INFORMATION.



SHEET KEYED NOTES:

1. EXISTING MOTOR CONTROL CENTER M TO BE DEMOLISHED. NEW NEMA-3R MOTOR CONTROL CENTER TO BE INSTALLED OUTSIDE BUILDING AS INDICATED.
2. EXISTING PANEL N TO BE DEMOLISHED. NEW NEMA-3R PANEL N TO BE INSTALLED OUTSIDE BUILDING AS INDICATED. RECONNECT EXISTING AND NEW EQUIPMENT TO NEW PANEL AS INDICATED ON THE PANEL SCHEDULE ON SHEET E701.
3. NEW NEMA-3R PLC CABINET WITH HMI CONTROLS. EXTEND EXIST. FIBER AND COPPER CONDUCTORS TO LOCATION INDICATED. REFER TO SHEET I101 FOR CONTROL DIAGRAMS AND LAYOUT FOR MORE INFORMATION.
4. DEMOLISH EXIST. EQUIPMENT AND CONNECT NEW EQUIPMENT TO OVERCURRENT PROTECTION IN MCC-M. PROVIDE A LOCAL MEANS OF DISCONNECTION. REFER TO MOTOR CONTROL CENTER SCHEDULE ON E703.
5. PROVIDE NEMA-3R VFD. COORDINATE EXACT LOCATION WITH FIELD CONDITIONS. ENSURE NEC REQUIRED CLEARANCES.
6. DEMOLISH EXIST. MOTOR AND CIRCUIT NEW MOTOR THROUGH VFD TO OVERCURRENT PROTECTION IN MCC-M.
7. PROVIDE 120V 20AMP-1P CIRCUIT FOR MOTORIZED DAMPERS/LOUVERS. INTERLOCK MECHANICAL UNITS BY M001 REQUIREMENTS. SEE E502 FOR DAMPER CONTROL DETAIL.
8. EXIST. TRANSFORMER TO BE DEMOLISHED. PROVIDE NEW NEMA-3R TRANSFORMER OUTSIDE AS SHOWN. SEE ONE-LINE DIAGRAM ON SHEET E601 FOR DETAILS.
9. DEMOLISH EXIST. METER. CONNECT NEW METER TO EXIST. CIRCUITRY.
10. PROVIDE PRE-ENGINEERED DUG-OUT STYLE SHELTER, EQUAL TO APC SHELTERS DUGOUT STYLE RECTANGULAR. PROVIDE CHANNEL MOUNTING FOR NON-GROUND MOUNTED EQUIPMENT INDICATED. REFER TO SIMILAR DETAILS FOR AERATION BASIN VFD SHELTER AND PAD - SHEET E205. CIRCUIT LIGHTS AND CONVENIENCE RECEPTACLE TO N-7. COORDINATE STRUCTURE DIMENSIONS WITH EQUIPMENT DIMENSIONS AND CLEARANCES OF EQUIPMENT PROVIDED. PROVIDE A HOUSEKEEPING PAD FOR GROUND MOUNTED EQUIPMENT.
11. PROVIDE UNDERGROUND CONDUIT TO WIREWAY AS REQUIRED FOR CIRCUITS BETWEEN BUILDING AND EQUIPMENT.
12. PROVIDE NEW 12" X 12" NEMA-4X WIREWAY. WIREWAY SHALL BE MOUNTED HORIZONTALLY AT 8'-0" AS SHOWN, THEN TURN DOWN WALL, AND EXTEND TO GRADE BETWEEN EDGE OF ELEVATED WALKWAY AND CONVEYOR. SEE ONE-LINE DIAGRAM - SHEET E601.
13. PROVIDE 225A-3P ENCLOSED BREAKER IN NEMA-4X ENCLOSURE. CONNECT EXISTING BUILDING SERVICE CONDUCTORS IN NEW PVC COATED RGS CONDUIT TO EXISTING CONDUIT EXITING SLAB. CONNECT SUPPLEMENTARY GROUND TO GROUND BAR IN THIS ENCLOSURE. DO NOT BOND TO NEUTRAL. SEE ONE-LINE DIAGRAM - SHEET E601.
14. PROVIDE AN ADDITIONAL 2" UNDERGROUND AND THEN PARALLEL TO WIREWAY FOR REQUIRED LOW VOLTAGE CABLING BETWEEN PLC AND DEVICES.



TOWN OF RICHLANDS - 4.0 MGD WWTP  
UPGRADES AND IMPROVEMENTS

LOWER AND UPPER POWER PLAN -  
PRETREATMENT BUILDING

Purpose of Document Issue  
ISSUED FOR 60% REVIEW  
ISSUED FOR BIDS

Date  
10-21-20  
01-07-22

Designed JBC  
Drawn JBC,TKR,TLP  
Checked RMA  
Date 1/07/2022

Project No.  
14249-00




THOMPSON  
& LITTON

Sheet No.

E202



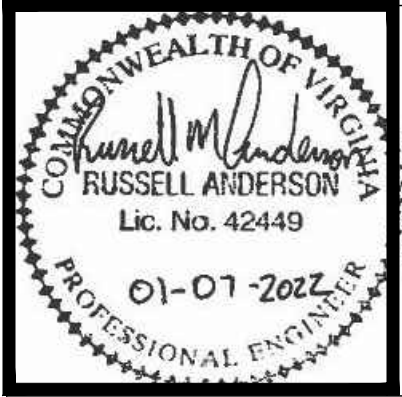

TOWN OF RICHLANDS - 4.0 MGD WWTP  
UPGRADES AND IMPROVEMENTS

POWER PLAN - PRIMARY CLARIFIERS



Purpose of Document Issue		ISSUED FOR 60% REVIEW		ISSUED FOR BIDS	
No.	Date	No.	Date	No.	Date
	10-21-20		01-07-22		

Designed	JBC
Drawn	JBC,TKR,TLP
Checked	RMA
Date	1/07/2022

Project No.	14249-00
-------------	----------





Sheet No.	E203
-----------	------

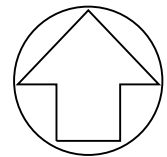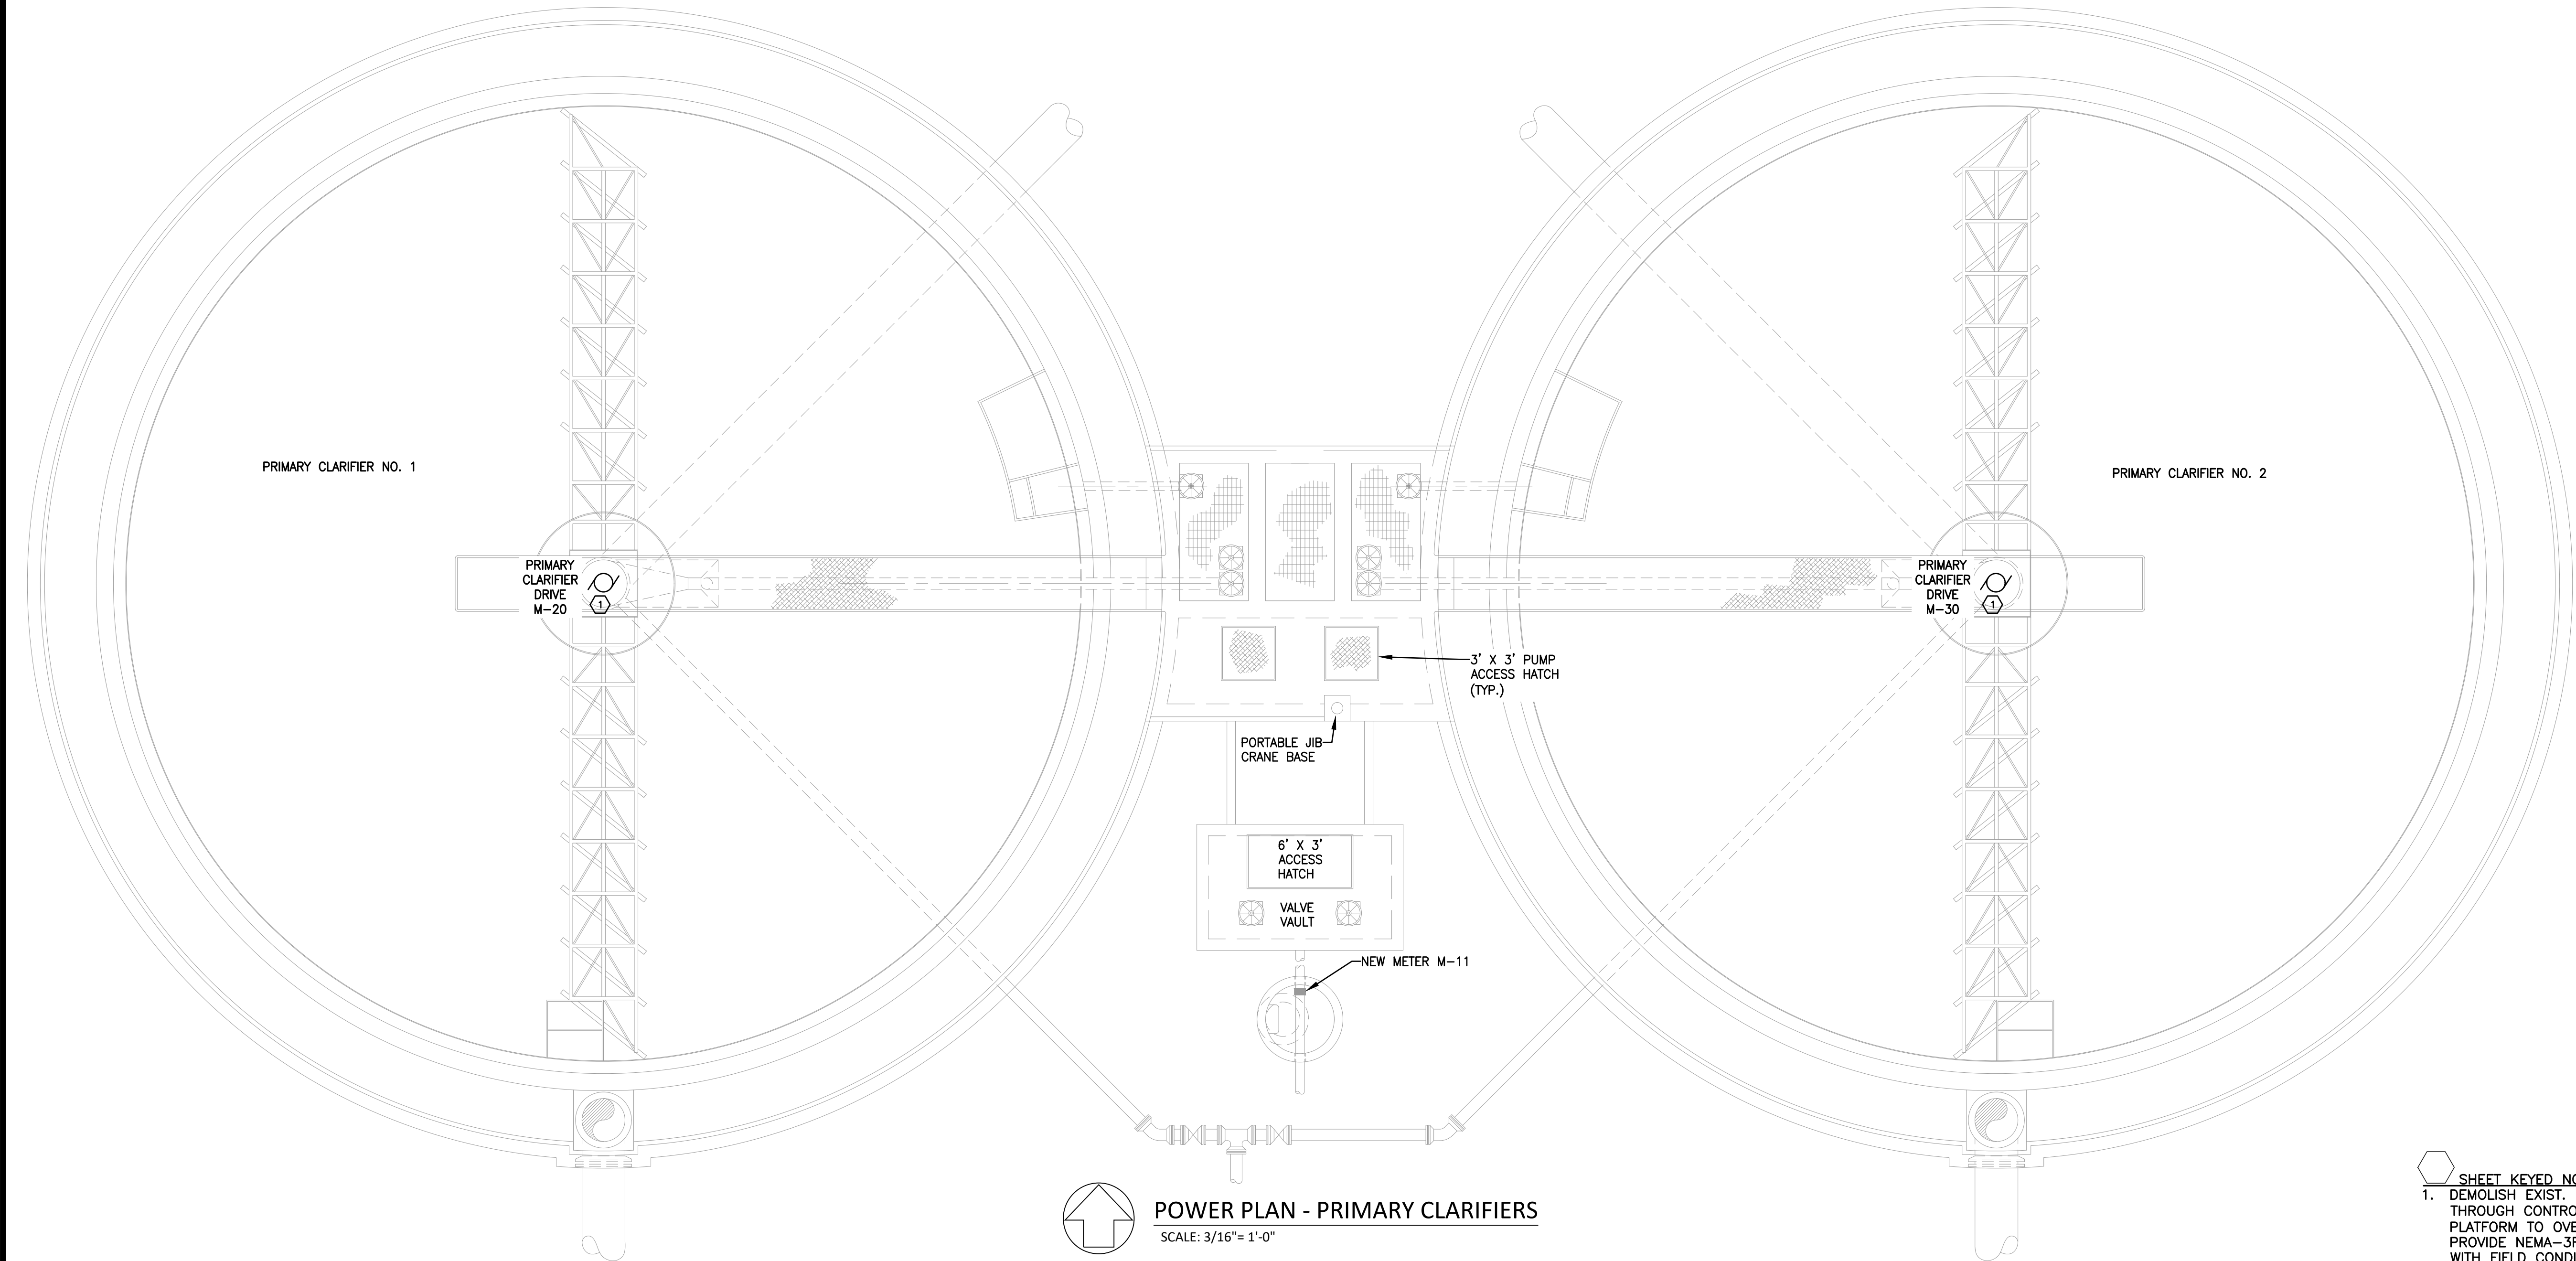

POWER PLAN - PRIMARY CLARIFIERS  
SCALE: 3/16"= 1'-0"

PLAN NORTH

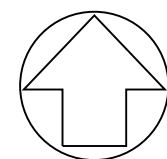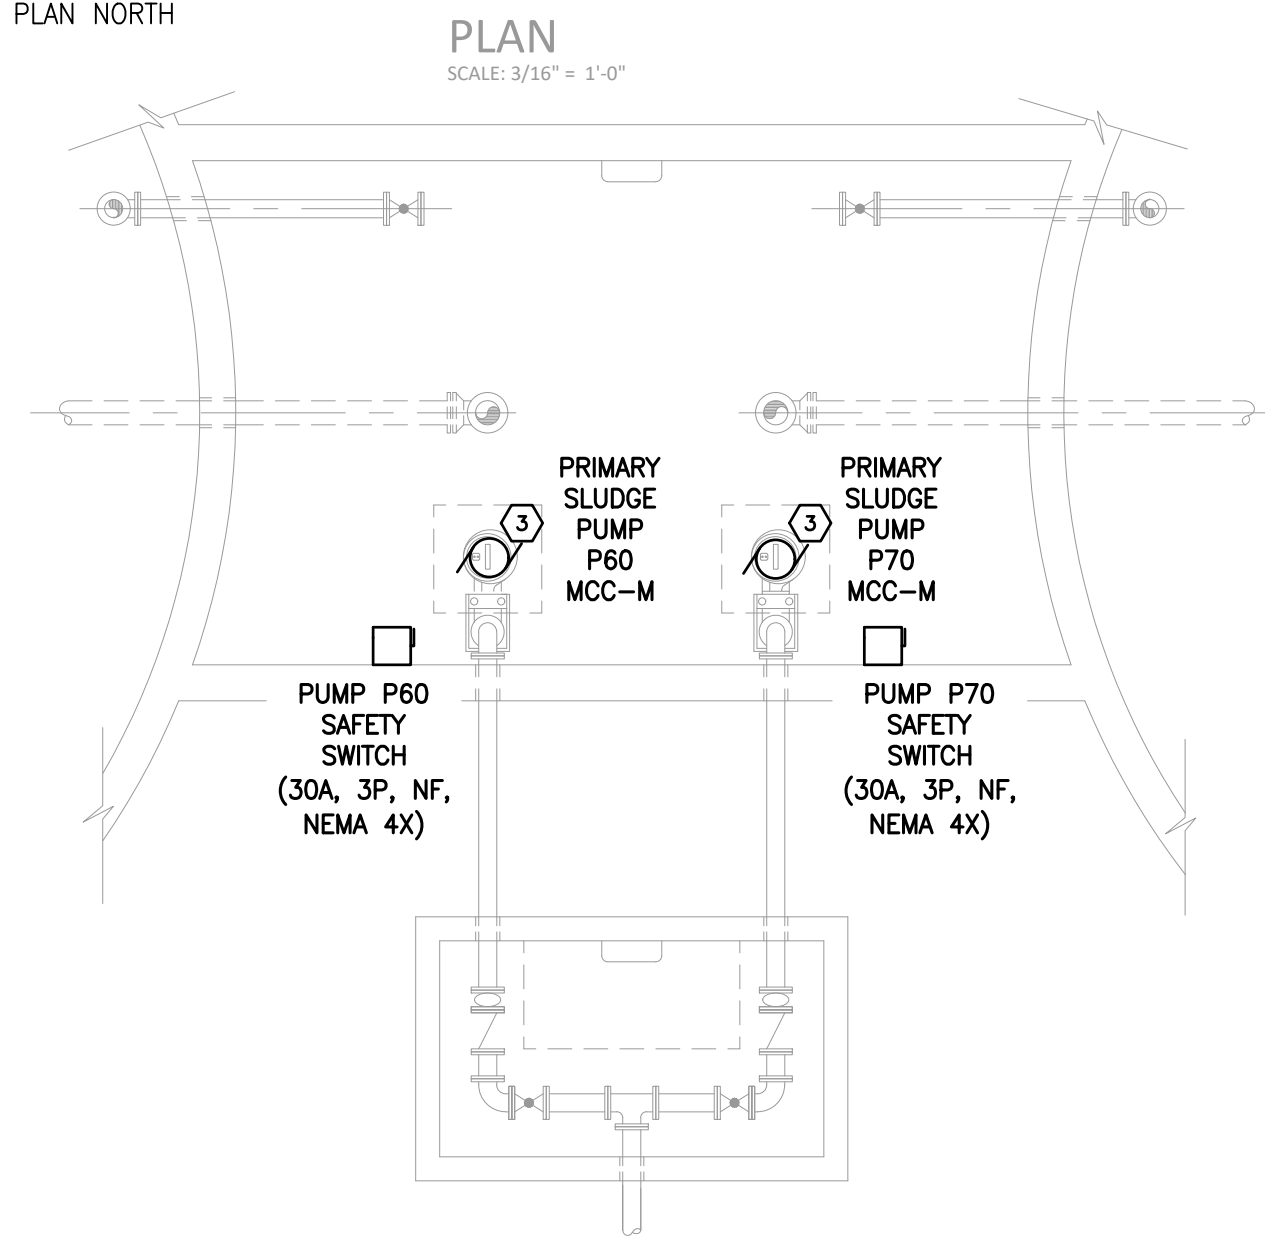

POWER PLAN - PRIMARY CLARIFIERS AT PUMP LEVEL  
SCALE: 3/16"= 1'-0"

PLAN NORTH




SHEET KEYED NOTES:


1. DEMOLISH EXIST. MOTOR AND CIRCUIT NEW MOTOR THROUGH CONTROL PANEL/VFDs ON ACCESS PLATFORM TO OVERCURRENT PROTECTION IN MCC-M. PROVIDE NEMA-3R VFD. COORDINATE EXACT LOCATION WITH FIELD CONDITIONS. ENSURE NEC REQUIRED CLEARANCES.
2. DEMOLISH EXIST. MOTOR AND CIRCUIT NEW MOTOR THROUGH VFD TO OVERCURRENT PROTECTION. REFER TO MOTOR CONTROL CENTER SCHEDULE ON E703.
3. DEMOLISH EXIST. EQUIPMENT AND CONNECT NEW EQUIPMENT TO OVERCURRENT PROTECTION IN MCC-M. PROVIDE A LOCAL MEANS ON DISCONNECTION. REFER TO MOTOR CONTROL CENTER SCHEDULE ON E703.

SHEET GENERAL NOTES:

1. REFER TO EQUIPMENT CONDITIONS AND MINIMUM RATINGS SCHEDULE ON SHEET E701.
2. COORDINATE EXACT LOCATION OF ALL EQUIPMENT WITH ACTUAL FIELD CONDITIONS. ENSURE NEC REQUIRED CLEARANCES.
3. FOR ALL EQUIPMENT, EXIST. CIRCUITRY MAY BE EXTENDED TO NEW MCC-M LOCATION AND REUSED IF IN GOOD CONDITION AND OF SUFFICIENT SIZE, AMPACITY, AND CLASSIFICATION RATING.

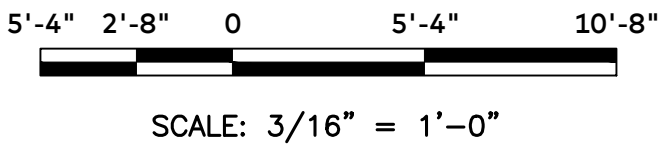



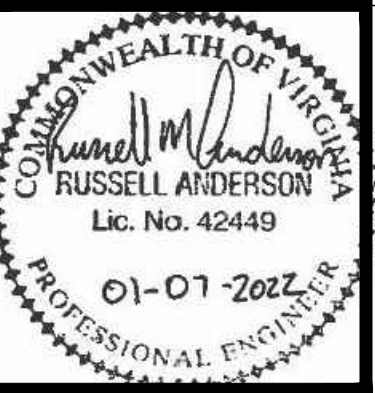

TOWN OF RICHLANDS - 4.0 MGD WWTP  
UPGRADES AND IMPROVEMENTS

POWER PLAN - SECONDARY CLARIFIERS

Purpose of Document Issue  
ISSUED FOR 60% REVIEW  
ISSUED FOR BIDS

Date  
10-21-20  
01-07-22



Designed JBC  
Drawn JBC,TKR,TLP  
Checked RMA  
Date 1/07/2022

Project No.  
14249-00



Sheet No.

E204

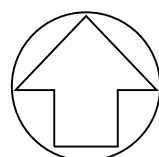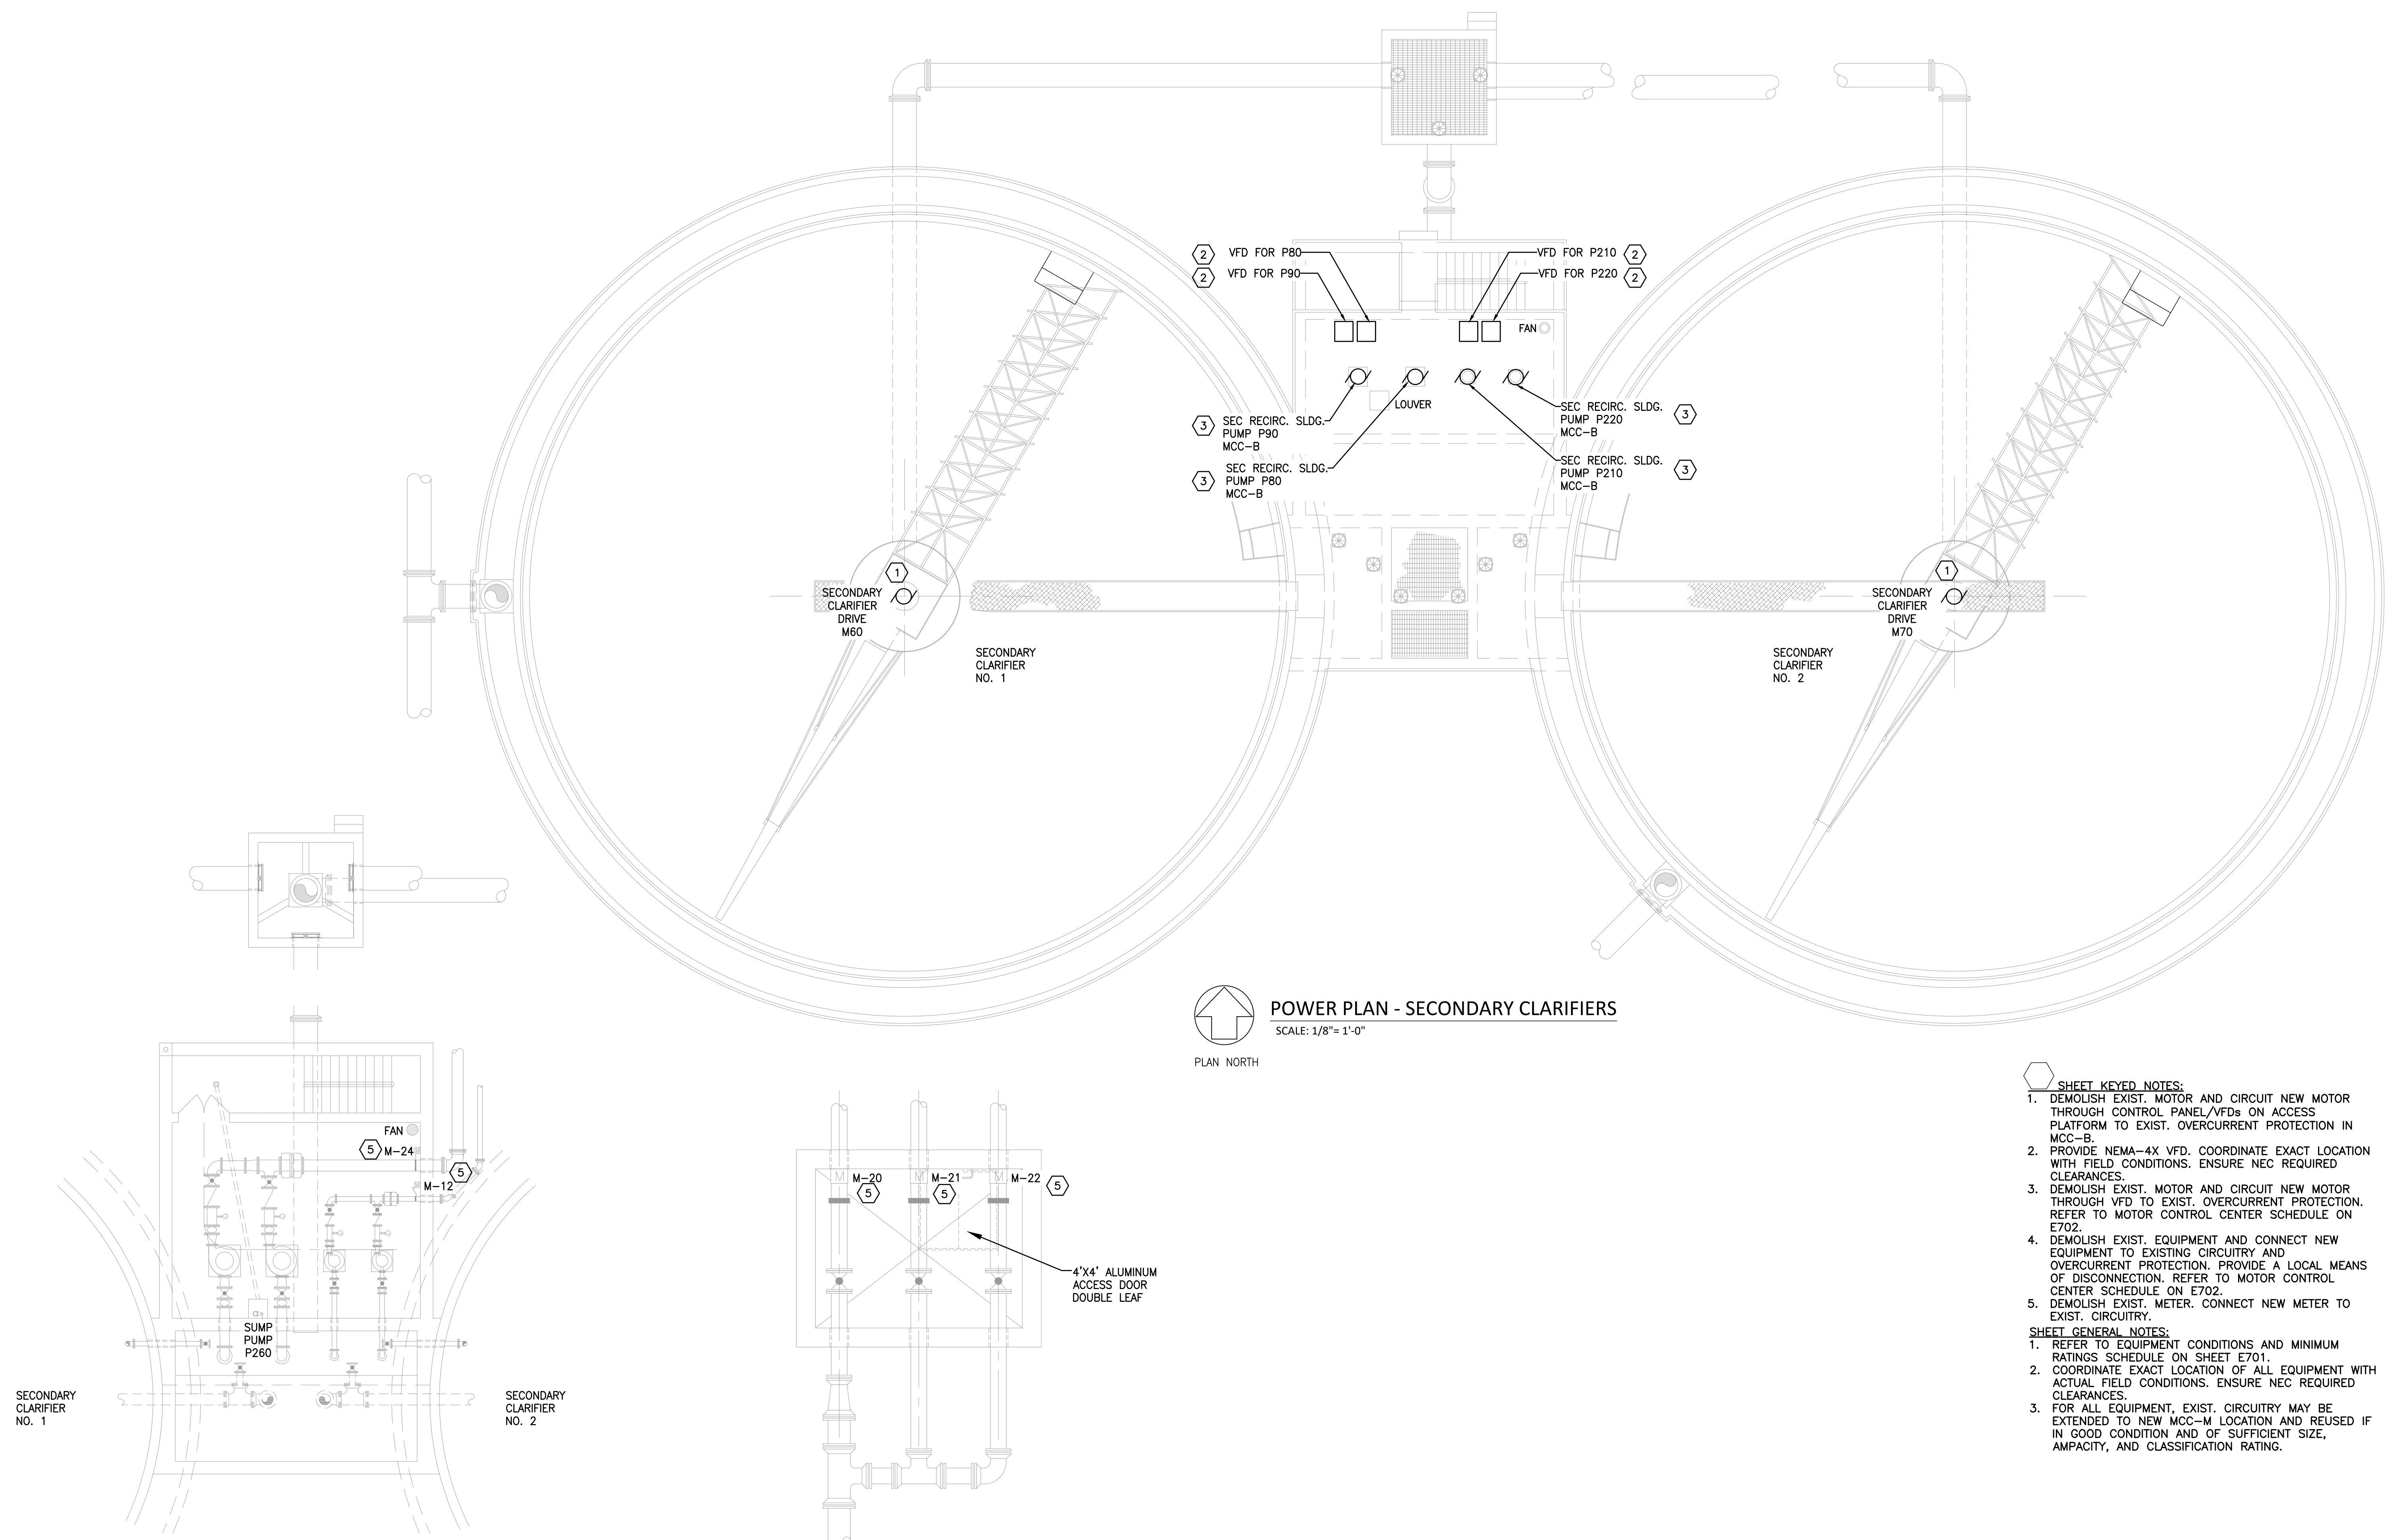


POWER PLAN - SECONDARY CLARIFIERS  
SCALE: 1/8"= 1'-0"

PLAN NORTH




- SHEET KEYED NOTES:**
- DEMOLISH EXIST. MOTOR AND CIRCUIT NEW MOTOR THROUGH CONTROL PANEL/VFDs ON ACCESS PLATFORM TO EXIST. OVERCURRENT PROTECTION IN MCC-B.
  - PROVIDE NEMA-4X VFD. COORDINATE EXACT LOCATION WITH FIELD CONDITIONS. ENSURE NEC REQUIRED CLEARANCES.
  - DEMOLISH EXIST. MOTOR AND CIRCUIT NEW MOTOR THROUGH VFD TO EXIST. OVERCURRENT PROTECTION. REFER TO MOTOR CONTROL CENTER SCHEDULE ON E702.
  - DEMOLISH EXIST. EQUIPMENT AND CONNECT NEW EQUIPMENT TO EXISTING CIRCUITRY AND OVERCURRENT PROTECTION. PROVIDE A LOCAL MEANS OF DISCONNECTION. REFER TO MOTOR CONTROL CENTER SCHEDULE ON E702.
  - DEMOLISH EXIST. METER. CONNECT NEW METER TO EXIST. CIRCUITRY.
- SHEET GENERAL NOTES:**
- REFER TO EQUIPMENT CONDITIONS AND MINIMUM RATINGS SCHEDULE ON SHEET E701.
  - COORDINATE EXACT LOCATION OF ALL EQUIPMENT WITH ACTUAL FIELD CONDITIONS. ENSURE NEC REQUIRED CLEARANCES.
  - FOR ALL EQUIPMENT, EXIST. CIRCUITRY MAY BE EXTENDED TO NEW MCC-M LOCATION AND REUSED IF IN GOOD CONDITION AND OF SUFFICIENT SIZE, AMPACITY, AND CLASSIFICATION RATING.

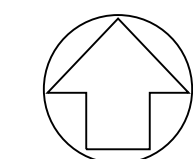


POWER PLAN - SECONDARY CLARIFIERS AT PUMP LEVEL  
SCALE: 1/8"= 1'-0"

PLAN NORTH


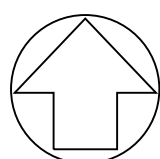


POWER PLAN - SLUDGE SPLITTER AND METER BOX  
SCALE: 1/4"= 1'-0"

PLAN NORTH

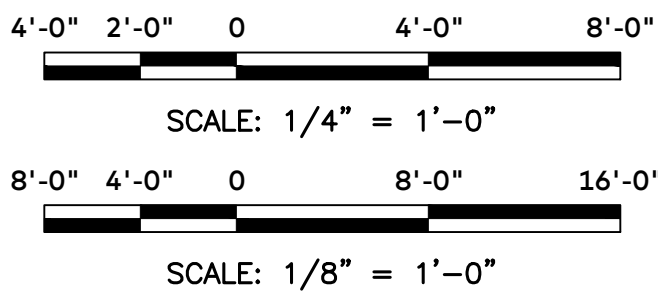




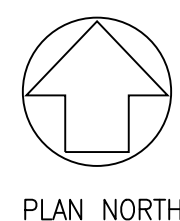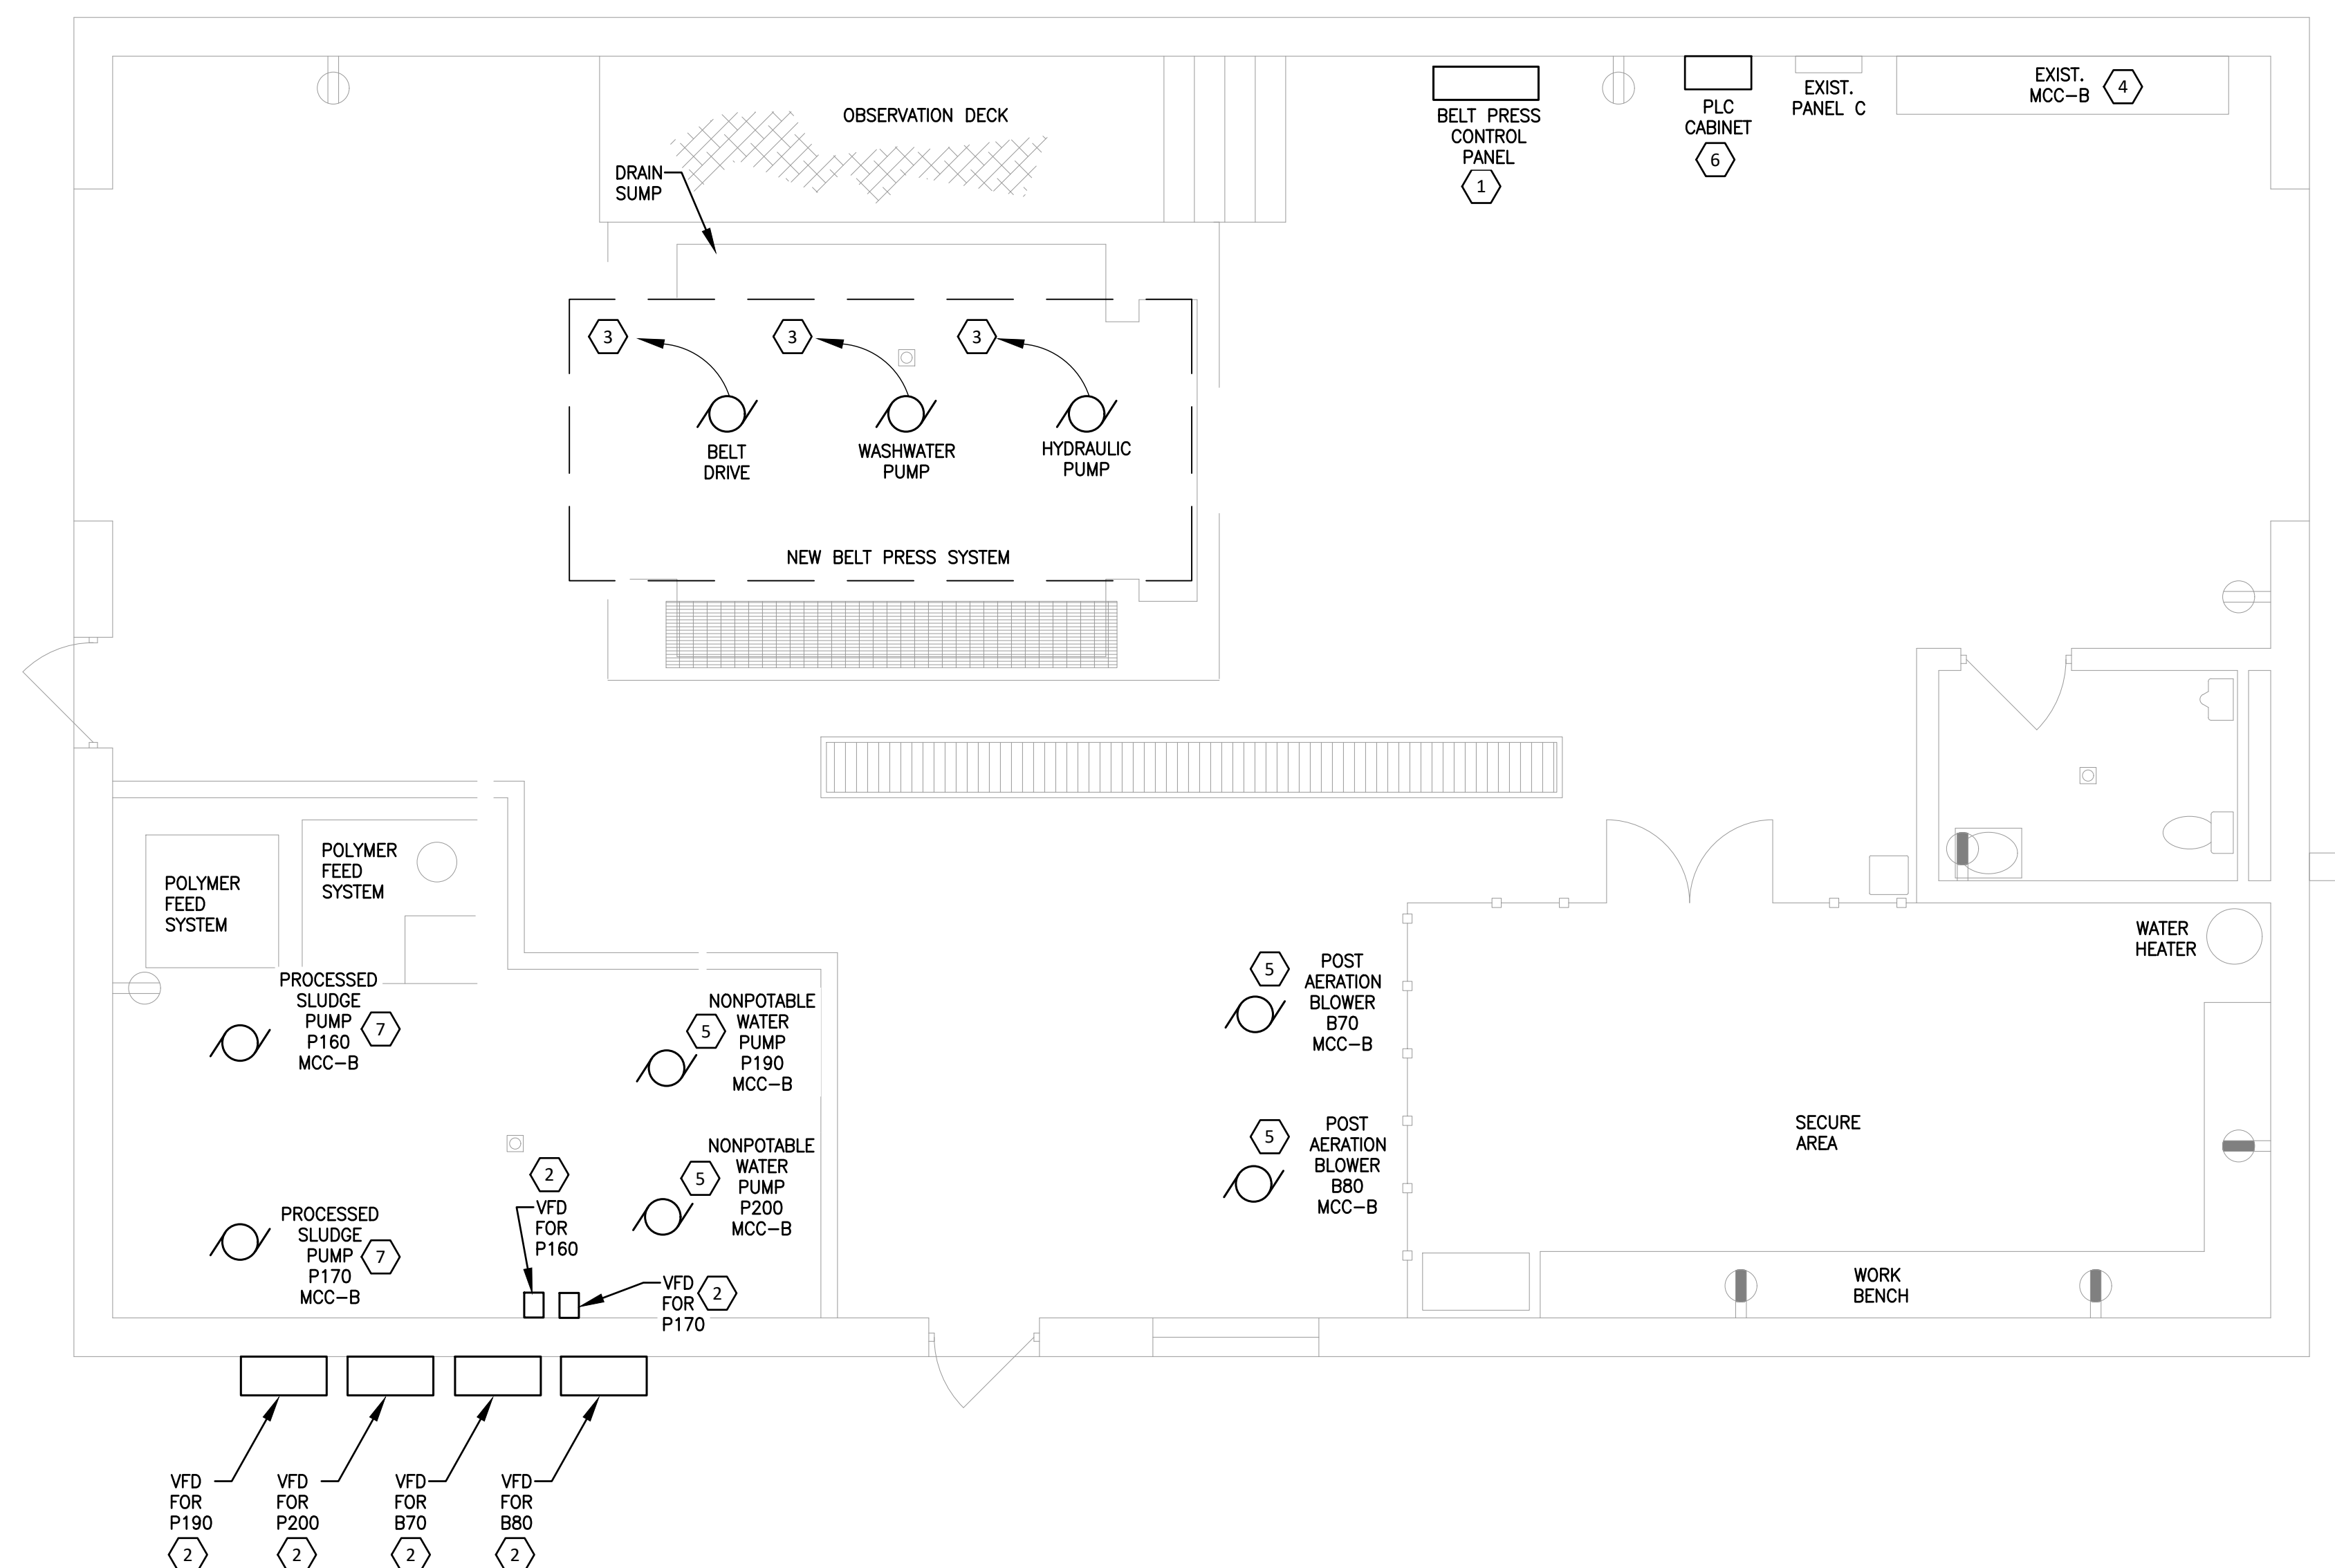

POWER PLAN - SHOP BUILDING  
SCALE: 1/4" = 1'-0"

- SHEET KEYED NOTES:**
1. NEW BELT PRESS CONTROL PANEL. DEMOLISH EXIST. CONTROL PANEL AND CONNECT NEW EQUIPMENT TO EXISTING CIRCUITRY AND OVERCURRENT PROTECTION.
  2. PROVIDE NEMA-3R VFD. COORDINATE EXACT LOCATION WITH FIELD CONDITIONS. ENSURE NEC REQUIRED CLEARANCES.
  3. FED FROM BELT PRESS CONTROL PANEL (B.P.C.P). CONNECT WITH 3#12 CU, 1#12 CU GND, IN 1-1/2" C.
  4. PROVIDE NEW 480V 3-PH. 2HP MOTOR STARTER FOR NEW BELT PRESS CONVEYOR MOTOR IN MCCB-24. EXIST. CONVEYOR MOTOR TO BE DEMOLISHED. MAINTAIN EXIST. CIRCUITRY FOR NEW MOTOR CONNECTION. PROVIDE AUXILIARY CONDUCTORS IN 3/4" CONDUIT TO B.P.C.P FOR MOTOR CONTROL.
  5. DEMOLISH EXIST. MOTOR AND CIRCUIT NEW MOTOR THROUGH VFD TO EXIST. OVERCURRENT PROTECTION.
  6. NEW PLC CABINET WITH HMI CONTROLS EXTEND EXIST. FIBER AND COPPER CONDUCTORS TO LOCATION INDICATED. REFER TO SHEET 1101 FOR CONTROL DIAGRAMS AND LAYOUT FOR MORE INFORMATION.
  7. DEMOLISH EXIST. MOTOR AND CIRCUIT NEW MOTOR THROUGH VFD TO NEW OVERCURRENT PROTECTION. SEE MOTOR CONTROL CENTER SCHEDULE ON SHEET E702 FOR OVERCURRENT AND WIRE SIZES.

- SHEET GENERAL NOTES:**
1. REFER TO EQUIPMENT CONDITIONS AND MINIMUM RATING SCHEDULE ON SHEET E701.
  2. COORDINATE EXACT LOCATION OF ALL EQUIPMENT WITH ACTUAL FIELD CONDITIONS. ENSURE NEC REQUIRED CLEARANCES.

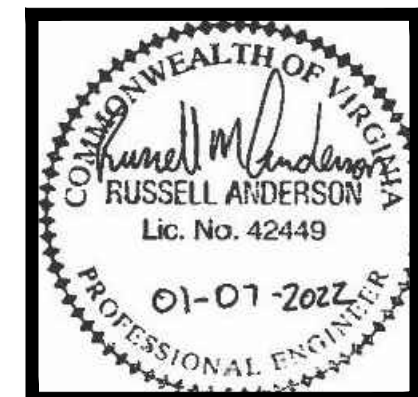

TOWN OF RICHLANDS - 4.0 MGD WWTP  
UPGRADES AND IMPROVEMENTS

POWER PLAN - SHOP BUILDING

Purpose of Document Issue		Issued For 60% Review		Issued For Bids	
No.	Date	No.	Date	No.	Date
	10-21-20		01-07-22		


Designed	JBC
Drawn	JBC,TKR,TLP
Checked	RMA
Date	1/07/2022

Project No.	14249-00
-------------	----------




Sheet No.

E210

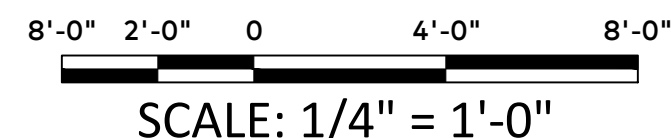



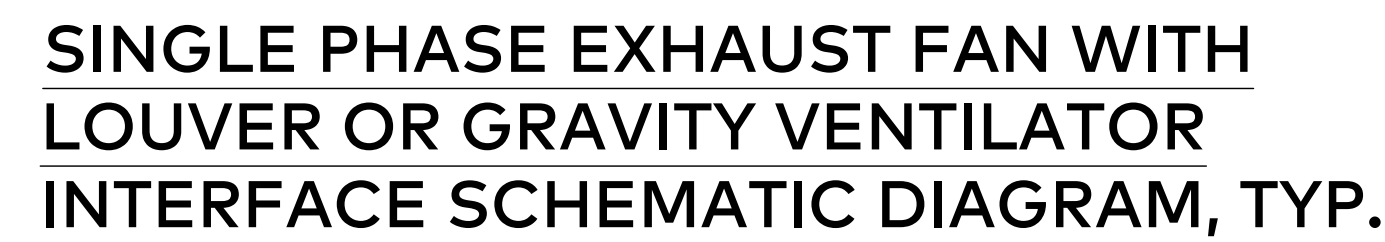

NOTES:

1. EF-3 (120V 1-PHASE) INTERLOCKED WITH L-1 (120V)
2. EF-4 (120V 1-PHASE) INTERLOCKED WITH GV-5 (120V)
3. EF-10, 16, 17 (120V 1-PHASE) INTERLOCKED WITH GV-2
4. EF-11 (120V 1-PHASE) INTERLOCKED WITH GV-1 (120V)
5. EF-12 (120V 1-PHASE) INTERLOCKED WITH GV-3 (120V)



## PULL BOX INSTALLATION DETAIL

### SERVICE GROUND CONNECTION DETAIL


## HOUSEKEEPING PAD DETAIL

### TYPICAL NON-SHELTER EQUIPMENT MOUNTING DETAIL

## TYPICAL GROUND CONNECTION

# E501



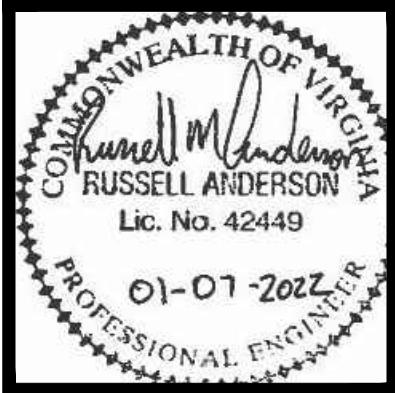

TOWN OF RICHLANDS - 4.0 MGD WWTP  
UPGRADES AND IMPROVEMENTS

EXISTING ELECTRICAL ONE-LINE  
DIAGRAM

Purpose of Document Issue	ISSUED FOR 60% REVIEW	
	ISSUED FOR BIDS	
No.		
Date	10-21-20	01-07-22

Designed	JBC
Drawn	JBC,TKR,TLP
Checked	RMA
Date	1/07/2022


Project No.  
14249-00



Sheet No.  
E601

LEGEND:	
EXISTING TO REMAIN	_____
NEW	_____

- SHEET KEYED NOTES:**
- DEMOLISH EXISTING MCC-M, 25KVA TRANSFORMER, AND PANEL N. PROVIDE NEW MCC-M, 25KVA TRANSFORMER, AND PANEL N LOCATED OUTSIDE PRETREATMENT BUILDING. REFER TO POWER PLAN E202.
  - VERIFY CONDITION OF EXISTING SUPPLEMENTARY GROUND SYSTEM INCLUDING GROUND RODS, BONDS TO ANY METALLIC WATER PIPES, CONCRETE REINFORCING, ETC. AND PROVIDE NEW GEC/GROUNDING IF COMPONENTS ARE NOT IN GOOD CONDITION OR DO NOT MEET NEC REQUIREMENTS. EXTEND GEC IF NECESSARY. PROVIDE BOND TO NEW METAL BUILDING STRUCTURE. SUPPLEMENTARY GROUND SYSTEM SHALL NOT BE BONDED TO NEUTRAL.
  - EXISTING UNDERGROUND FEEDERS TO REMAIN. DISCONNECT FROM EQUIPMENT TO BE DEMOLISHED, AND RECONNECT TO NEW BUILDING SERVICE DISCONNECT. EXTED CONDUCTORS AND CONDUIT IF NECESSARY.

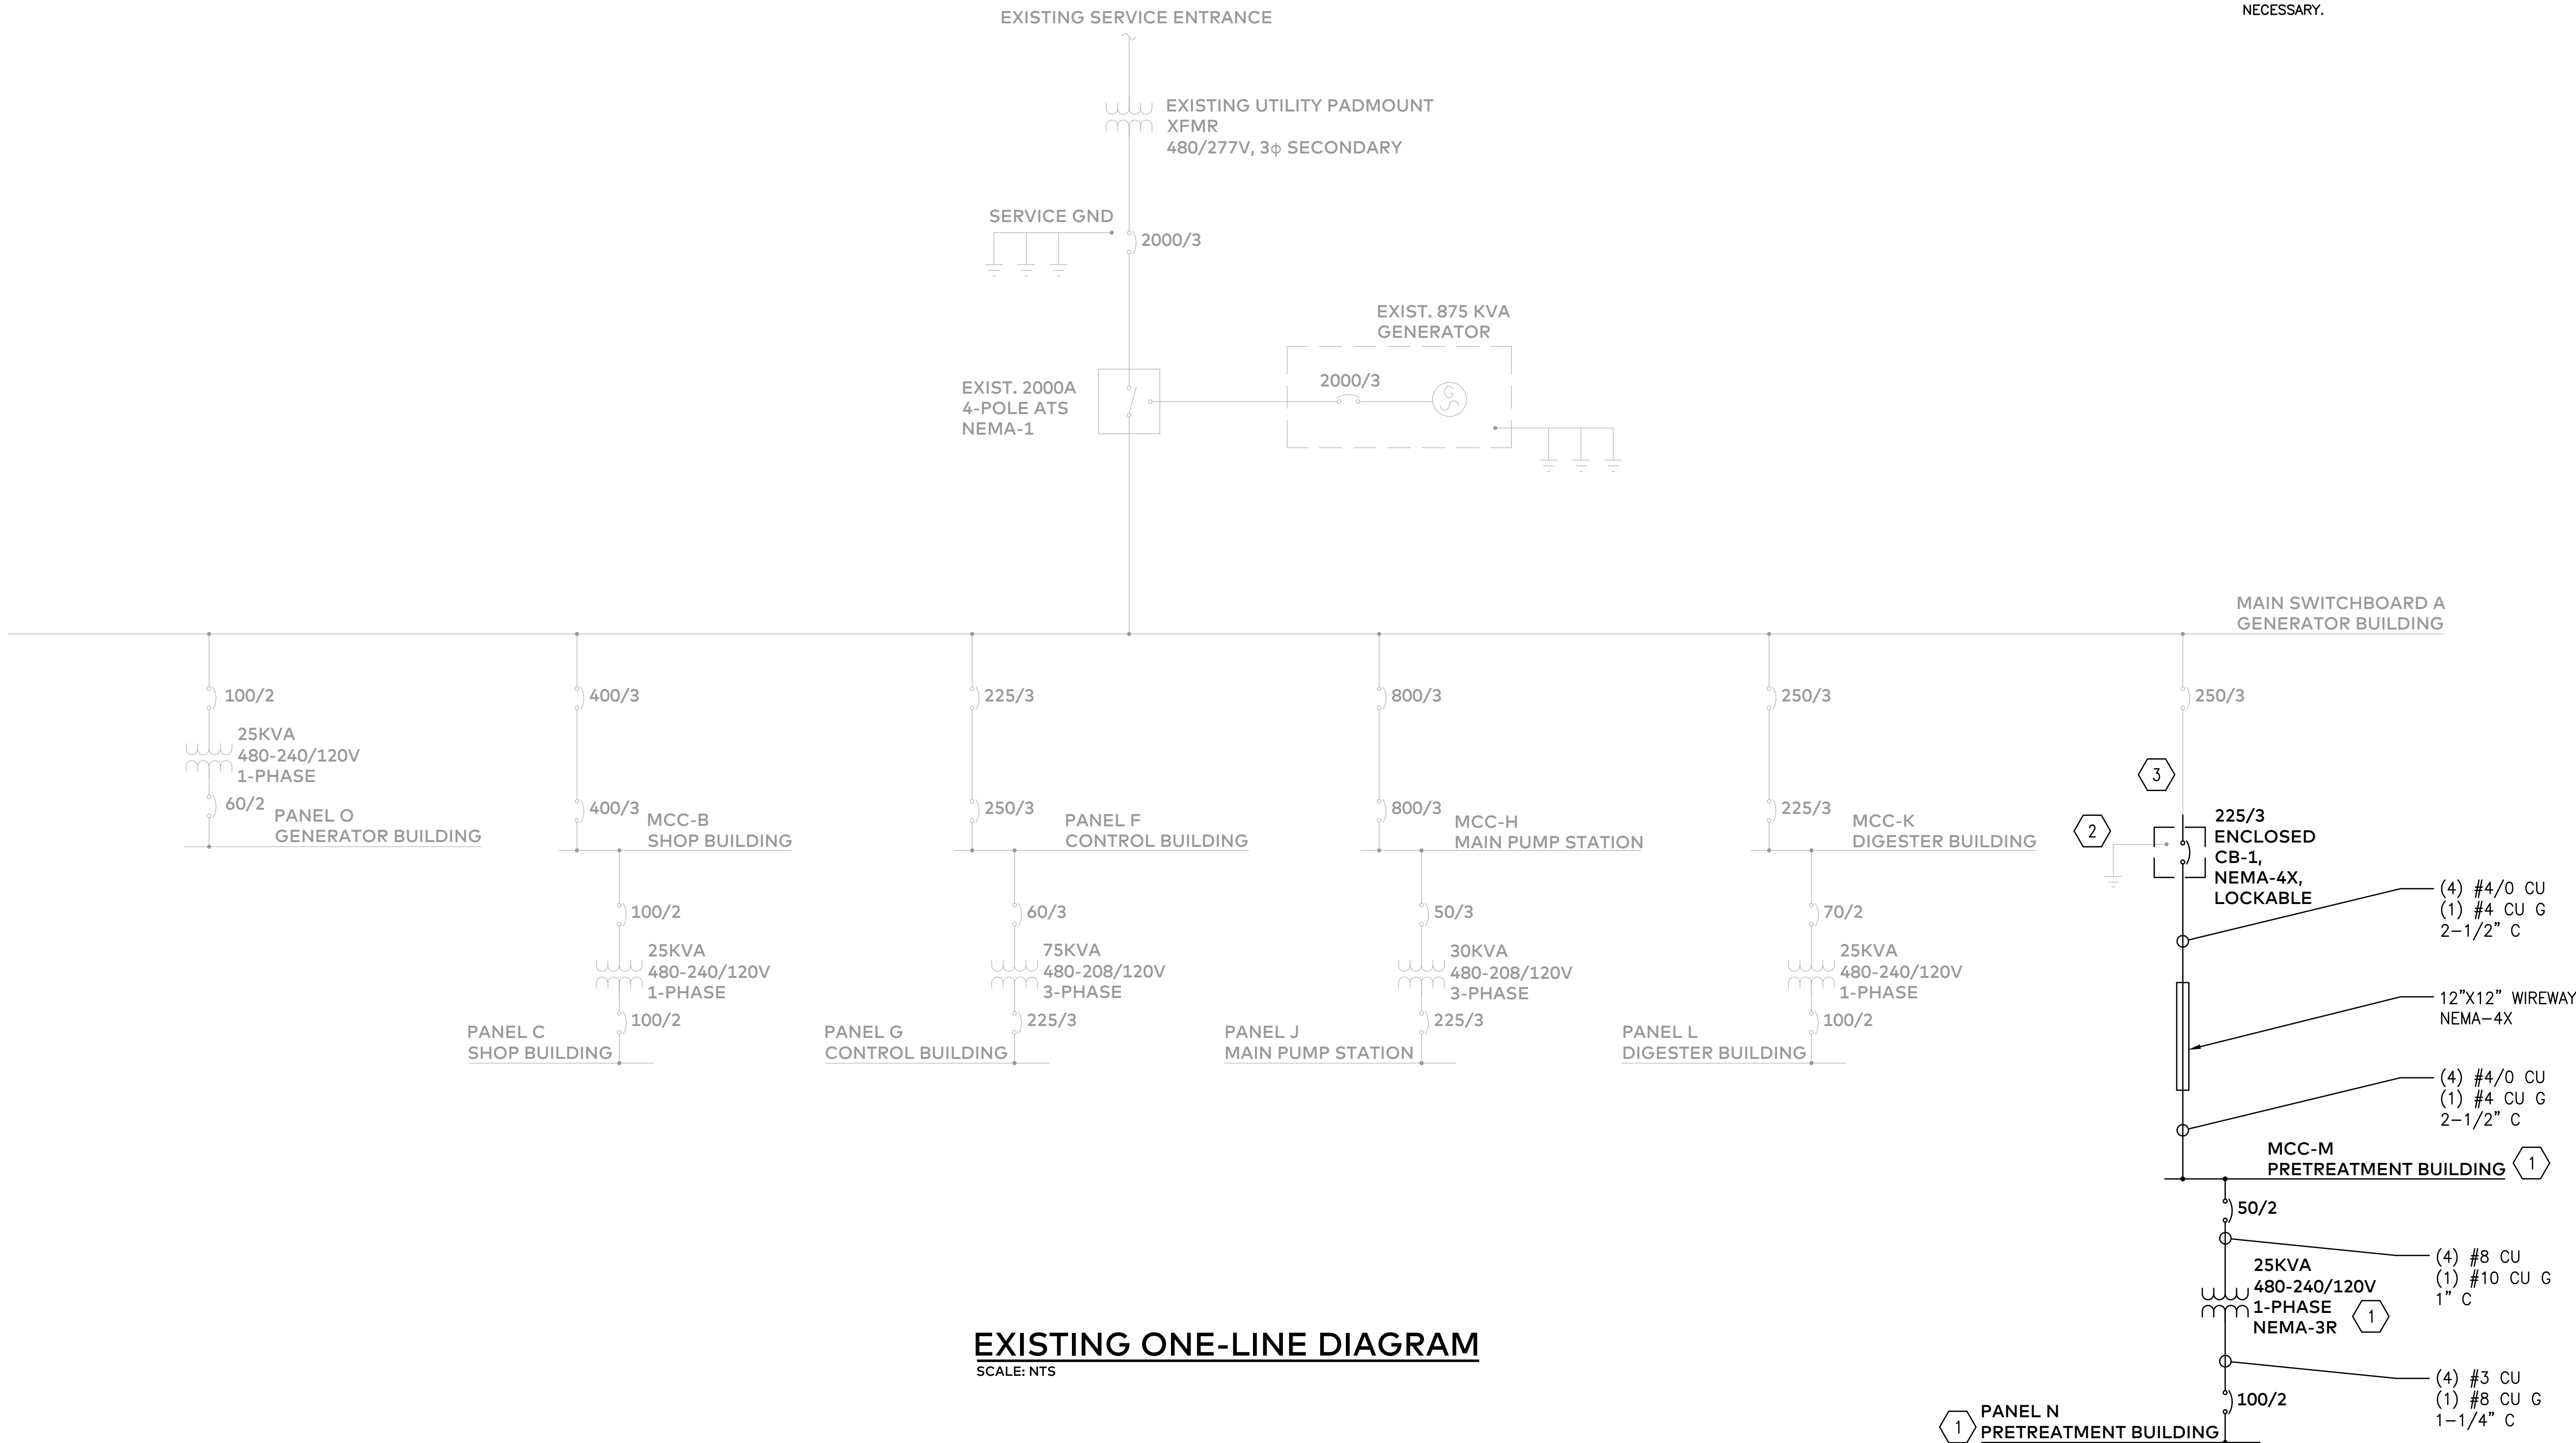

EXISTING ONE-LINE DIAGRAM  
SCALE: NTS




EQUIPMENT CONDITIONS AND MINIMUM RATINGS			
BUILDING	SPACE	EQUIPMENT CONDITIONS	MINIMUM RATING REQUIRED
PRETREATMENT BUILDING	ALL INDOOR SPACES (EXCEPT WHERE OTHERWISE INDICATED)	HOSE DOWN, CORROSIVE	NEMA-4X
	OUTDOOR LOCATIONS	WEATHERPROOF	NEMA-3R
EXIST. MAIN PUMP STATION	ALL INDOOR SPACES (EXCEPT WHERE OTHERWISE INDICATED)	DRY	NEMA-1
	OVERHEAD	COMBUSTIBLE GASSES	CLASS 1 DIVISION 1
	CHEMICAL STORAGE ROOM	HOSE DOWN, CORROSIVE	NEMA-4X
	WETWELL	HOSE DOWN	NEMA-4X
		COMBUSTIBLE GASSES	CLASS 1 DIVISION 1
EXIST. AERATION BASIN	OUTDOOR LOCATIONS	WEATHERPROOF	NEMA-3R
EXIST. PRIMARY CLARIFIER	OUTDOOR LOCATIONS	WEATHERPROOF	NEMA-3R
	VALVE VAULT	HOSE DOWN	NEMA-4X
EXIST. SECONDARY CLARIFIER	OUTDOOR LOCATIONS	WEATHERPROOF	NEMA-3R
	VALVE VAULT	HOSE DOWN	NEMA-4X
EXIST. SHOP BUILDING	ALL INDOOR SPACES (EXCEPT WHERE OTHERWISE INDICATED)	DRY	NEMA-1
	OUTDOOR LOCATIONS	WEATHERPROOF	NEMA-3R
	WITHIN 10' FROM BELT PRESS OR LIQUID CARRYING PROCESS EQUIPMENT OR PIPING	HOSE DOWN	NEMA-4X
EXIST. SLUDGE DRYING BEDS	ALL INDOOR SPACES (EXCEPT WHERE OTHERWISE INDICATED)	HOSE DOWN	NEMA-4X
EXIST. GRAVITY THICKENER	OUTDOOR LOCATIONS	WEATHERPROOF	NEMA-3R
EXIST. ANAEROBIC DIGESTER BUILDING	ALL INDOOR SPACES (EXCEPT WHERE OTHERWISE INDICATED)	DRY	NEMA-1
	HEATER ROOM	COMBUSTIBLE GASSES	CLASS 1 DIVISION 2
	MAIN DIGESTER ROOM/ BASEMENT	COMBUSTIBLE GASSES	CLASS 1 DIVISION 2
EXIST. UV TREATMENT	ALL SPACES	HOSE DOWN	NEMA-4X
EXIST. RAVEN-DORAN PUMP STATION	VALVE VAULT	HOSE DOWN	NEMA-4X
	WET WELLS	COMBUSTIBLE GASSES	CLASS 1 DIVISION 1
	ALL INDOOR SPACES (EXCEPT WHERE OTHERWISE INDICATED)	DRY	NEMA-1
EXIST. CONTROL BUILDING	ALL INDOOR SPACES (EXCEPT WHERE OTHERWISE INDICATED)	DRY	NEMA-1
SEPTAGE RECEIVING STATION	OUTDOOR LOCATIONS	HOSE DOWN	NEMA-4X
NOTES: 1. EQUIPMENT CONDITIONS AND MINIMUM RATING INDICATE THE MINIMUM STANDARD OF CONSTRUCTION REQUIRED FOR THE INDICATED SPACE. ALL ELECTRICAL EQUIPMENT INCLUDING SWITCHES, CONDUIT, FITTINGS, ENCLOSURES, FIXTURES, ETC. SHALL BE LISTED FOR USE IN THESE CONDITIONS AND MEET OR EXCEED THIS RATING.			

DEWATERING BUILDING												EX. PANEL C																													
VOLTAGE: 240 /120						PHASE: 1						BUS						MLO						X						SURFACE MOUNTED						NEMA ENCL.:					
						WIRE: 3						AMPS: 100						X						100 MCB						FLUSH MOUNTED						AIC RATING: NOTE 2					
LOAD DESCRIPTION		CONNECTED LOAD (KVA)				WIRE		CIRCUIT BREAKER								WIRE		CONNECTED LOAD (KVA)				LOAD																			
		A	B	*	SIZE	TRIP	P	NO	NO	P	TRIP	SIZE	*	A	B	DESCRIPTION																									
SHOP BUILDING LIGHTS		----	----	E	12	20	1	1	2	1	20	12	E	----	----	SHOP BUILDING LIGHTS																									
SHOP BUILDING LIGHTS		----	----	E	12	20	1	3	4	1	20	12	E	----	----	METER M-15																									
SHOP BUILDING OUTLETS		----	----	E	12	20	1	5	6	1	20	12	E	----	----	WORKBENCH OUTLET																									
WORKBENCH OUTLET		----	----	E	12	20	1	7	8	1	20	12	E	----	----	WORKBENCH OUTLET																									
BATHROOM LIGHT & FAN		----	----	E	12	20	1	9	10	1	20	12	E	----	----	POLE LIGHT																									
EFFLUENT FLOW METER		----	----	E	12	20	1	11	12	1	20	12	E	----	----	POLE LIGHT																									
SAMPLER		----	----	E	12	20	1	13	14	1	20	12	E	----	----	SEC. CLARIFIER FAN																									
SHOP BLDG. FAN AND LOU		----	----	E	12	20	1	15	16	1	20	12	I	----	1.80	UV SYSTEM CONTROL (SCC)																									
SPARE		----	----	E	12	20	1	17	18	1	20	12	E	----	----	SEC OUTLETS																									
SPARE		----	----	E	12	20	1	19	20	1	20	12	E	----	----	240V OUTSIDE OUTLET																									
SEC. METERS		----	----	E	12	20	1	21	22	1	20	12	E	----	----	1 O RACK																									
HOT WATER HEATER		----	----	E	12	40	1	23	24	1	20	12	E	----	----	EFF CHANNEL OUTLET																									
AIR COMP		----	----	E	12	30	2	25	26	1	20	E	----	----	DRYING BED REC.																										
								27	28	1	20	E	----	----	DUSK/DOWN OUTLET																										
								29	30	1	20	E	----	----																											
LEFT SUB-TOTAL																TOTAL PANEL LOAD																									
RIGHT SUB-TOTAL		1.80														CONNECTED				DEMAND																					
PER PHASE TOTAL		1.80														KVA				1.8		2																			
PANEL TOTAL		1.80														AMPS				7.5		8																			
* NOTES: (E = EXST TO REMAIN UNO, G = GF, L = LOCKABLE, S = SHUNT TRIP)																																									
1. PROVIDE NEW OVERCURRENT PROTECTION, CONDUCTORS, AND CONDUIT AS INDICATED.																																									
2. ALL NEW DEVICES SHALL MEET OR EXCEED AIC RATING OF EXISTING PANEL.																																									




# E702



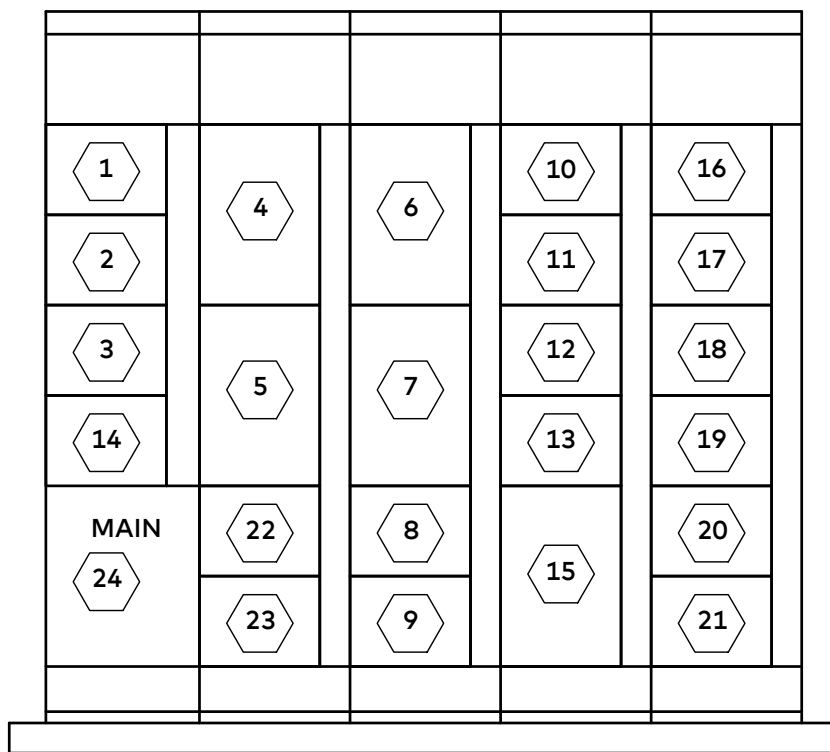

MOTOR CONTROL CENTER  
"MCC-M"  
NTS

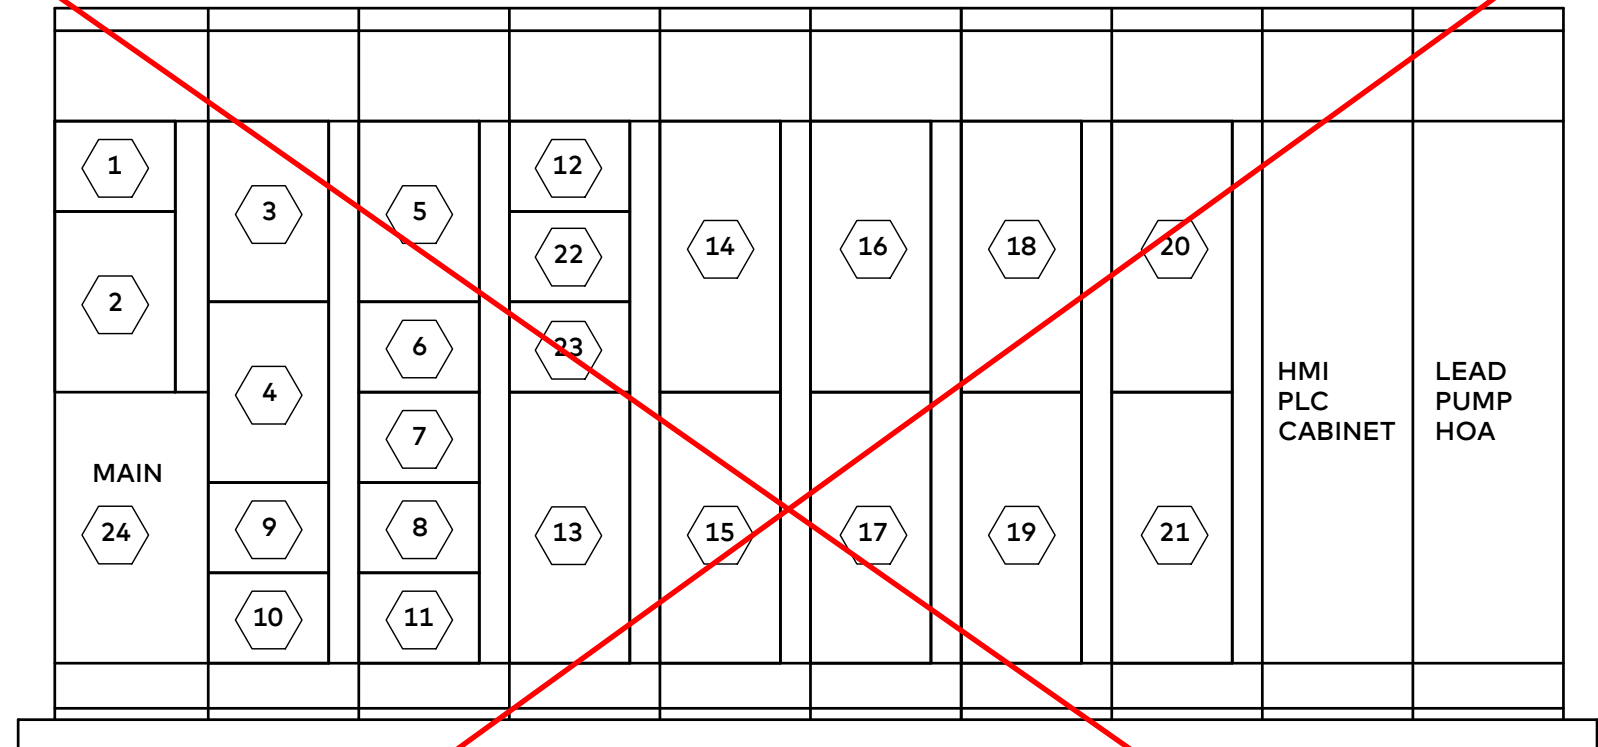

EXIST. MOTOR CONTROL CENTER  
"MCC-H"  
NTS

MOTOR CONTROL CENTER SCHEDULE											LOCATION: PRETREATMENT BUILDING		
MCC-M - 480/277 VOLT, 3 PHASE, 4 WIRE, 600 AMP BUS, NEMA 3R													
UNIT NO.	NAMEPLATE	LOAD HP OR KVA	FULL LOAD AMPS	CIRCUIT BREAKER		CONDUCTORS				CONDUIT		STARTER TYPE	REMARKS
				NO. POLES	TRIP AMPS	POWER		GROUND		NO.	SIZE		
						NO.	SIZE	NO.	SIZE				
1	GRIT ROOM TRANSFORMER	15 KVA	31.3	2	50	3	#8	1	#10	1	1-1/4"	-	NOTE 5
2	UNIT HEATER GRIT ROOM	20 KVA	24.1	3	40	4	#8	1	#10	1	1-1/4"	-	NOTE 3
3	UNIT HEATER GRIT ROOM	20 KVA	24.1	3	40	4	#8	1	#10	1	1-1/4"	-	NOTE 3
4	GRIT CHAMBER BLOWER (B-10)	10 HP	14	3	50	4	#8	1	#10	1	1-1/4"	VFD	NOTE 2
5	GRIT CHAMBER BLOWER (B-20)	10 HP	14	3	50	4	#8	1	#10	1	1-1/4"	VFD	NOTE 2
6	GRIT PUMP (P-40)	10 HP	14	3	50	4	#8	1	#10	1	1-1/4"	VFD	NOTE 2
7	GRIT PUMP (P-50)	10 HP	14	3	50	4	#8	1	#10	1	1-1/4"	VFD	NOTE 2
8	GRIT SYSTEM	1.5 HP	3	3	20	4	#12	1	#12	1	1-1/4"	-	NOTE 4
9	CONVEYOR BELT	3 HP	4.8	3	20	4	#12	1	#12	1	1-1/4"	HOA	NOTE 5
10	PRIMARY CLARIFIER #1 (M-20)	1 HP	1.8	3	20	4	#12	1	#12	1	1-1/4"	VFD	NOTE 8
11	PRIMARY CLARIFIER #2 (M-30)	1 HP	1.8	3	20	4	#12	1	#12	1	1-1/4"	VFD	NOTE 8
12	PRIMARY SLUDGE PUMP #1 (P-60)	3 HP	4.8	3	20	4	#12	1	#12	1	1-1/4"	VFD	NOTE 2
13	PRIMARY SLUDGE PUMP #2 (P-70)	3 HP	4.8	3	20	4	#12	1	#12	1	1-1/4"	VFD	NOTE 2
14	UNIT HEATER PUMP ROOM	3 KVA	3.6	3	20	4	#12	1	#12	1	1-1/4"	HOA	NOTE 3
15	MECHANICAL SCREEN	2 HP	3.4	3	20	4	#12	1	#12	1	1-1/4"	HOA	NOTE 5
16	GRAVITY THICKNER	1 HP	1.8	3	20	4	#12	1	#12	1	1-1/4"	HOA	NOTE 5
17	SUPERNATANT TREATMENT	1 HP	1.8	3	20	4	#12	1	#12	1	1-1/4"	HOA	NOTE 5
18	SUMP PUMP PUMP ROOM (P-250)	0.5 HP	1.1	3	20	4	#12	1	#12	1	1-1/4"	HOA	NOTE 5
19	SPACE	-	-	-	-	-	-	-	-	-	-	-	-
20	SPACE	-	-	-	-	-	-	-	-	-	-	-	-
21	SPACE	-	-	-	-	-	-	-	-	-	-	-	-
22	SPACE	-	-	-	-	-	-	-	-	-	-	-	-
23	SPACE	-	-	-	-	-	-	-	-	-	-	-	-
24	MAIN	-	-	-	-	-	-	-	-	-	-	-	NOTE 6
NOTES:													
1. EXISTING MCC TO BE REPLACED WITH NEW NEMA-3R MCC. SEE SHEET E202 FOR NEW LOCATION ON EXTERIOR OF BUILDING.													
2. CONNECT THROUGH REMOTE LOCATED VFD OR CONTROL PANEL TO EQUIPMENT INDICATED. PROVIDE LED INDICATION LIGHTS ON BUCKET FOR VFD STATUS. REFER TO CONTROL DRAWINGS FOR DETAILS.													
3. EXIST. UNIT HEATER TO BE REPLACED AS INDICATED. PROVIDE CIRCUITRY AND OVERCURRENT PROTECTION AS INDICATED.													
4. CONNECT THROUGH CONTROL PANEL TO EQUIPMENT INDICATED. CONTROL PANEL FURNISHED WITH GRIT SYSTEM.													
5. DISCONNECT AND REMOVE EXISTING CIRCUITRY. CONNECT TO NEW EQUIPMENT AS SHOWN.													
6. VERIFY EXISTING MAIN BREAKER CAPACITY, AND PROVIDE MAIN BREAKER IN NEW MCC OF SIMILAR CAPACITY.													
7. FOR ALL EQUIPMENT, CIRCUITRY SHALL BE ROUTED FROM MCC, UNDERGROUND, AND INTO WIREWAY. WIREWAY MAY BE SHARED FOR MULTIPLE POWER CIRCUITS.													
8. CONNECT THROUGH CONTROL PANEL TO REMOTE VFD SERVING EQUIPMENT INDICATED. CONTROL PANEL LOCATED AT PRIMARY CLARIFIER ACCESS PLATFORM. PROVIDE LED INDICATION LIGHTS ON BUCKET FOR VFD STATUS. REFER TO CONTROL DRAWINGS FOR DETAILS.													

EXIST. MOTOR CONTROL CENTER SCHEDULE											LOCATION: MAIN PUMP STATION		
MCC-H - 480/277 VOLT, 3 PHASE, 4 WIRE, 800 AMP BUS													
UNIT NO.	NAMEPLATE	LOAD HP OR KVA	FULL LOAD AMPS	CIRCUIT BREAKER		CONDUCTORS				CONDUIT		STARTER TYPE	REMARKS
				NO. POLES	TRIP AMPS	POWER		GROUND		NO.	SIZE		
						NO.	SIZE	NO.	SIZE				
1	PUMP STATION TRANSFORMER	30 KVA	35.1	3	50	-	-	-	-	-	-	-	NOTE 1
2	MAIN SEWAGE PUMP (P-10)	60 HP	77	3	110	4	#2	1	#6	1	2"	VFD	NOTE 2
3	MAIN SEWAGE PUMP (P-20)	60 HP	77	3	110	4	#2	1	#6	1	2"	VFD	NOTE 2
4	MAIN SEWAGE PUMP (P-30)	60 HP	77	3	110	4	#2	1	#6	1	2"	VFD	NOTE 2
5	SLUDGE TRANSFER PUMP (P-120)	3 HP	4.8	3	20	4	#12	1	#12	1	1-1/4"	VFD	NOTE 2
6	SLUDGE TRANSFER PUMP (P-130)	3 HP	4.8	3	20	4	#12	1	#12	1	1-1/4"	VFD	NOTE 2
7	SEPTAGE RECEIVING STATION	-	-	-	-	-	-	-	-	-	-	-	NOTE 4
8	PINCH VALVE	1.5 HP	2.6	3	40	-	-	-	-	-	-	-	NOTE 1
9	UNIT HEATER	7.5 KW	9	3	20	4	#12	1	#12	1	1-1/4"	-	NOTE 3
10	UNIT HEATER	7.5 KW	9	3	20	4	#12	1	#12	1	1-1/4"	-	NOTE 3
11	UNIT HEATER	7.5 KW	9	3	20	4	#12	1	#12	1	1-1/4"	-	NOTE 3
12	UNIT HEATER	7.5 KW	9	3	20	4	#12	1	#12	1	1-1/4"	-	NOTE 3
13	AERATOR #1	25 HP	34	3	60	4	#6	1	#10	1	1-1/2"	VFD	NOTE 2
14	AERATOR #2	25 HP	34	3	60	4	#6	1	#10	1	1-1/2"	VFD	NOTE 2
15	AERATOR #3	25 HP	34	3	60	4	#6	1	#10	1	1-1/2"	VFD	NOTE 2
16	AERATOR #4	25 HP	34	3	60	4	#6	1	#10	1	1-1/2"	VFD	NOTE 2
17	AERATOR #5	25 HP	34	3	60	4	#6	1	#10	1	1-1/2"	VFD	NOTE 2
18	AERATOR #6	25 HP	34	3	60	4	#6	1	#10	1	1-1/2"	VFD	NOTE 2
19	AERATOR #7	25 HP	34	3	60	4	#6	1	#10	1	1-1/2"	VFD	NOTE 2
20	AERATOR #8	25 HP	34	3	60	4	#6	1	#10	1	1-1/2"	VFD	NOTE 2
21	AERATOR #9	25 HP	34	3	60	4	#6	1	#10	1	1-1/2"	VFD	NOTE 2
22	FEEDER DUST COLLECTOR	1 HP	1.8	3	20	-	-	-	-	-	-	-	NOTE 1
23	SPACE	-	-	-	-	-	-	-	-	-	-	-	NOTE 1
24	MAIN BREAKER	-	-	3	800	-	-	-	-	-	-	-	NOTE 1

NOTES:


1. EXISTING TO REMAIN, NO NEW WORK.

2. EXISTING STARTER TO BE REMOVED FROM BUCKET BUT OVERCURRENT PROTECTION TO REMAIN. CIRCUIT TO VFD AT REMOTE LOCATION. REFER TO SITE PLAN ON ES-1 AND ENLARGED PLAN ON E205 FOR VFD LOCATION. PROVIDE NEW LED INDICATOR LIGHTS ON BUCKET FOR VFD STATUS. REFER TO CONTROL DRAWINGS FOR DETAILS.

3. EXISTING UNIT HEATER TO BE REPLACED AS INDICATED. CIRCUITRY AND OVERCURRENT PROTECTION TO REMAIN.

4. NEW 480V 3-PHASE SINGLE POINT CONNECTION TO SEPTAGE RECEIVING STATION. PROVIDE AND COORDINATE OVERCURRENT PROTECTION, CONDUCTOR, AND CONDUIT SIZE AND NUMBER WITH EQUIPMENT PROVIDED. REFER TO ES1 FOR LOCATION AND CIVIL SHEET C403 FOR LOCAL WIRING AND HOOKUP REQUIREMENTS, INCLUDING UPTIONAL HEAT TRACE SYSTEM AND VALVES TO PROVIDE A FULLY OPERATIONAL STATION AS DESCRIBED IN THE CIVIL EQUIPMENT SPECIFICATIONS.

5. ALL NEW DEVICES SHALL MEET OR EXCEED THE AIC RATING OF THE EXISTING SWITCHBOARD.

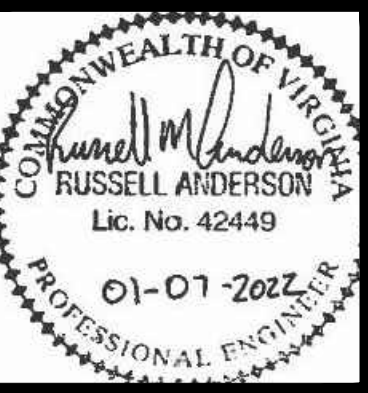

TOWN OF RICHLANDS - 4.0 MGD WWTP  
UPGRADES AND IMPROVEMENTS

ELECTRICAL SCHEDULES

Purpose of Document Issue  
ISSUED FOR 60% REVIEW  
ISSUED FOR BIDS

Date  
10-21-20  
01-07-22

Designed JBC  
Drawn JBC,TKR,TLP  
Checked RMA  
Date 1/07/2022

Project No.  
14249-00




Sheet No.


E703




<u>SINGLE</u> <u>FUNCTION</u>	<u>MULTIPLE</u> <u>FUNCTION</u>
----------------------------------	------------------------------------

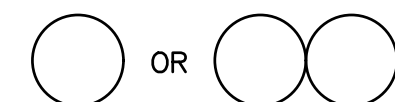


FIELD MOUNTED INSTRUMENT OR DEVICE

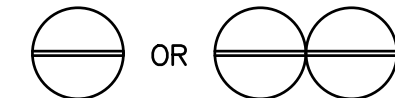


FRONT OF PANEL MOUNTED INSTRUMENT ON LOCAL PANEL

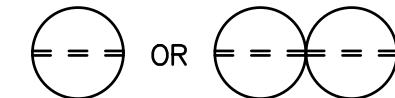


REAR OF PANEL MOUNTED INSTRUMENT ON LOCAL PANEL

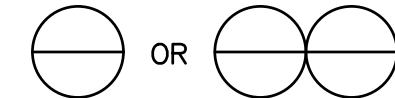

FRONT OF PANEL MOUNTED INSTRUMENT ON MAIN PANEL

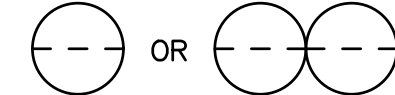

REAR OF PANEL MOUNTED INSTRUMENT ON MAIN PANEL

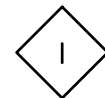


## HARDWIRED INTERLOCK




## CONNECTION TO EXISTING WORK

---

PROCESS ENCLOSURE

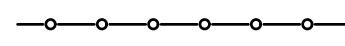


SOFTWARE SIGNAL

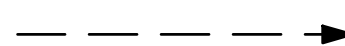

SIGNAL OR CONTROL. ARROWS INDICATE INFORMATION FLOW

LETTER	FIRST LETTER		SUCCEEDING LETTERS		
	MEASURED OR INITIATING VARIABLE	MODIFIER	READOUT OR PASSIVE FUNCTION	OUTPUT FUNCTION	MODIFIER
A	ANALYSIS		ALARM		
B	BURNER		PROGRAMMER	STOP	
C	CONDUCTIVITY (ELECTRICAL)			CONTROL	CLOSED
D	DENSITY (MASS) OR SPECIFIC GRAVITY	DIFFERENTIAL		START	
E	VOLTAGE (EMF)		PRIMARY ELEMENT		
F	FLOW RATE	RATIO (FRACTION)			
G	GAUGING		GLASS		
H	HAND (MANUALLY INITIATED)				HIGH
I	CURRENT (ELECTRICAL)		INDICATE		
J	POWER	SCAN			
K	TIME OR TIME SCHEDULE			CONTROL STATION	
L	LEVEL		LIGHT (PILOT)		LOW
M	MOTOR				MIDDLE OR INTERMEDIATE
N	VIBRATION	IGNITER			
O	OPERATION	OFFSET	ORIFICE (RESTRICTION)		OPEN
P	PRESSURE OR VACUUM		POINT (TEST CONNECTION)		
Q	QUANTITY OR EVENT	INTEGRATE OR TOTALIZE			
R	RADIOACTIVITY		RECORD OR PRINT		
S	SPEED OR FREQUENCY	SAFETY		SWITCH	
T	TEMPERATURE			TRANSMIT	
U	SEE SPEC	TREND	MULTI-FUNCTION	SEE SPEC	MULTI-FUNCTION
V	VISCOSITY			VALVE DAMPER OR LOUVER	
W	WEIGHT, FORCE OR TORQUE		WELL		
X	SPECIAL (SEE SPEC.)		SPECIAL (SEE SPEC.)		STATUS
Y				RELAY OR COMPUTE	
Z	POSITION				DRIVE, ACTUATE OR UNCLASSIFIED FINAL CONTROL ELEMENT

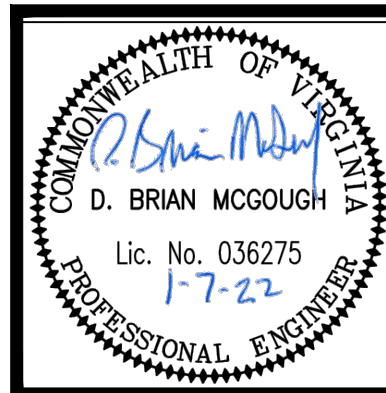


# TOWN OF RICHLANDS - 4.0 MGD WWTP UPGRADES AND IMPROVEMENTS

## **INSTRUMENTATION & CONTROLS SYMBOLS & ABBREVIATIONS**

[illegible]

Designed	DBM
Drawn	ESB
Checked	
Date	JULY 2020

Project No. 14249

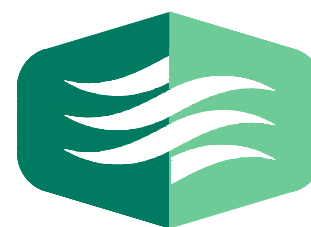

THOMPSON  
& LITTON

Sheet No.

1001



